

SHIP Nº 664
MIDSHIP SECTION

SCALE:- 1/2"=1 FT.

DIMENSIONS.


LENGTH BP:- 145-0"

BREADTH ML:- 27'-0"


DEPTH MLD:- 10'-3"

LLOYDS NUMERALS

$L \div D$	_____	1486.25
$L(B \div D)$	_____	5401.25
D	_____	10.25
L/D	_____	14.15

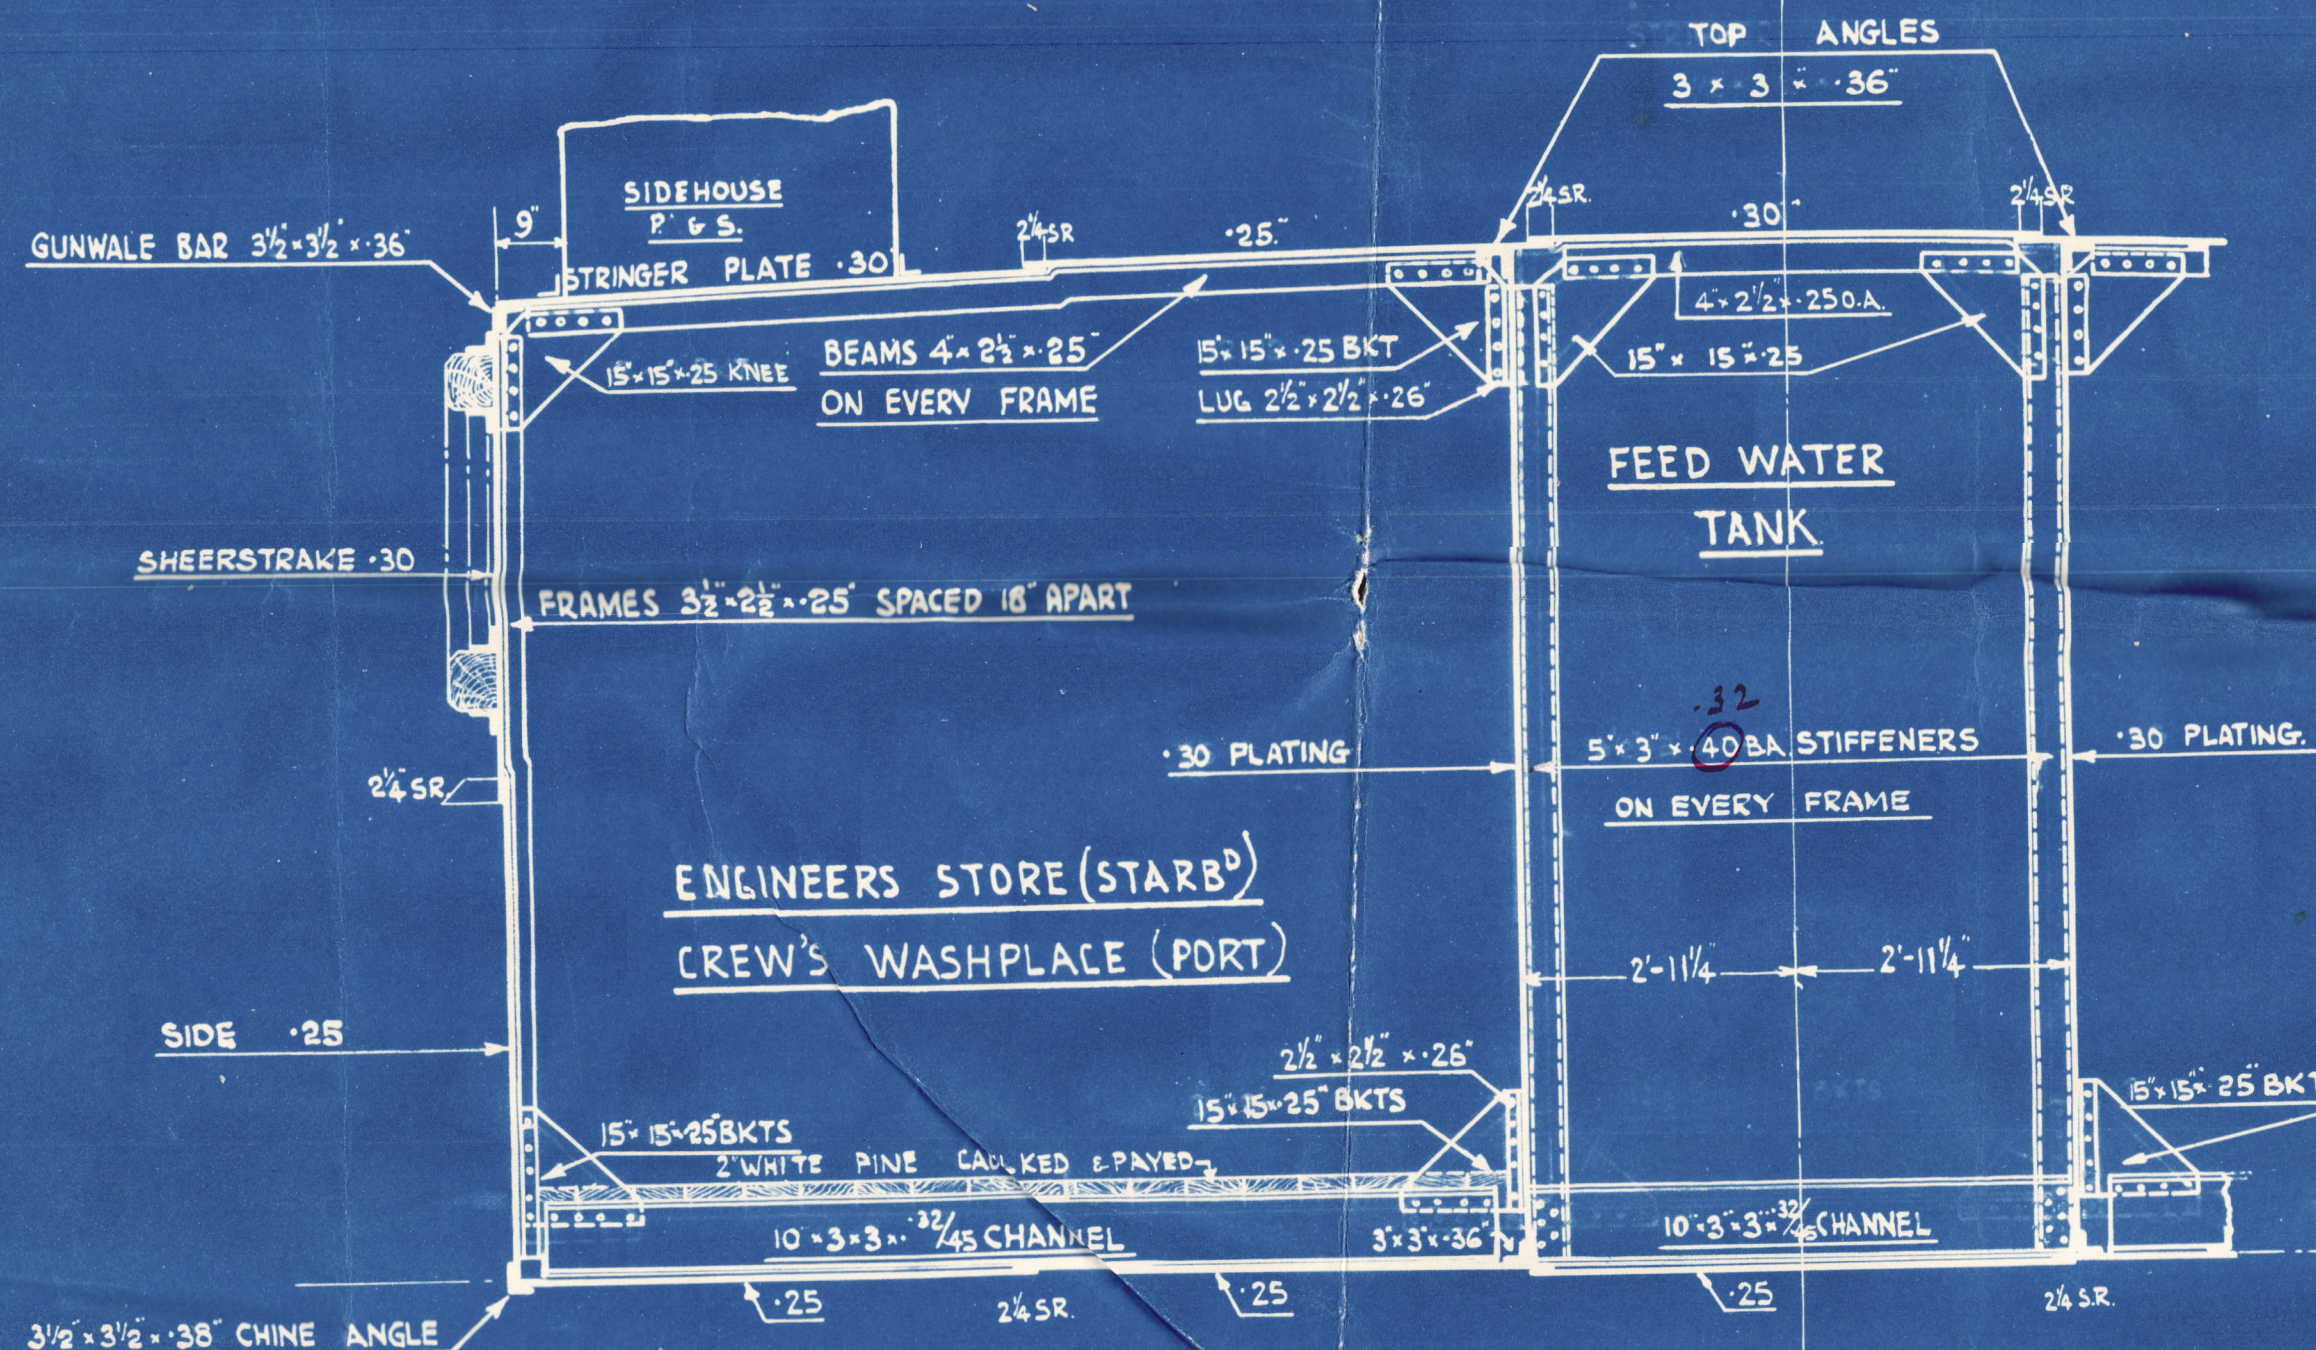


SECTION IN WAY OF FRESH WATER TANK.

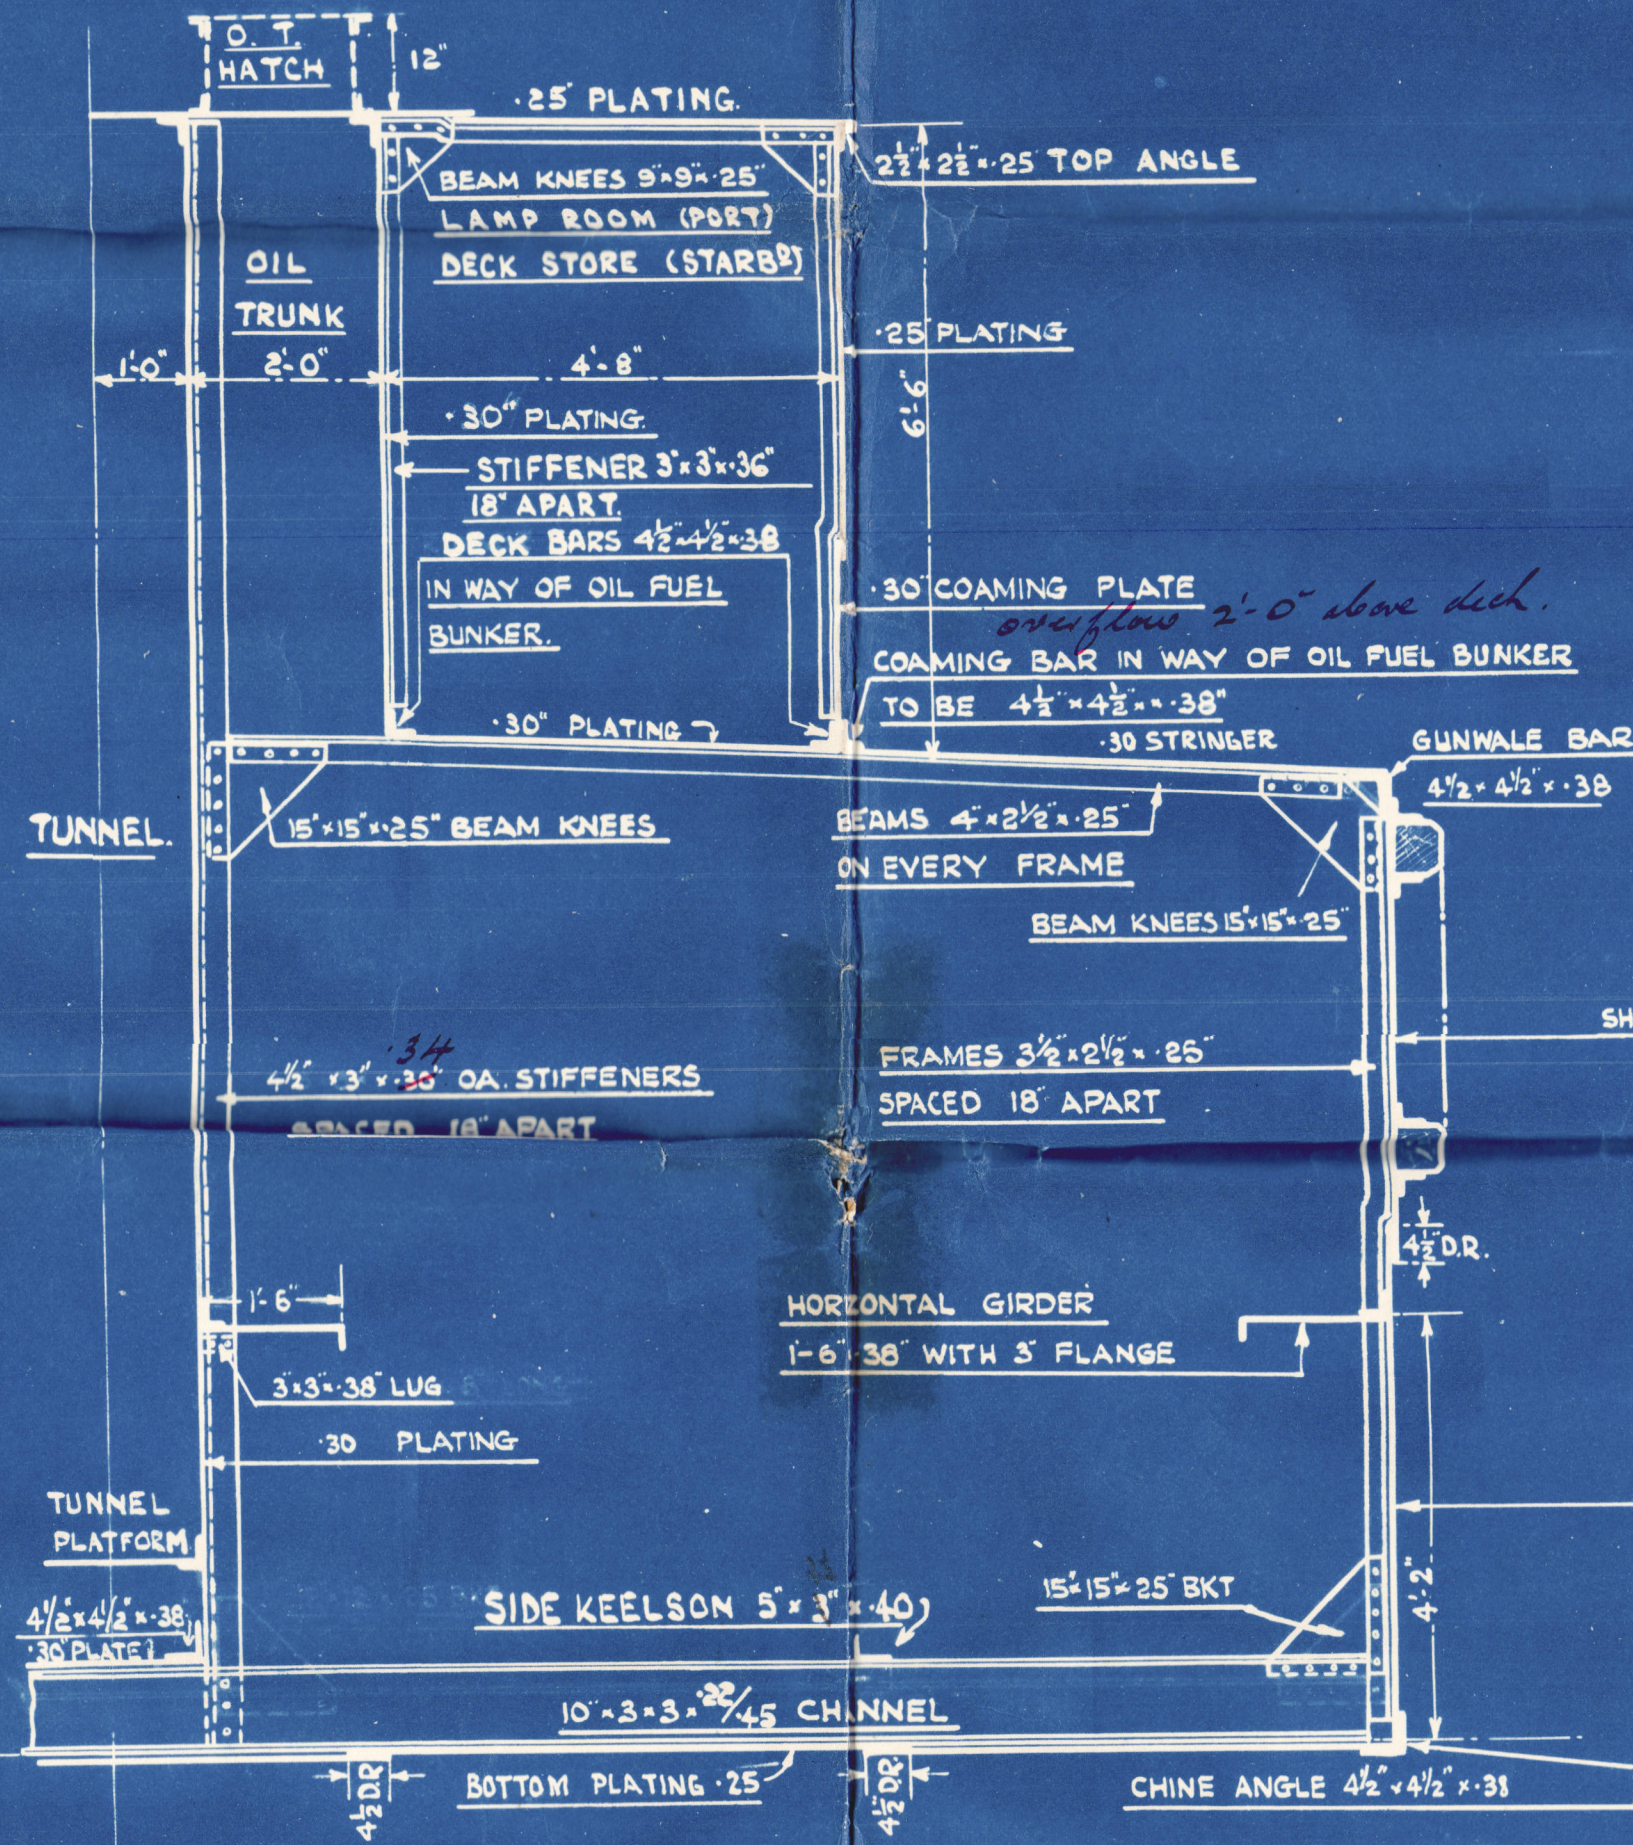


SECTION IN WAY OF OIL FUEL BUNKER




DECK CAMBER $6\frac{1}{2}$ " IN 27'-0"

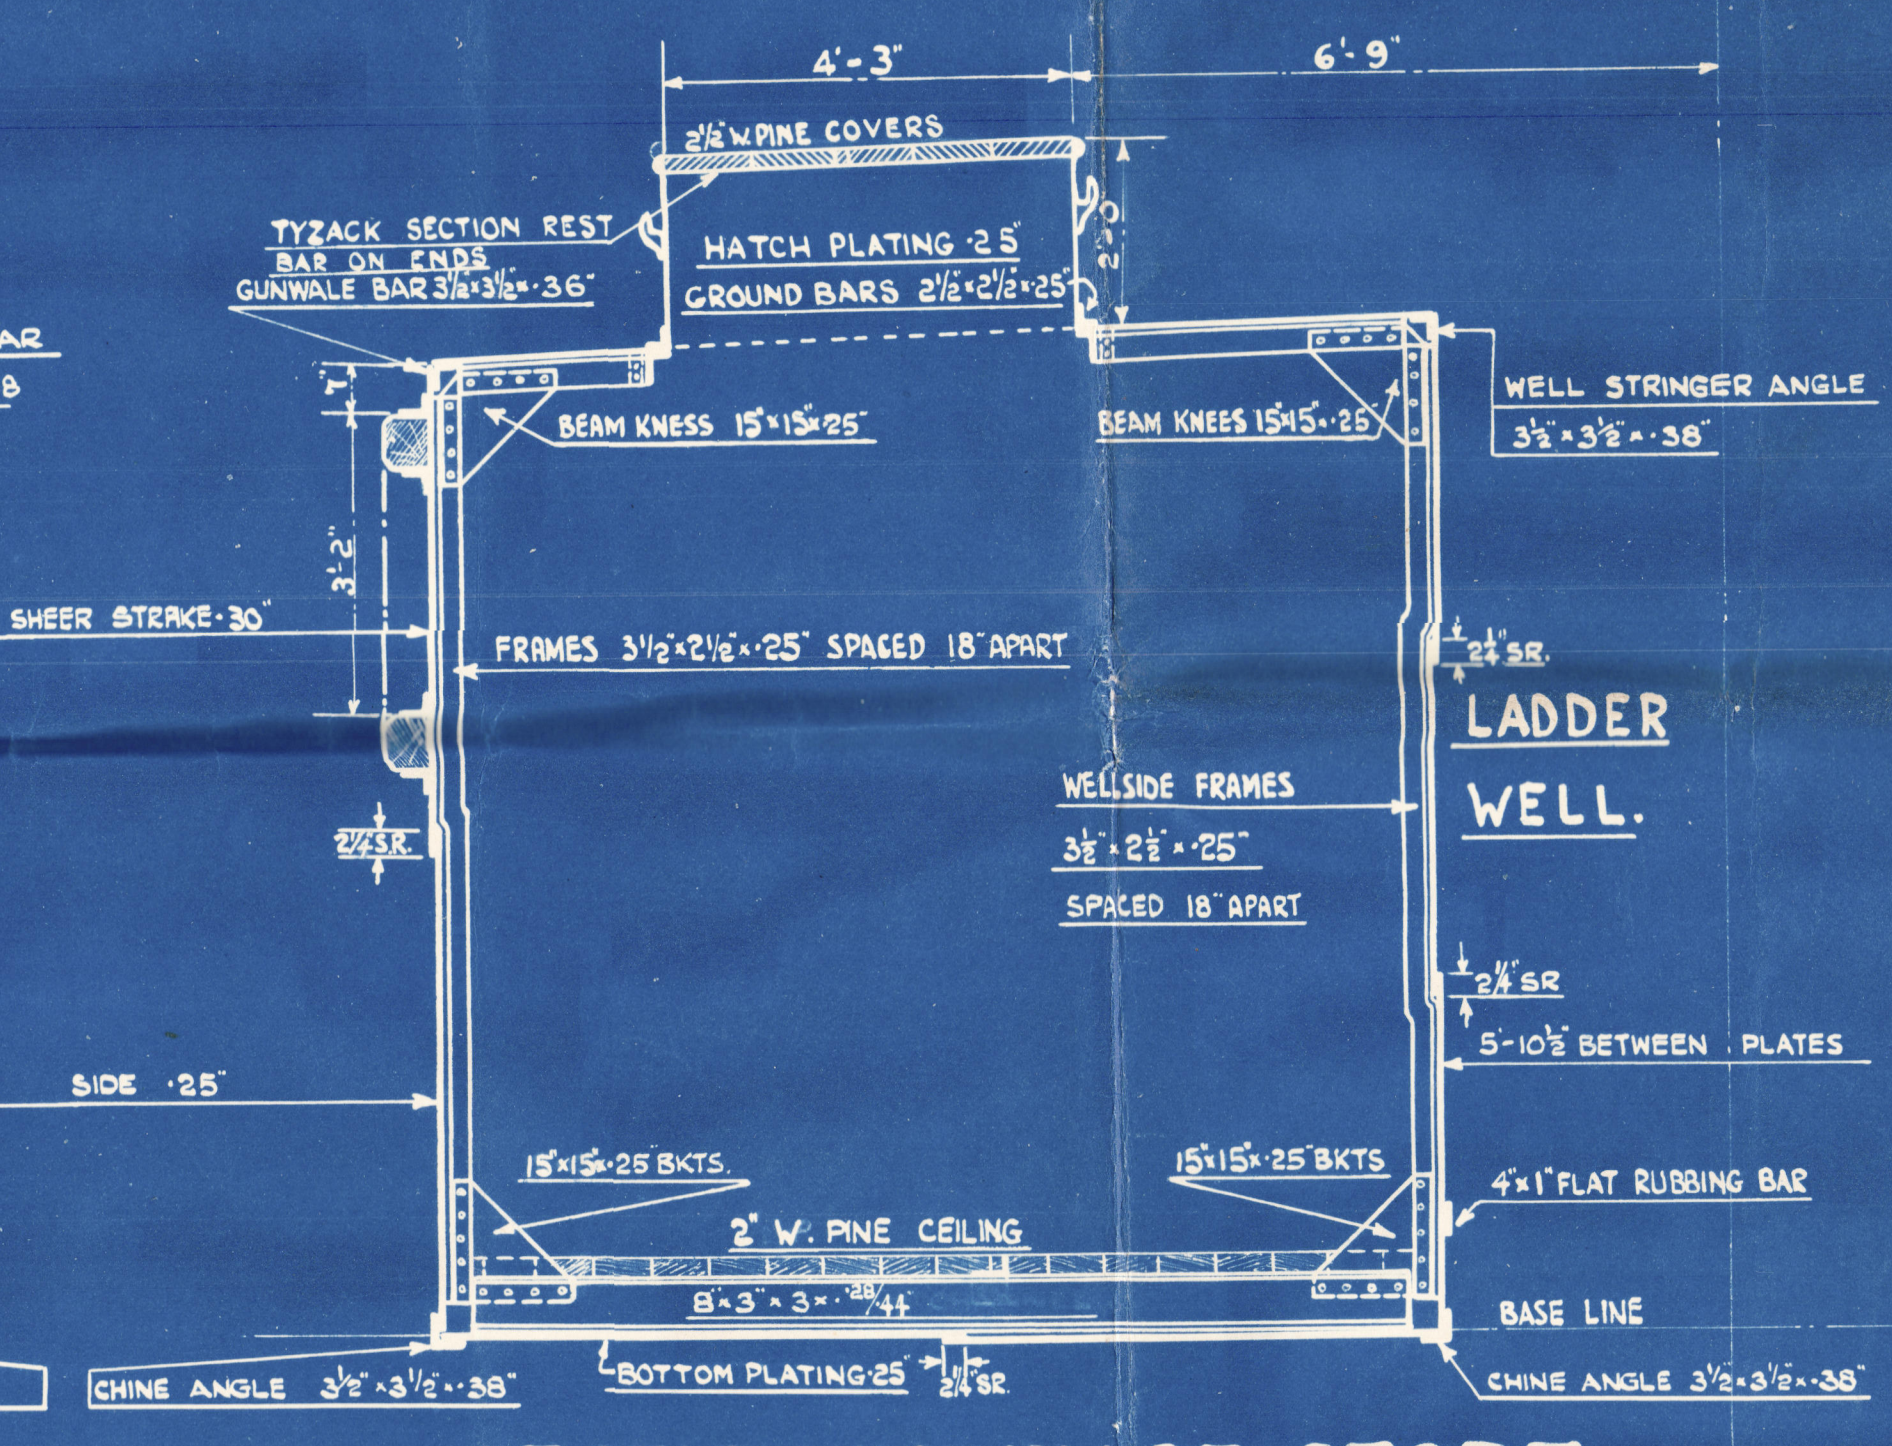


SECTION INWAY OF STORE.

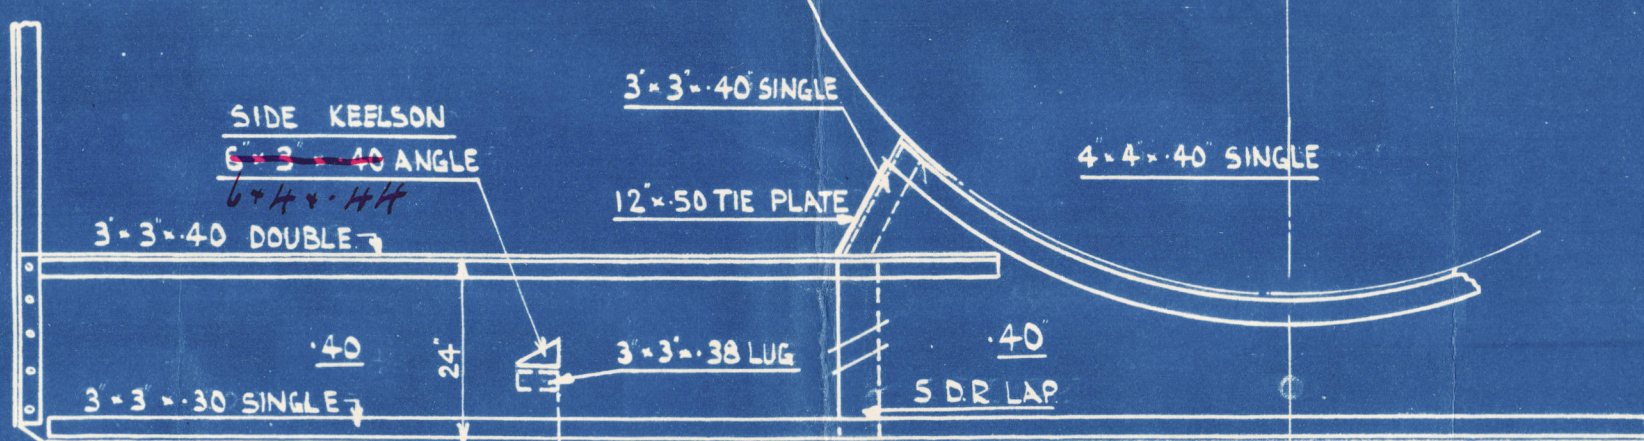


SECTION IN WAY OF BOILER BEARERS

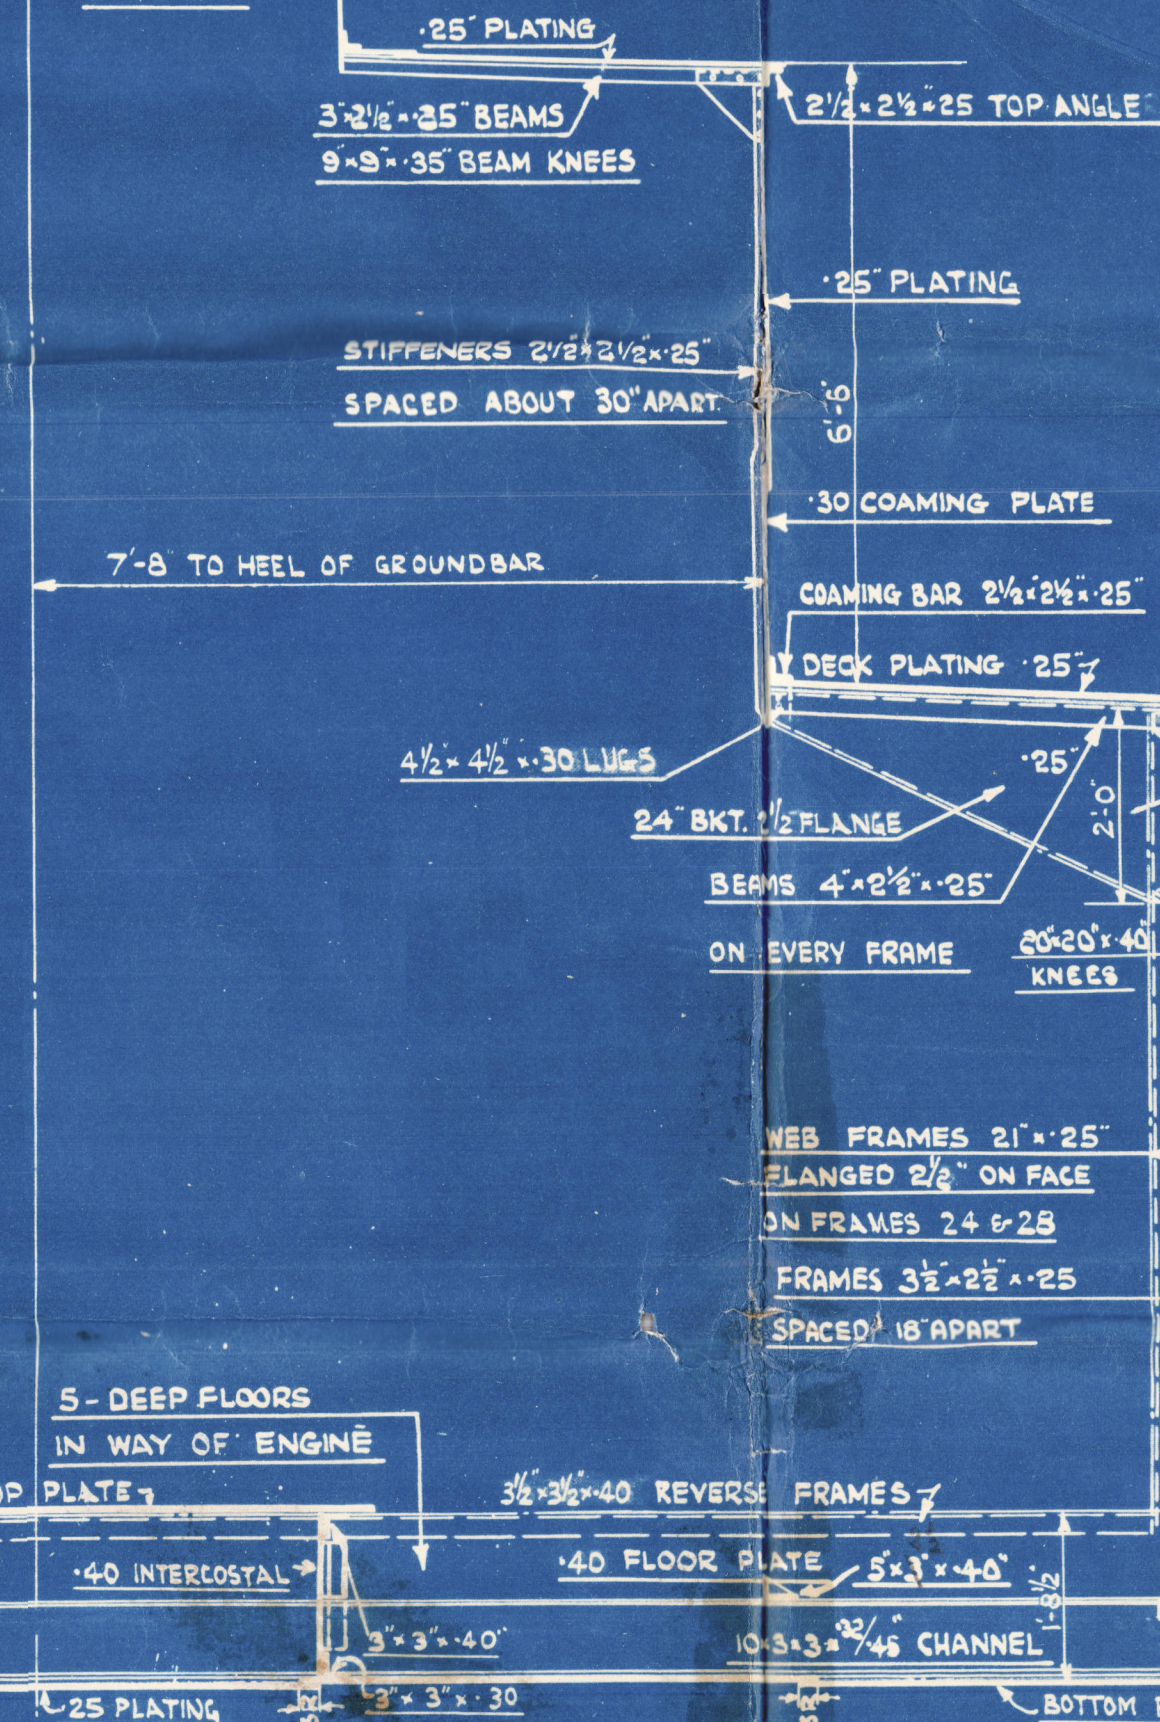

SECTION IN WAY OF ENGINE ROOM.

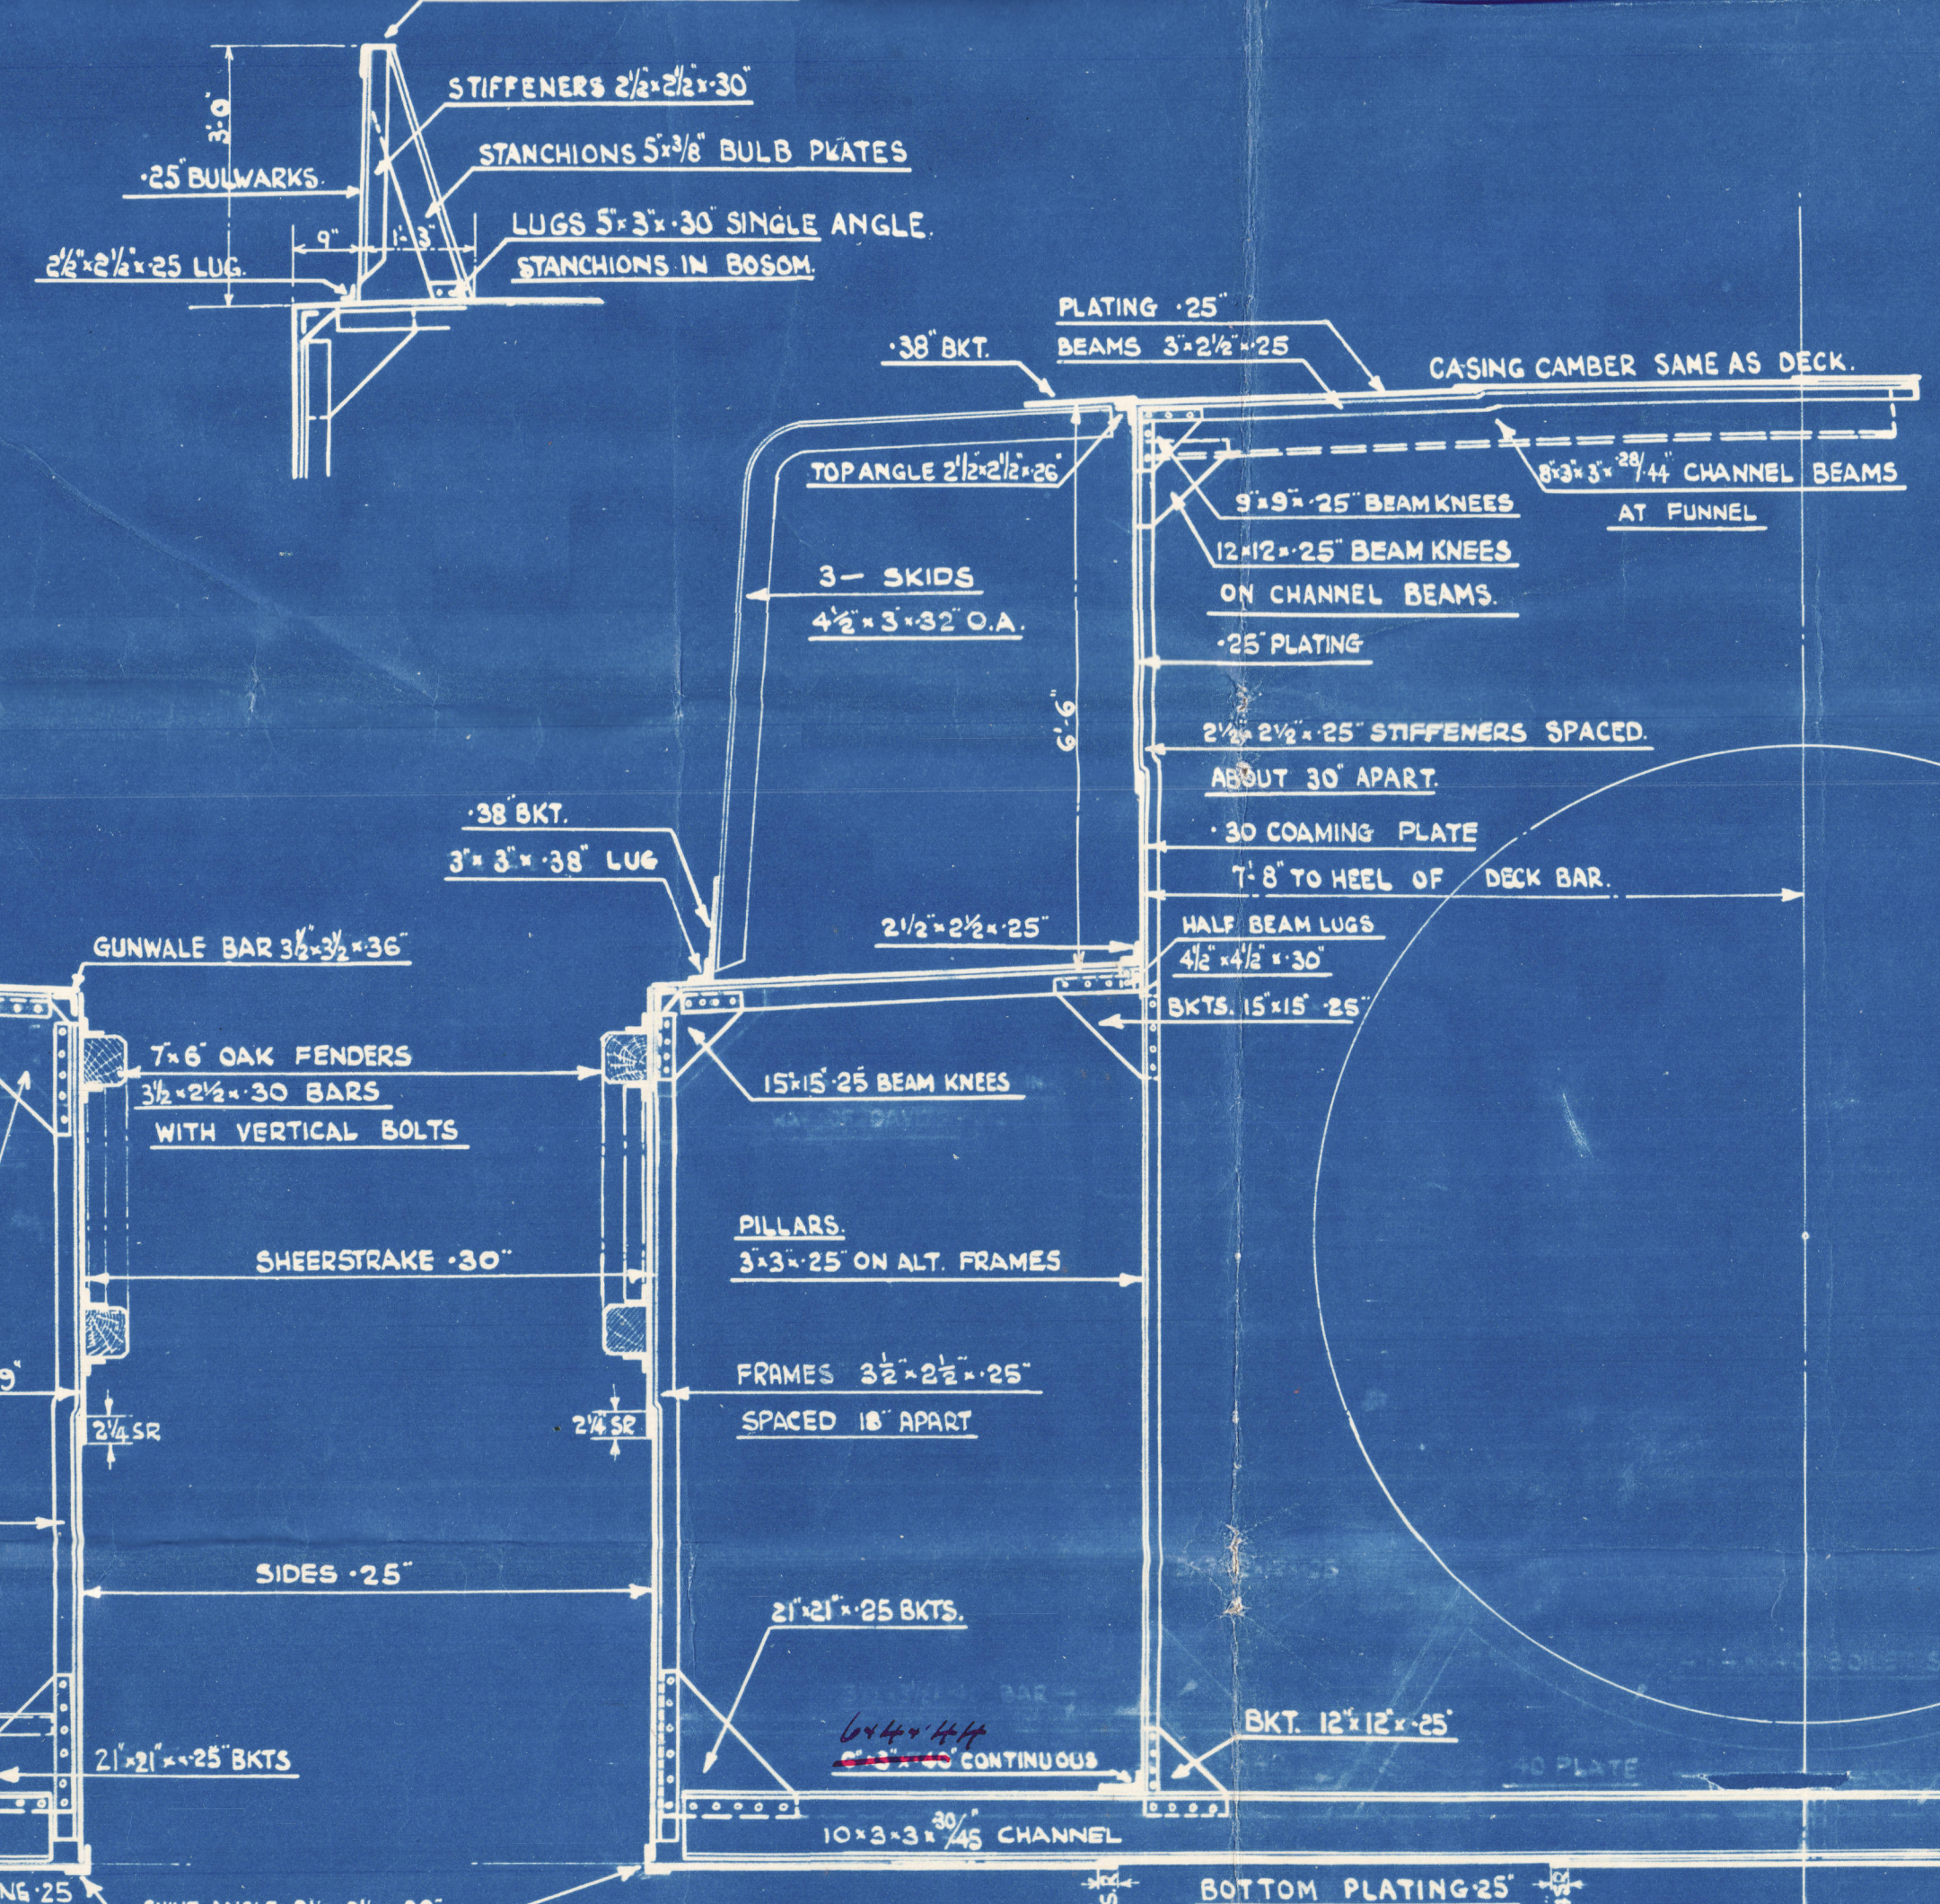

SECTION IN WAY OF BOILER ROOM.

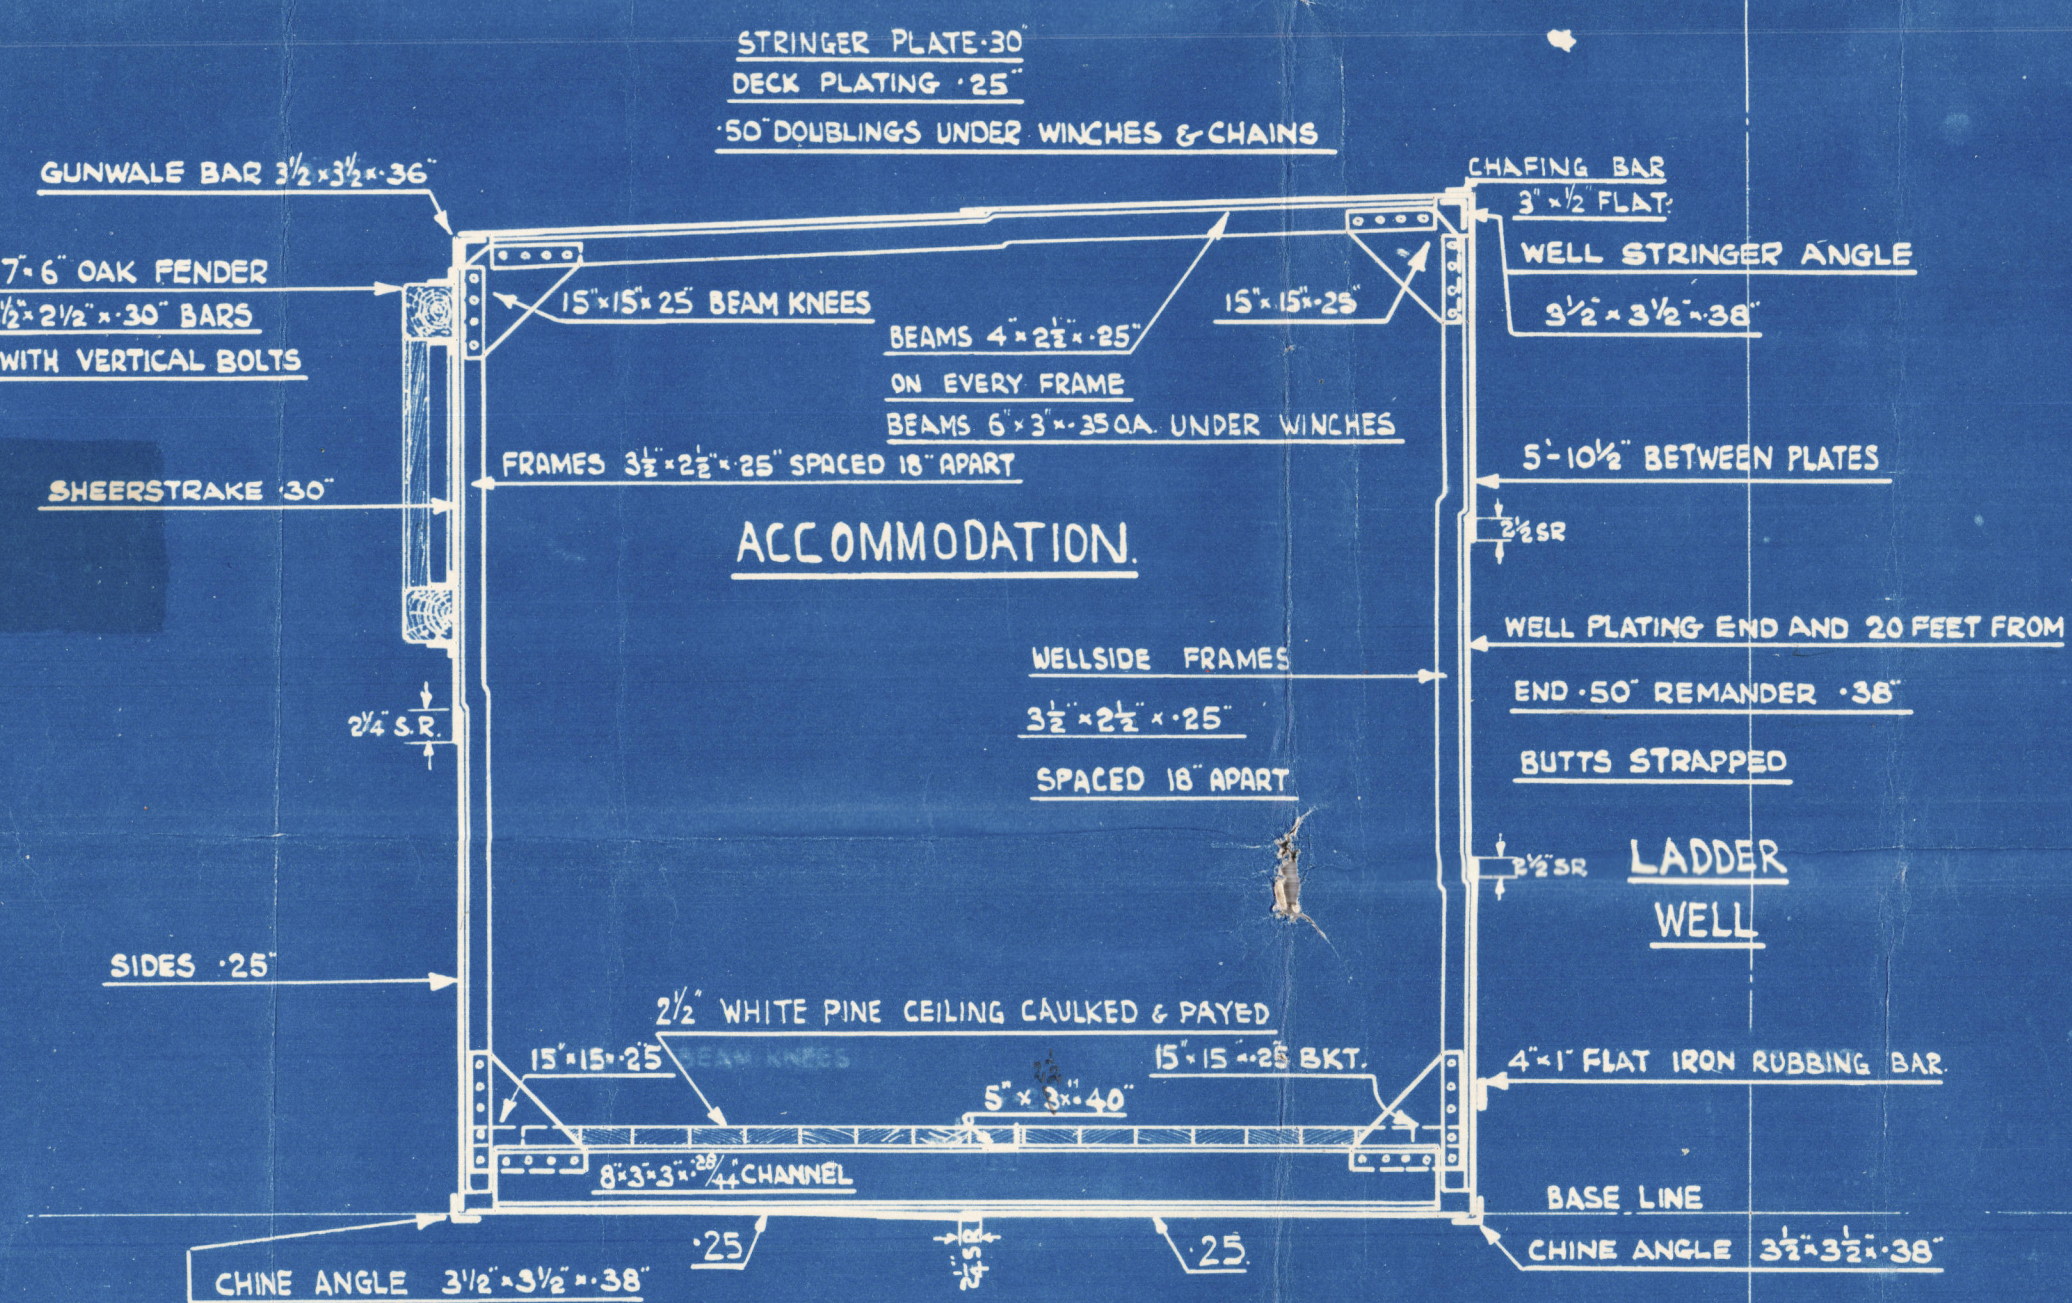

SECTION IN WAY OF LADDER WELL.

N^{os} 664. + 668.

a. Hall & Co. Ld.

midship section.) ^Y ⁿ TAYCRAIG


664. "FOREMOST CLAN".

NJN TAYCRAIG

abn. Report. 20030

668. "FOREMOST GLEN"

abn Report. 20354.

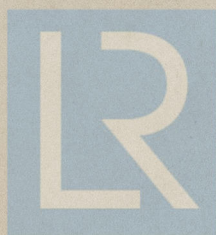

© 2020

004745-004754-0034

Lloyd's Register
Foundation