




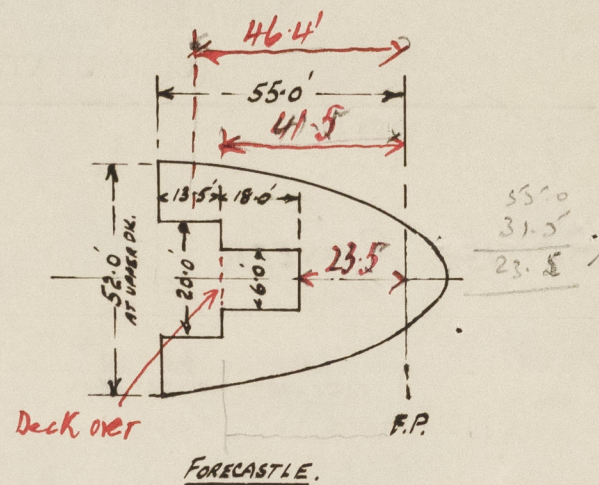

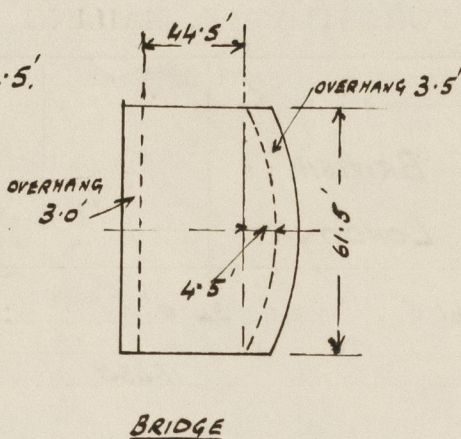

# British Pioneer

A new form should be prepared if any alterations that affect the freeboard have been made. If no such alterations have been made, the Surveyor should endorse the form on this side with his signature and the date.

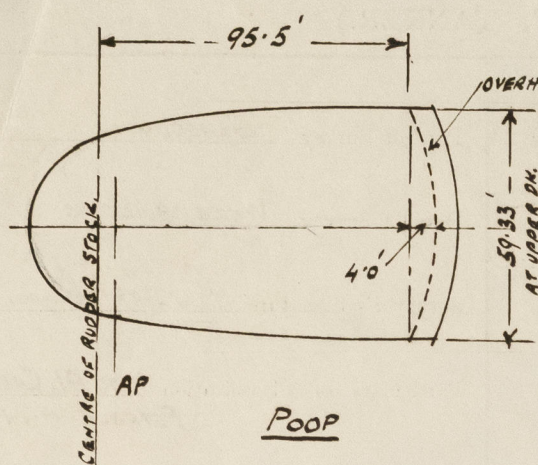

At side 95.50  
Bow front  $\frac{2}{3} \times 4$  2.67  
98.17  
Overhang 4.5  
- 2.67  
1.83

At side 44.5  
Bow front  $\frac{2}{3} \times 4.5$  3.0  
47.5

Forecastle 46 = 160 = 24.23  
52 23.5 23.5  
18.0 23.5 18.0  
47.73 47.73  
41.5 3.63  
7.27 51.36  
13.5 x 14.5 7.91 7.91  
24.75 49.41 49.41

Approved plans of Midship Section, Profile & Deck, Sternframe, Rudder, W.T. doors & coamings, & scuppers & discharges forwarded herewith for reference.  
Freeboard request form herewith.

Trade of ship INTERNATIONAL.

Names of sister ships \_\_\_\_\_

Builder's name and yard number BLYTHSWOOD S. B. CO. LD. YARD No 97.

Owners BRITISH TANKER CO. LD. LONDON.

Approx  
GROSS  
TONNAGE  
8,500

Fee £ 34 . 0 . 0



© 2020

Lloyd's Register  
Foundation