


Nº 91. PROFILE & DECK PLANS.

DIMENSIONS - 253'-0" B.P. - 43'-2" M.D. - 20'-0" M.D.
TO CLASS B.S. (GREAT LAKES AND RIVER ST LAWRENCE)







SCALE 1/8" = ONE FOOT.

DRAFT 14'-0" F.W.

14 APR 1925

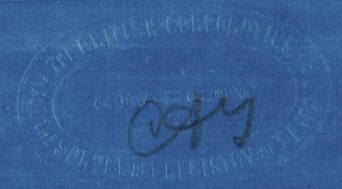

Approved
See plan 14-25

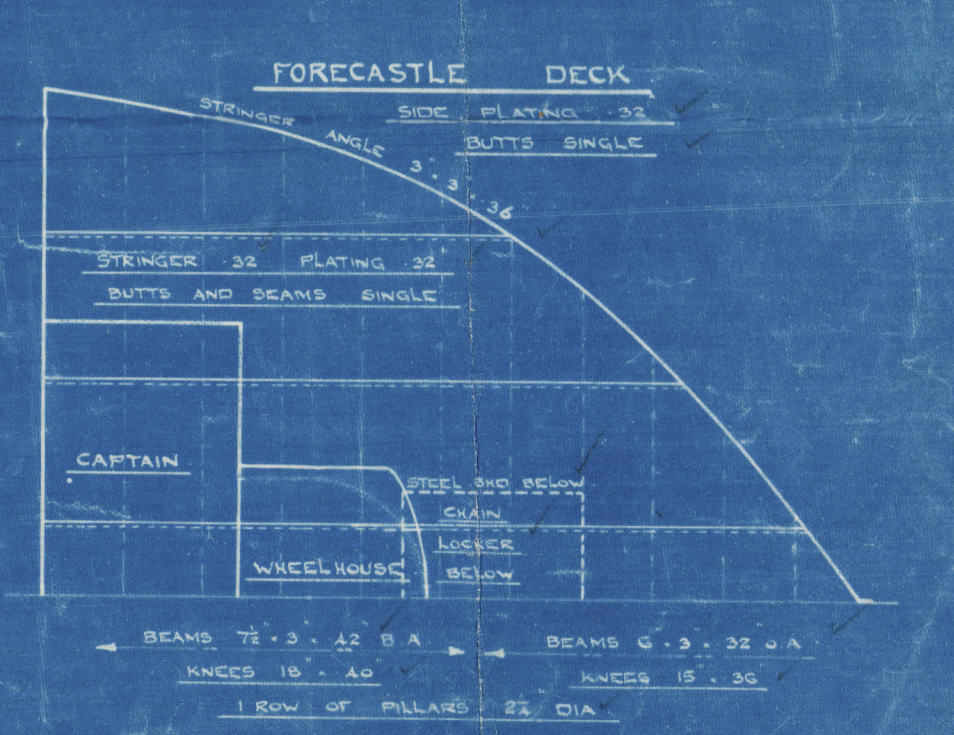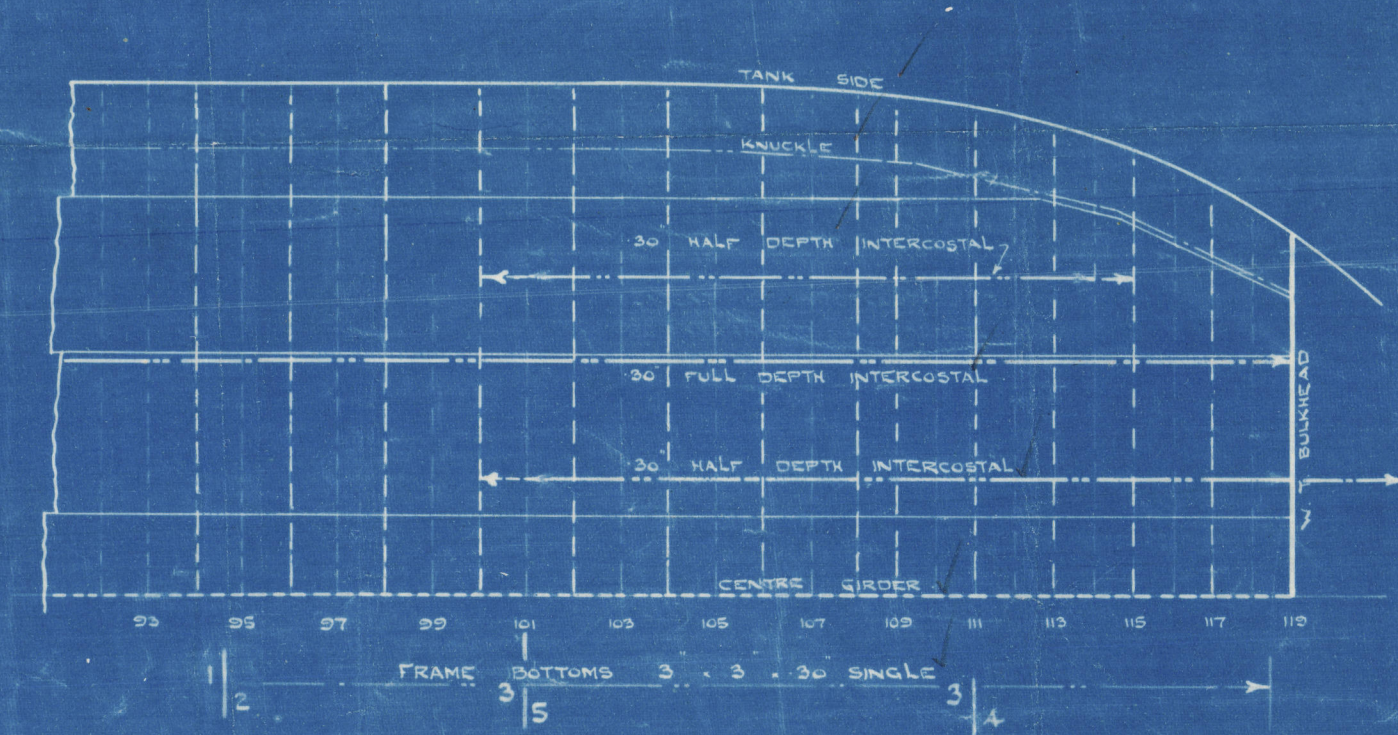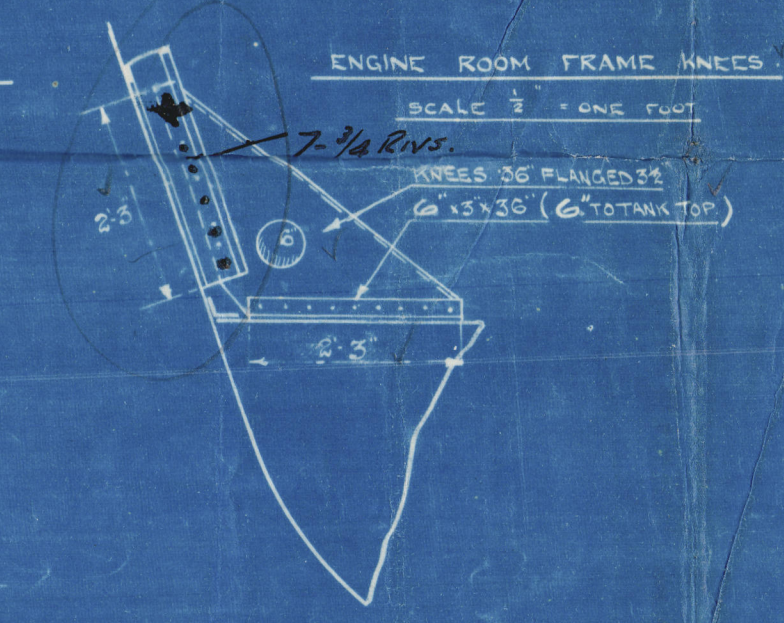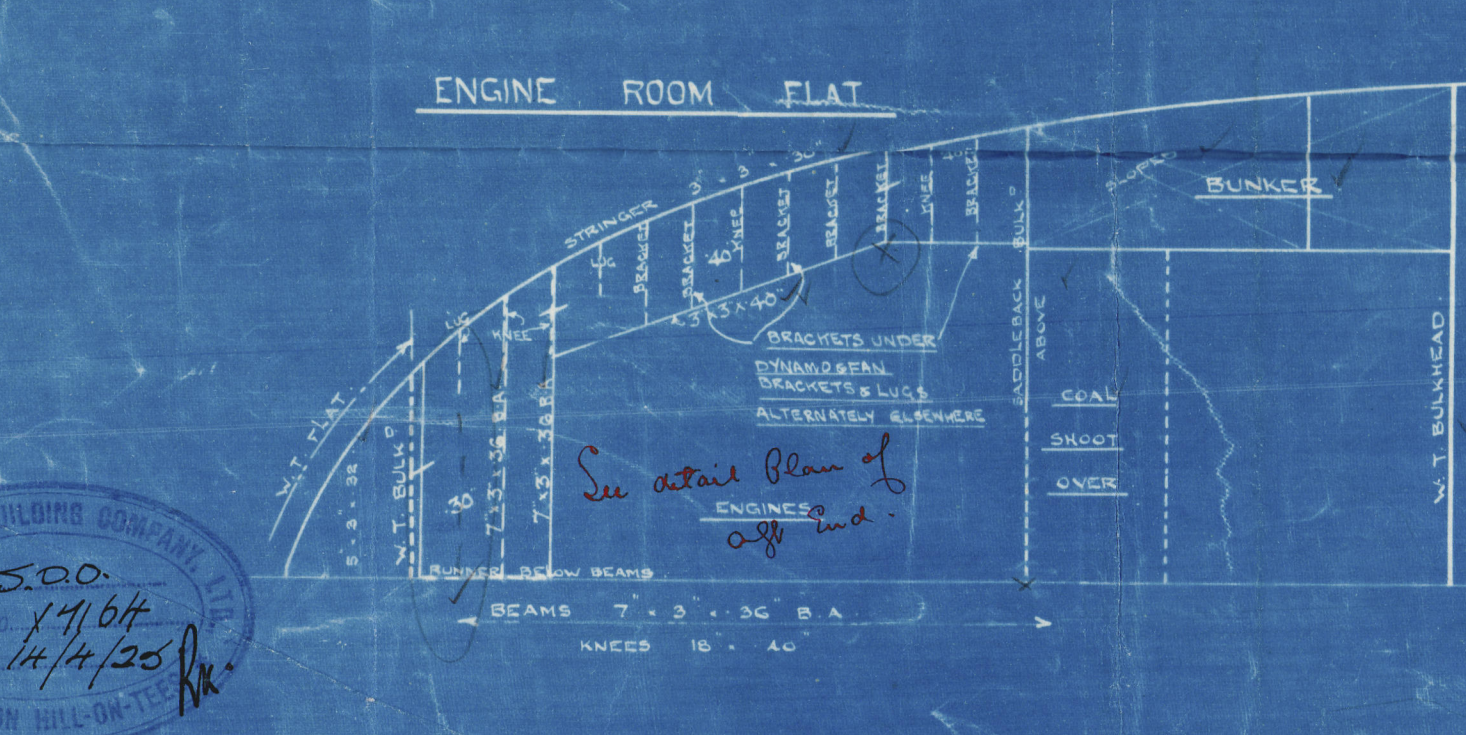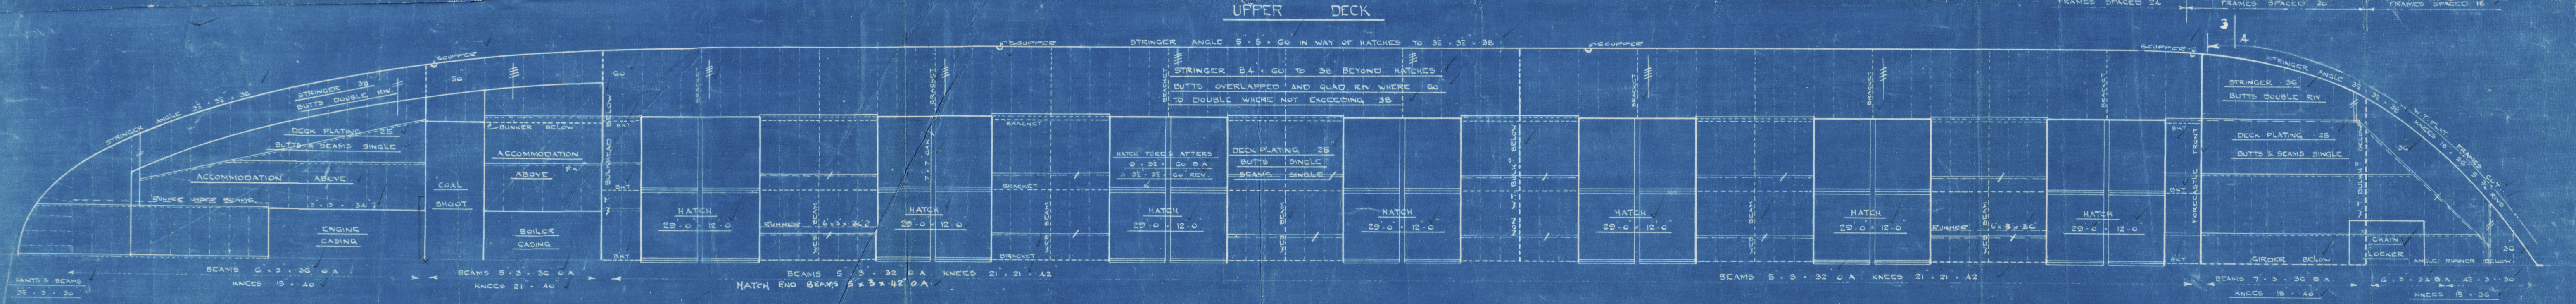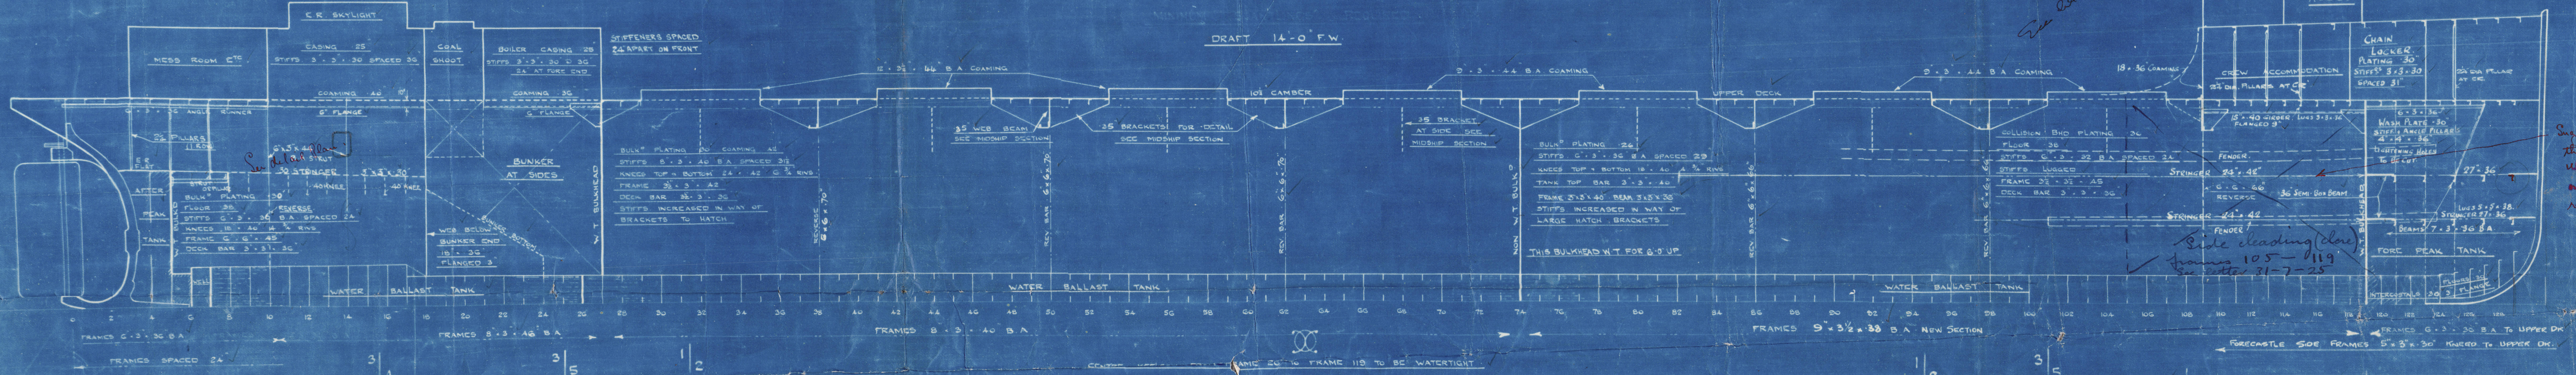

Dept. 500
Issue No. 14/164
Date 14/4/25

N. 444

004769-004777-041



And credit to

Bag

D.B. HANNA
T.C. 24/2/26 for 103.
Lewis & Co.

Q. 103

Prd. & deds. (Ans)

16.4.25

"L. B. Hanna"
"Geo. R. Donovan"
S.

3

Und. Profile & Decks.

Hurness S.B. Co. Ltd.

N^{os} 91 - 103 - 138.

Y. 6-24-2-26 for 103 16 " 4-25.
" 16 " 5-28 " 138.

91 "D. B. Hanna" Kellingdec

103 "Geo. R. Donovan" Kinnerdec

138. "William Schupp" Mender

RETAIN



© 2021

Lloyd's Register
Foundation

004769-004777-0111