


8 APR 1925

Nº 91.

ALTERNATIVE ARRANGEMENT OF FRAME BKT. TO TANK MARGIN

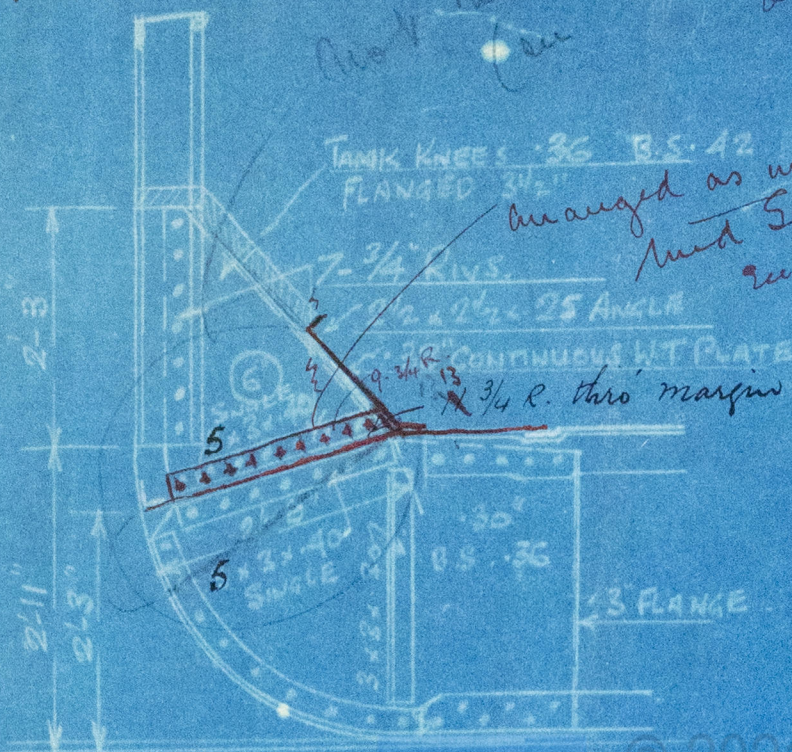


Not recommended

Approved

See Edn 3

Arranged as in
Need Seehorn
see also p. 205
H. W. 205

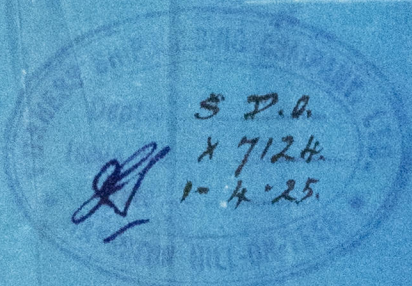

R

© 2021

Lloyd's Register
Foundation

004769-004777-0113

1 mmers 10.

91

Alten. Arg. of frame
Bkt to Jarl analyzing

Bay

Cancelled

Lloyd's Register
Foundation

004769-004777-0113