


LLOYDS
STAMP
17/12/23

ALTERNATIVE PROPOSAL: "A"

THIS COLLAR
SHRUNK ON.

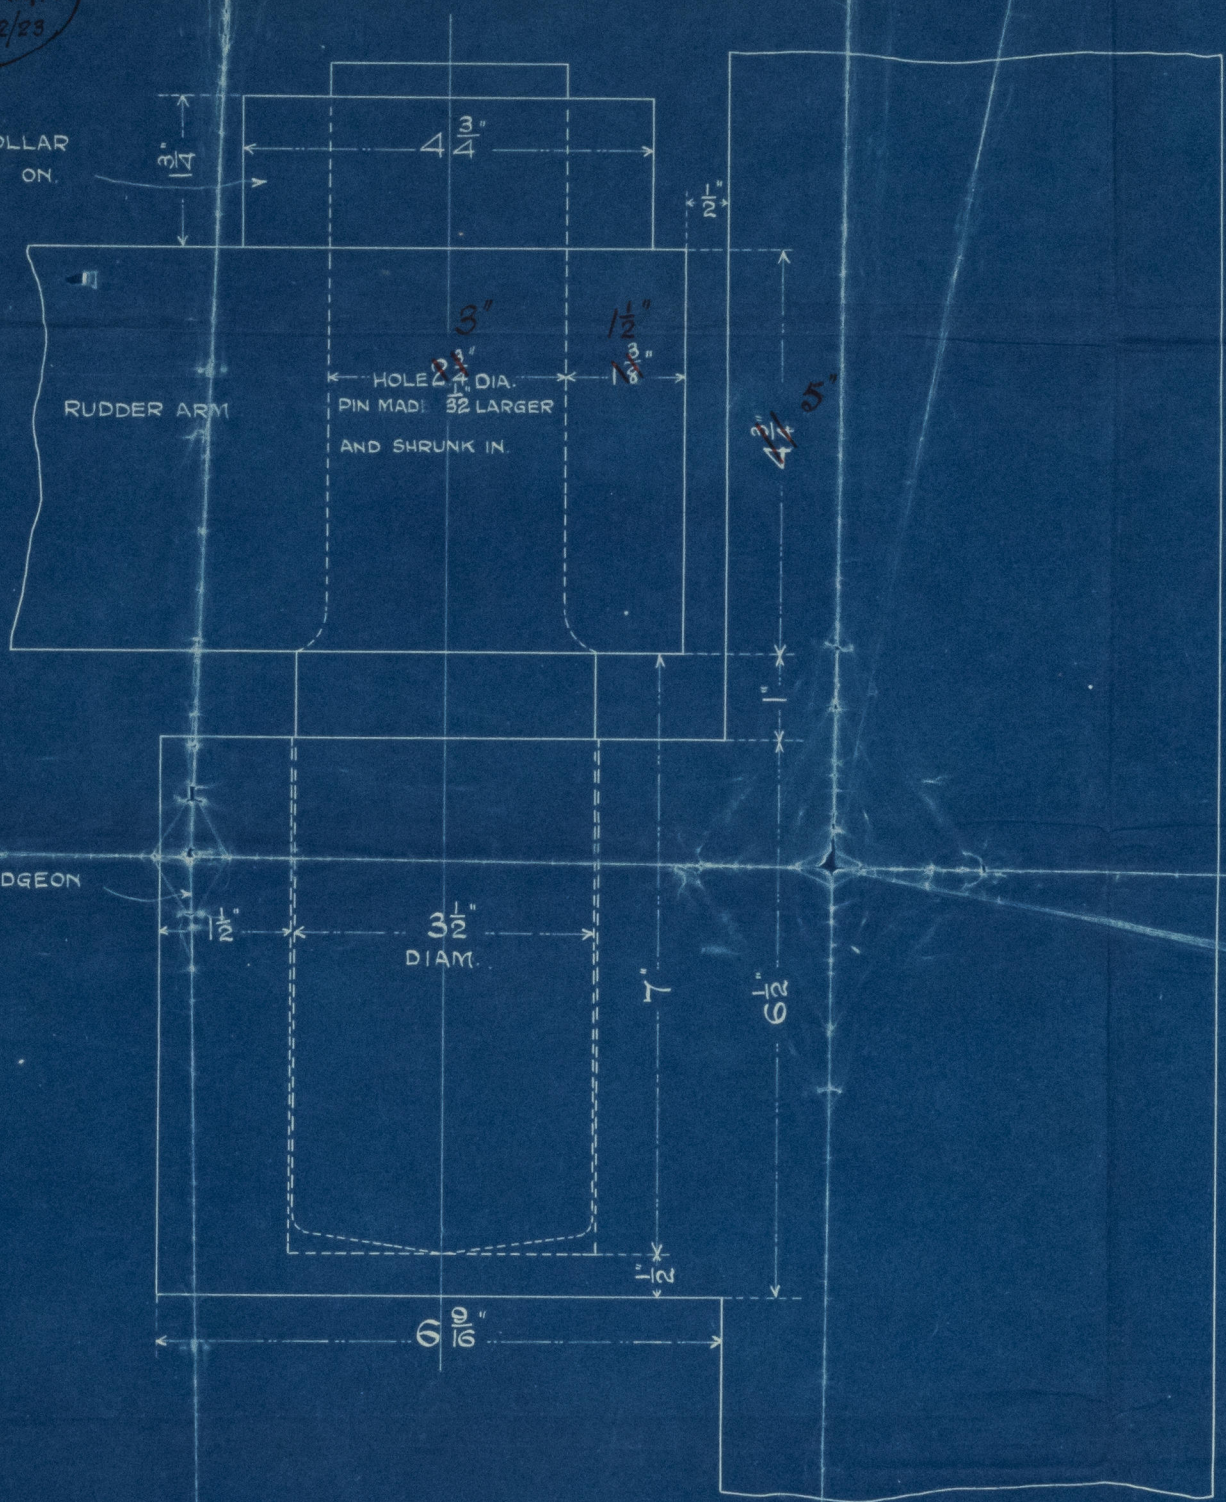

RUDDER PINTLES (PROPOSED). S.S. Nos 240 & 41.

SCALE :- 1/2 SIZE.

R. WILLIAMSON & SON, LTD
SHIPYARD, WORKINGTON.
TRACING No 3482. 11.12.1923.

*Copy of approved plan
with alterations made by
Lloyds' officials in London.*