


M.V. SAN ELISEO.

SCALE $\frac{1}{16}'' = 1'-0''$

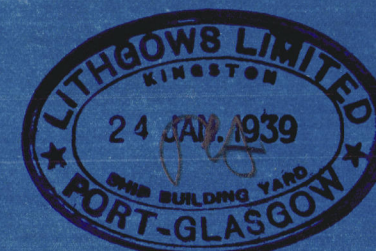

M.Y. SAN ELISEO

LITHGOWS LTD N° 916

PROFILE DECKS

AS BUILT

GREENOCK FIRST ENTRY

REPORT N° 20699

RETAIN



© 2021

Lloyd's Register
Foundation

004769-004777-0270