


DURHAM



	FORD NO5 DEEP OF, WB	AFT NO4 DEEP OF, WB	FORD NO4 DEEP OF, WB
	SHAFT TUNNEL		
AFT NO5 DEEP OF, WB	FORD NO5 DEEP OF, WB		
	SHAFT TUNNEL		
	FORD NO5 DEEP OF, WB	AFT NO4 DEEP OF, WB	FORD NO4 DEEP OF, WB

OF WB	CROSS BUNKERS
OF WB	
OF WB	

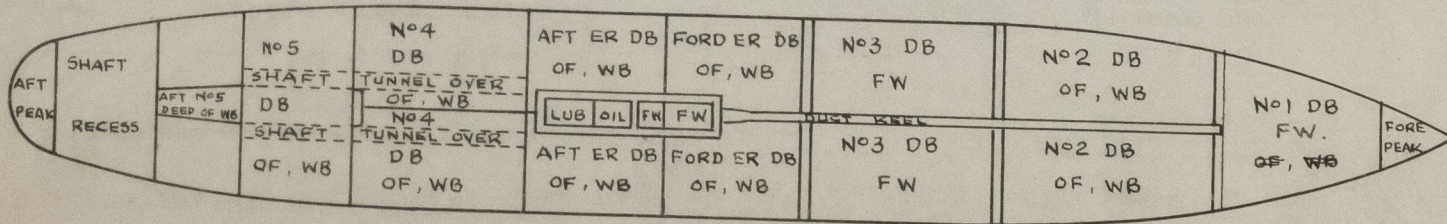

© 2020

Lloyd's Register  
Foundation

004789-004798-0172