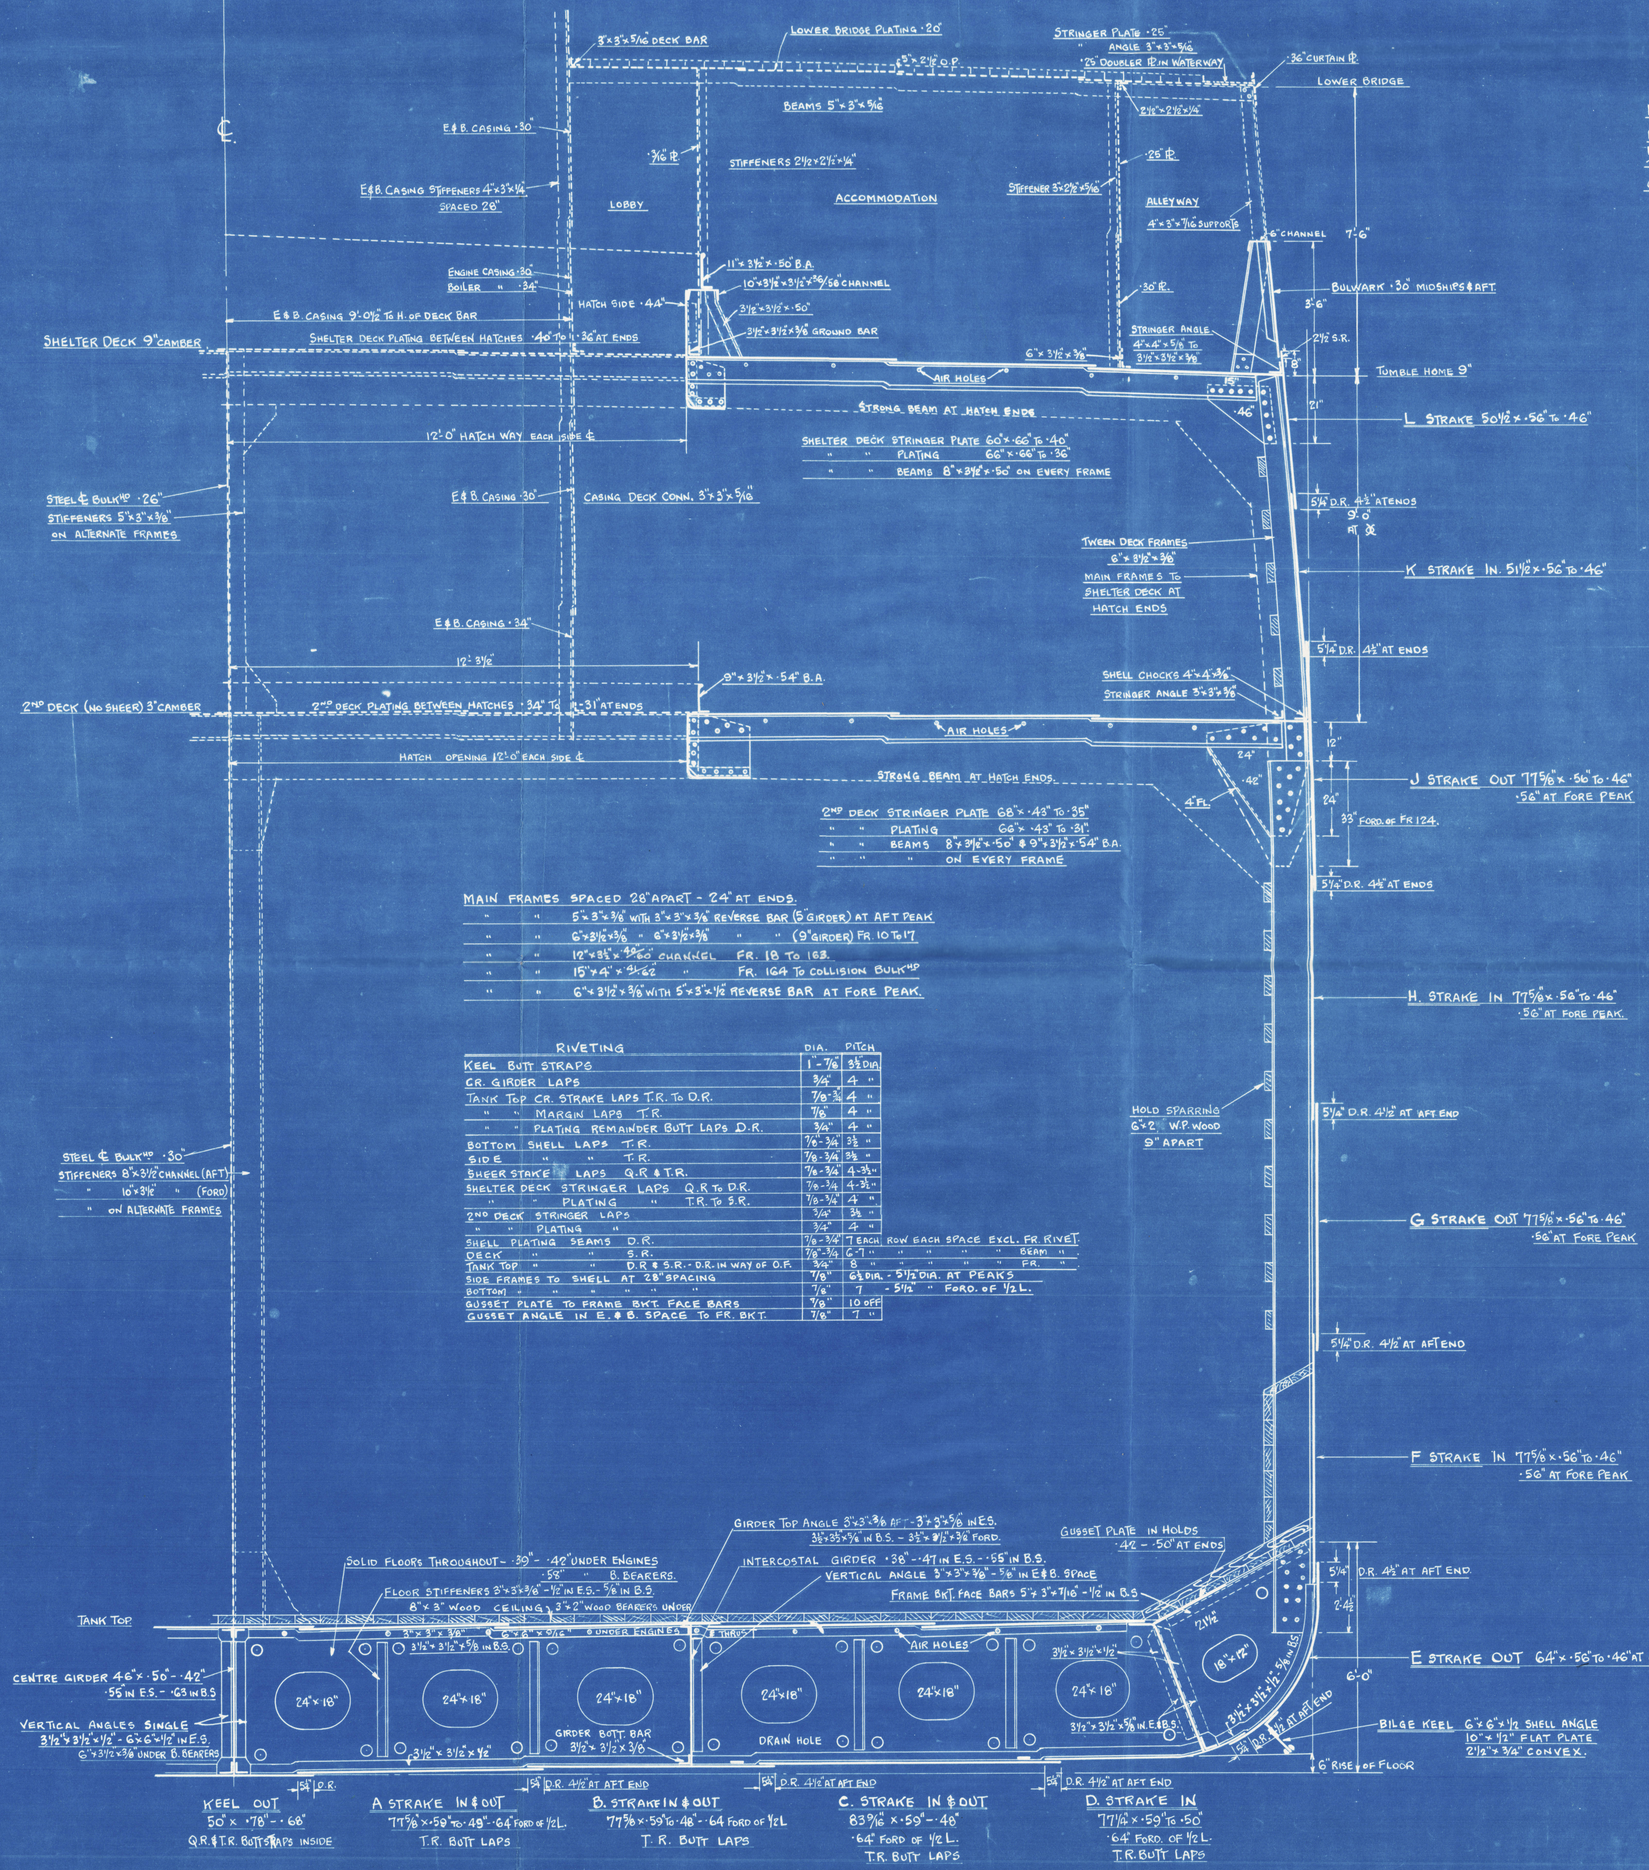

LLOYDS NUMERALS

L × D =	425 × 35·5 =	15087
L × (B + D) =	425 × 92 =	39100
L/D =	425/36·5 =	11·6
d (MARGIN)	=	28·66.

DIMENSIONS:- 425'-0" B.P. × 56'-6 B.M. × 27'-6" TO 2ND DECK. (LEVEL F & A)
× 36'-6 TO SHELTER DECK.

TO CLASS 100 A.1. AT LLOYDS "WITH FREEBOARD"

EQUIPMENT:- GRADE A +

2 BOWER ANCHORS STOCKLESS COLLECTIVE WEIGHT ~~150~~ 141 CWTS.
1 STREAM ANCHOR (EX. STOCK).
270 FATHOMS 2" STUD LINK CABLE. (TAYCO)
90 " 5" STREAM 6 × 12 HAWSER QUALITY.
120 " 4¾" TOWLINE 6 × 24.
2 AT 90 FATHOMS 2¾" HAWSERS 6 × 12.
2 " 90 " 2½" " 6 × 12.
2 " 90 " 3" " 6 × 12.

RIVETING	DIA.	PITCH
KEEL BUTT STRAPS	1" - 7/8	3½ DIA
CR. GIRDER LAPS	¾	4 "
TANK TOP CR. STRAKE LAPS T.R. TO D.R.	7/8 - ¾	4 "
" " MARGIN LAPS T.R.	7/8"	4 "
" " PLATING REMAINDER BUTT LAPS D.R.	¾"	4 "
BOTTOM SHELL LAPS T.R.	7/8" - ¾"	3½ "
SIDE " " T.R.	7/8 - ¾	3½ "
SHEER STRAKE LAPS Q.R. & T.R.	7/8 - ¾	4 - 3½"
SHELTER DECK STRINGER LAPS Q.R. TO D.R.	7/8 - ¾	4 - 3½"
" " PLATING " T.R. TO S.R.	7/8 - ¾	4 "
2ND DECK STRINGER LAPS	¾"	3½ "
" " PLATING "	¾"	4 "
SHELL PLATING SEAMS D.R.	7/8 - ¾"	7 EACH ROW EACH SPACE EXCL. FR. RIVET.
DECK " " S.R.	7/8" - ¾	6 - 7 " " " " " BEAM "
TANK TOP " " D.R. & S.R. - D.R. IN WAY OF O.F.	¾"	8 " " " " " FR. "
SIDE FRAMES TO SHELL AT 28" SPACING	7/8"	6½ DIA. - 5½ DIA. AT PEAKS
BOTTOM " " " " "	7/8"	7 - 5½ " FORD. OF ½ L.
GUSSET PLATE TO FRAME BKT. FACE BARS	⅞"	10 OFF
GUSSET ANGLE IN E. & B. SPACE TO FR. BKT.	7/8"	7 "

HM A NAVAL DOCKYARD
WILLIAMSTOWN

AUSTRALIAN STANDARD STEAMSHIP
"S S RIVER LODDON"
MIDSHIP SECTION
AS FITTED

SCALE	1/2" = 1'-0"	JOB Nº		FILE Nº	29 & 30
DRAWN	J. ALEXANDER	APPROVED		PLAN Nº	R.L.2
TRACED				AMENDMENT	
CHECKED	J. Alexander	DATE	2-10-44		

MELBOURNE RPT 8661.

004799 - 004809 - 0106