
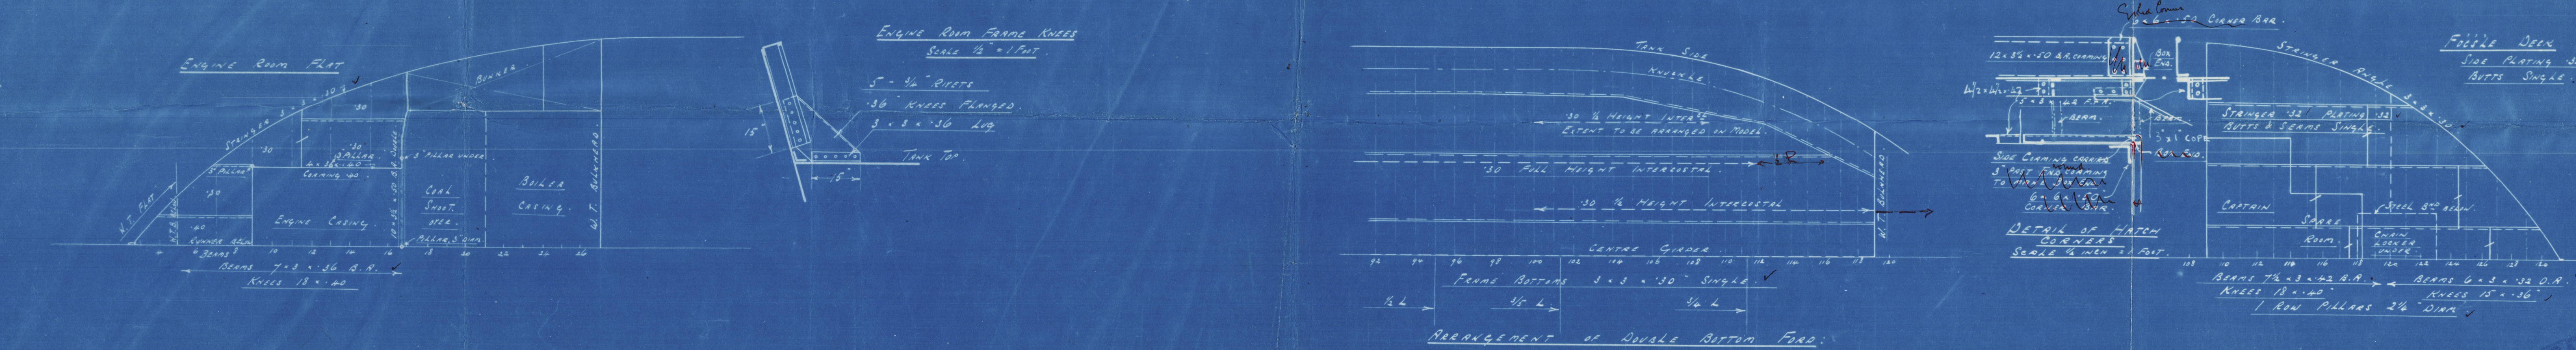
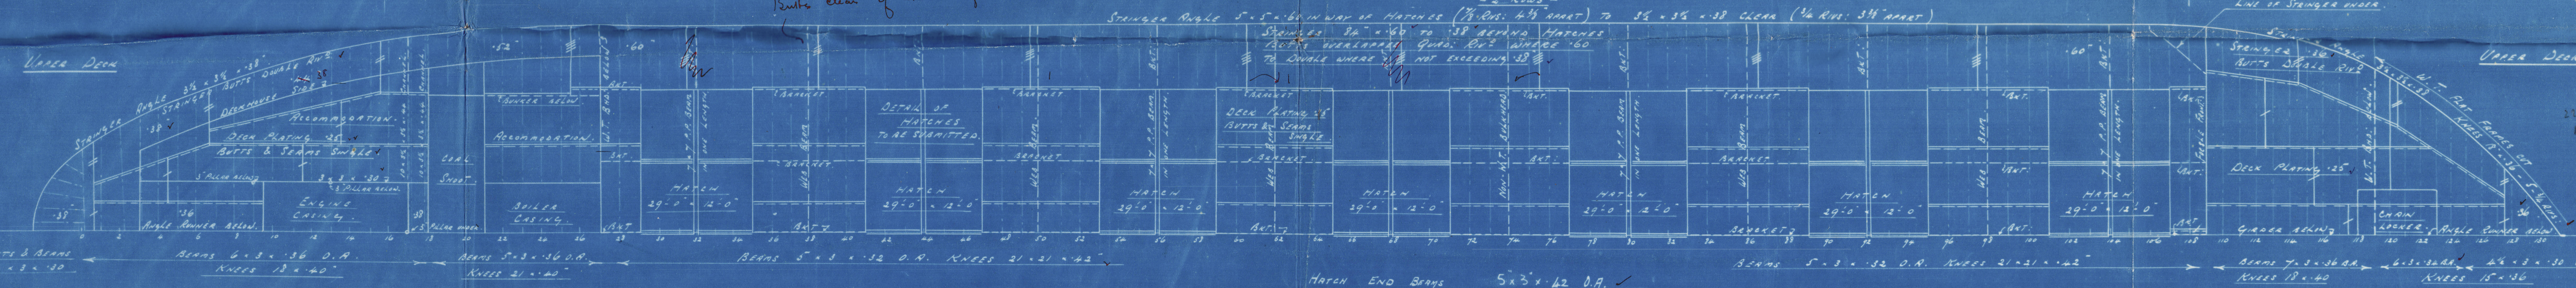


1-2 SEP 1907

- Nos 647-8-9 & 50 - PROFILE & DECK PLANS -

- DIMENSIONS: - 253'-0" B.P. x 43'-3" B.M. x 20'-0" MLD: -
- SCALE: - 1/4" INCH = 1 FOOT -
- TO CLASS B.S. GREAT LAKES & RIVER ST. LAWRENCE -
MINIMUM SCANTLINGS REQUIRED.
DRAFT 14'-0" F.W.

Approved *[Signature]*
Per Art 3 D 211

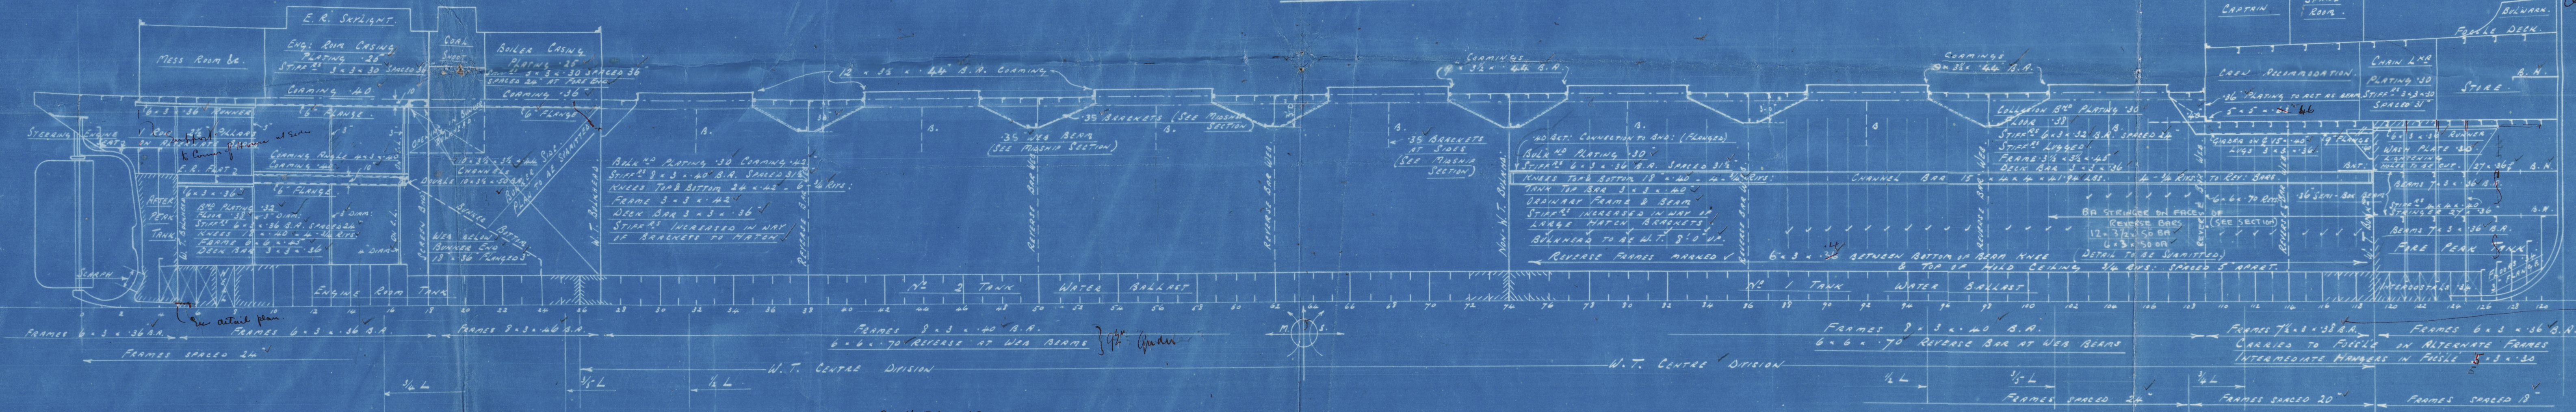

216
17-4
16-6
2-2
353
4-9

Earles

647.8.91650

Profile + dks.

Judge
Kenfick

Bag

T.C. 19/11/24

Earles B. B.

647.8.9150

Profile + dks.

3.9.24

RETAIN

2

© 2020



Lloyd's Register
Foundation

004833-004841-0172