
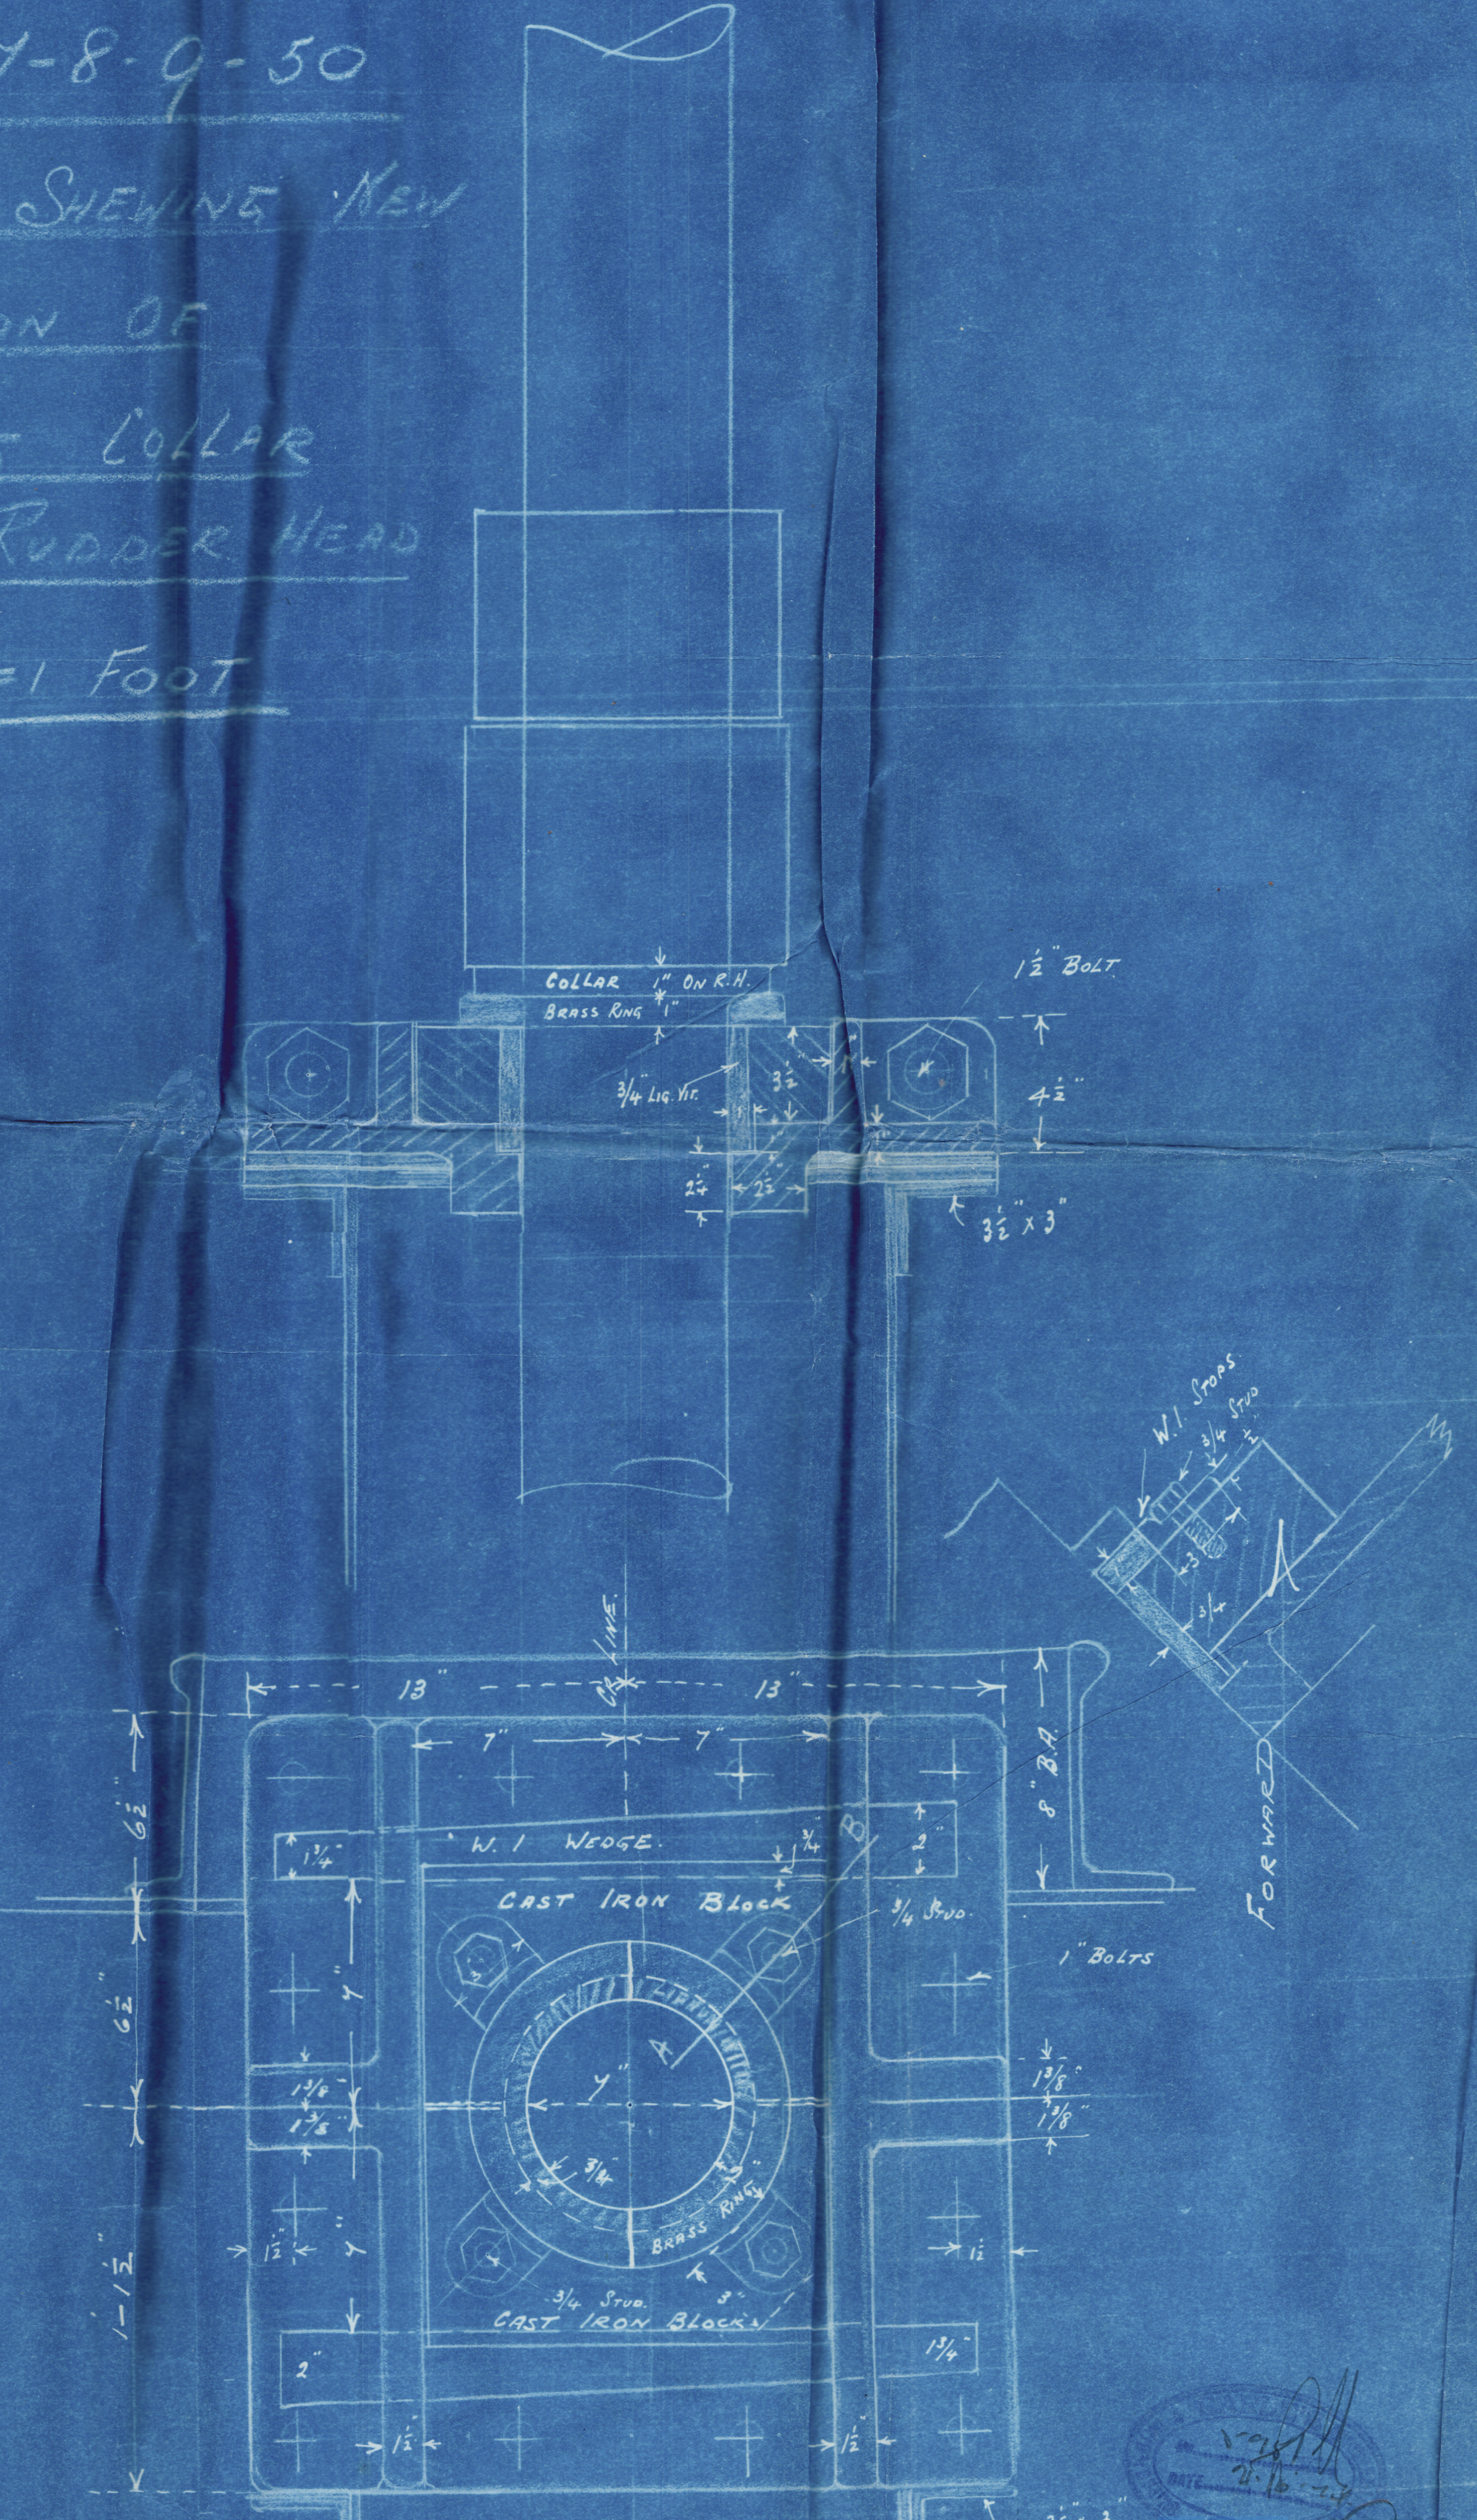


24 OCT 1924

NOS 647-8-9-50

SKETCH SHEWING NEW
POSITION OF
BEARING COLLAR
ON RUDDER HEAD
3" = 1 FOOT

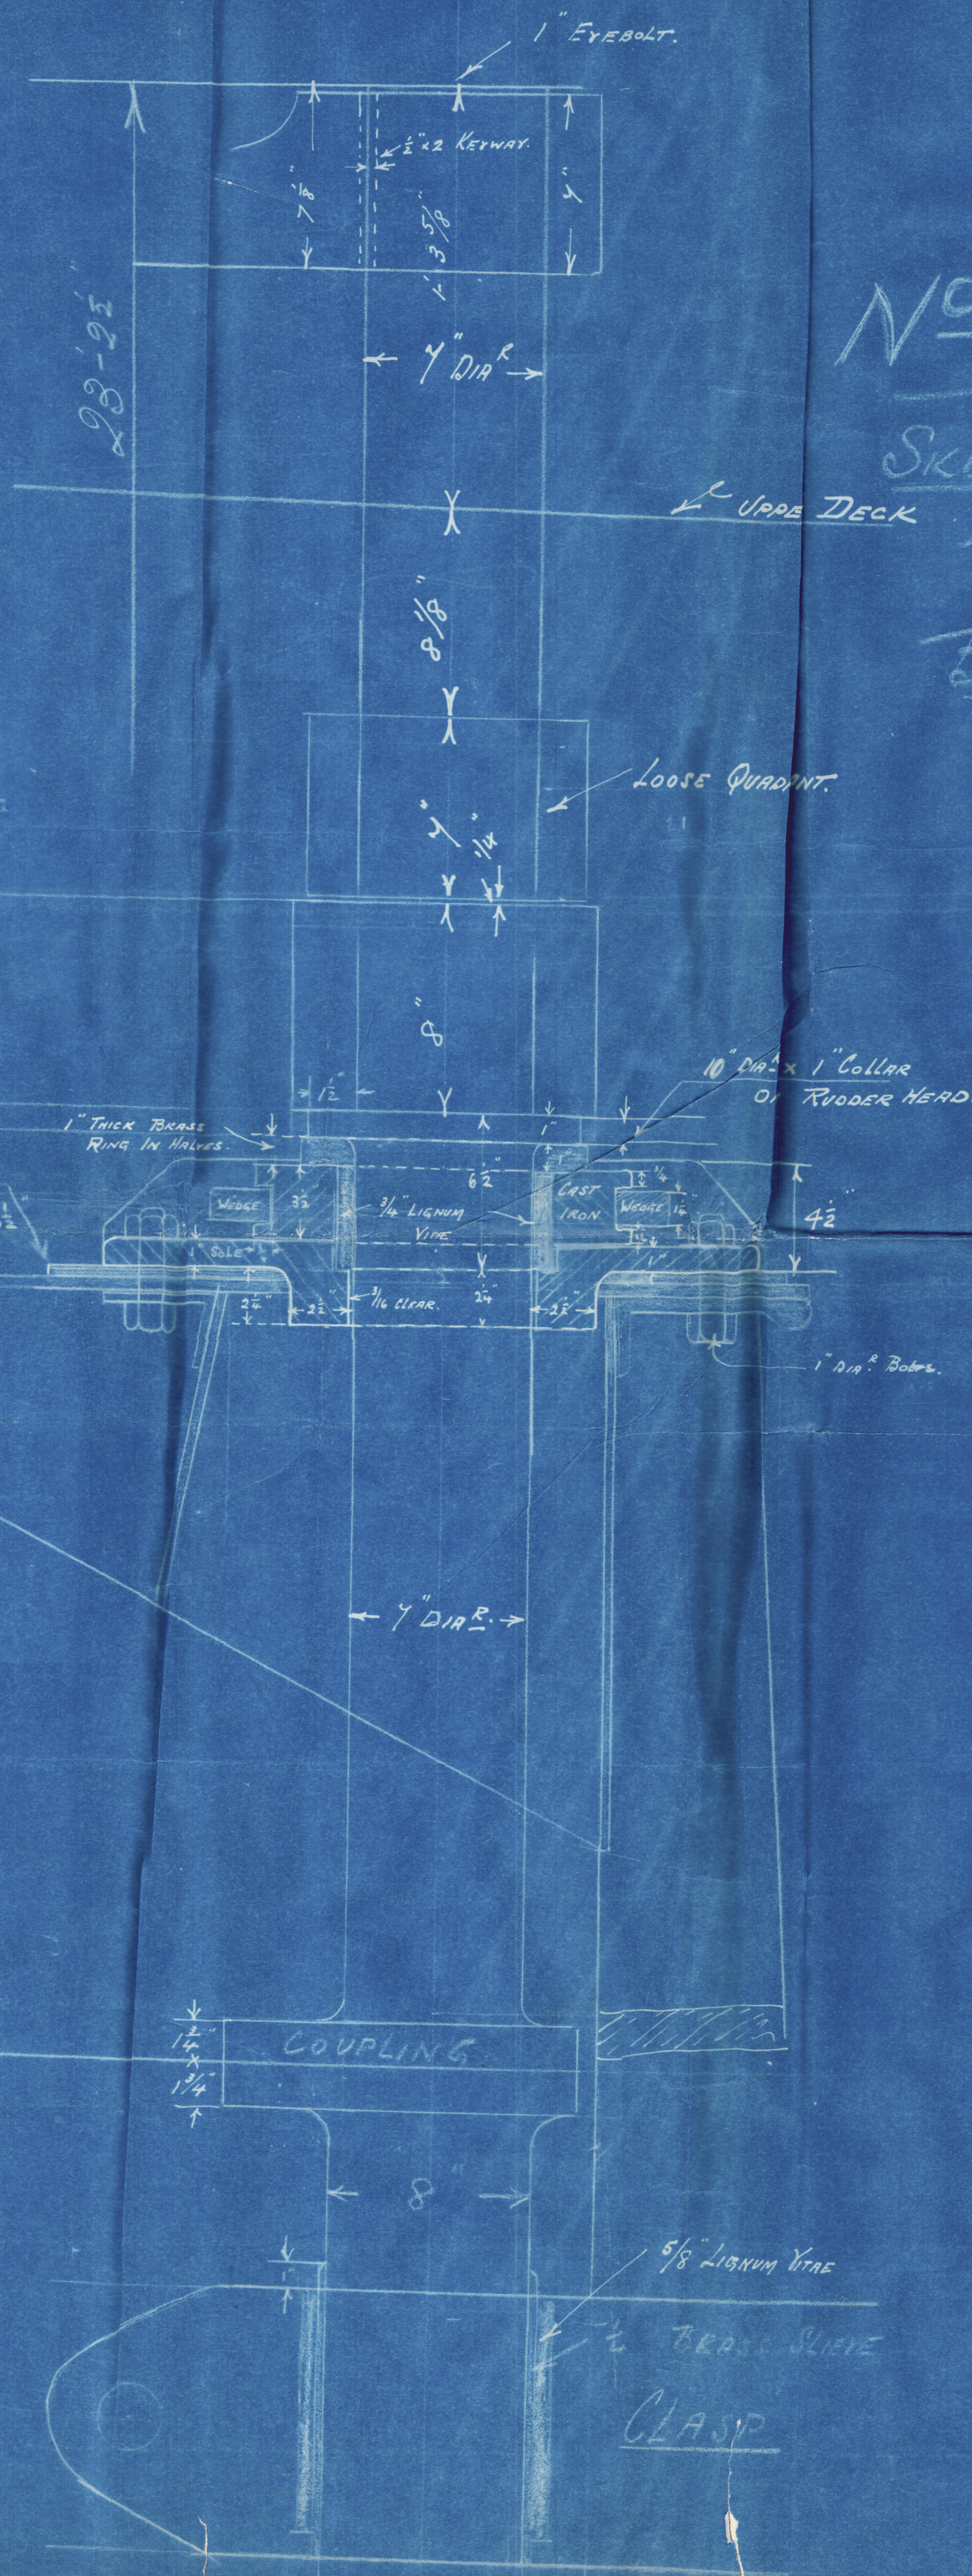

Charles S & Co
6/7/8/9/50






004833-004841-0174



© 2020

Lloyd's Register
Foundation