


18.9.11


S.249. - Single Screw-Cargo steamer: Arrangement of Steeldecks, Bulkheads and Webframes.

Scale 1:200.


Loop deck.

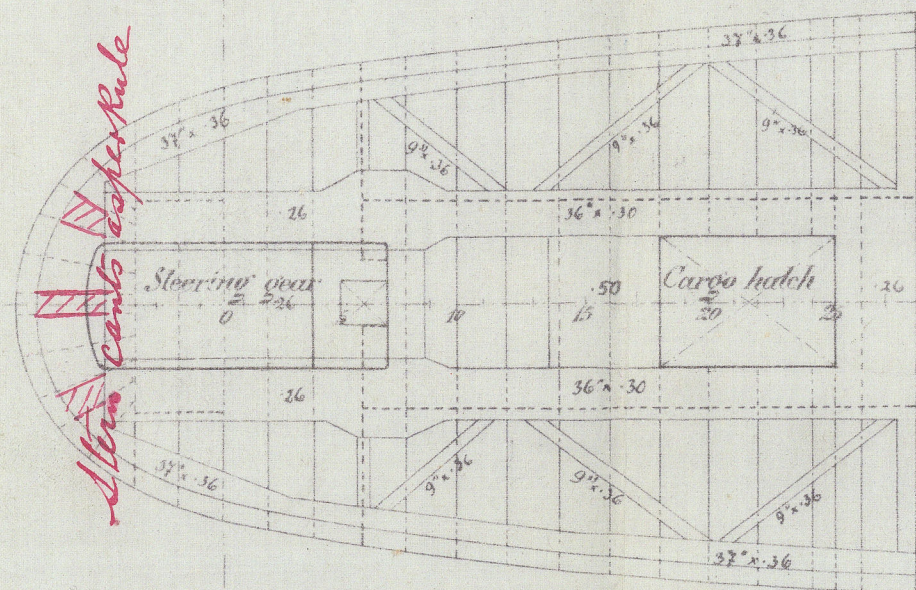


Bridge deck.

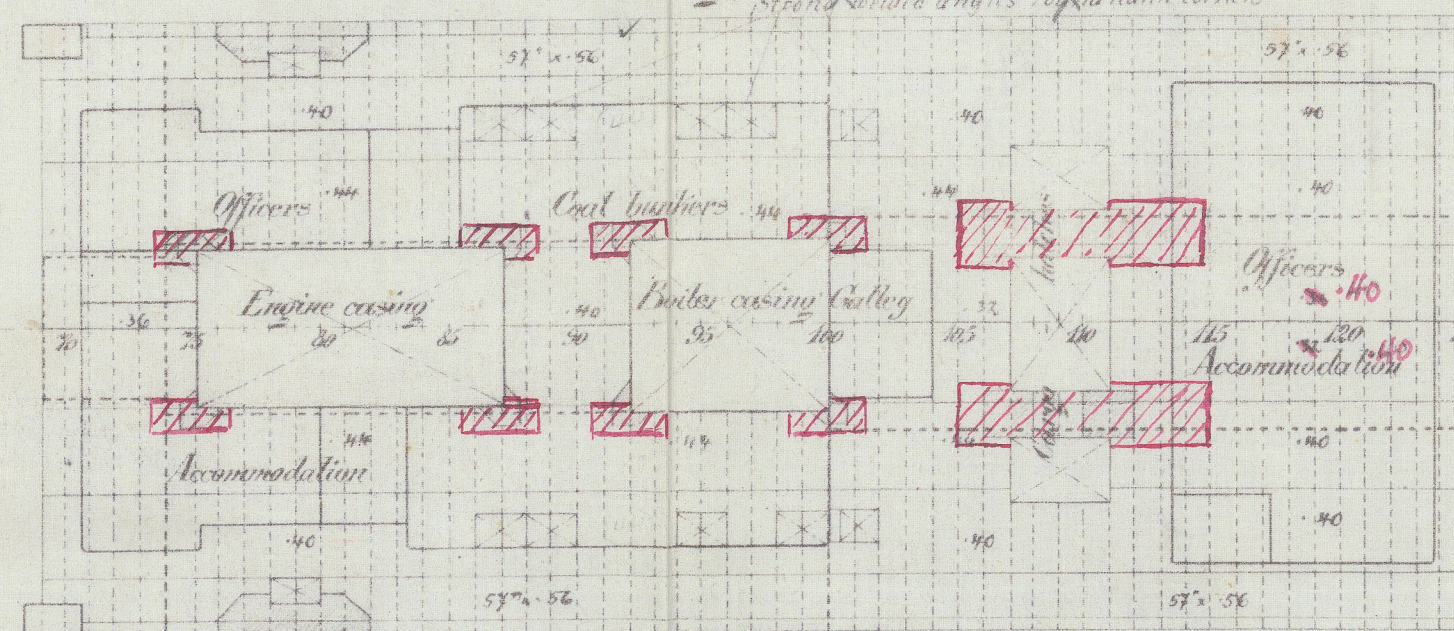



Bow-deck.

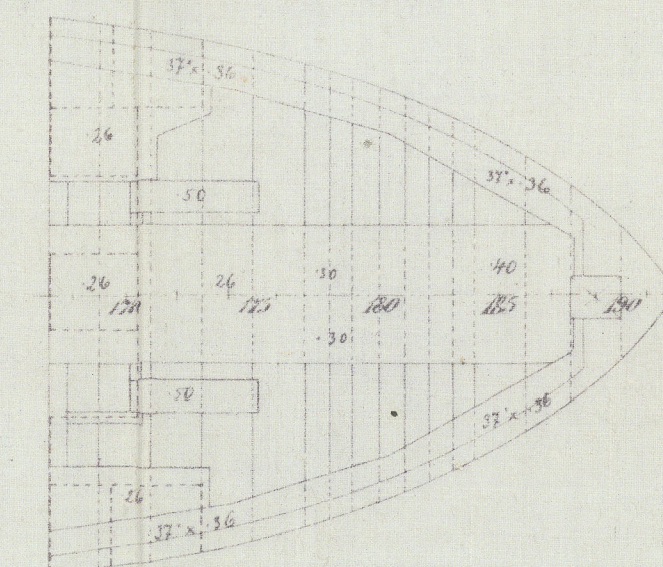

Upper deck.

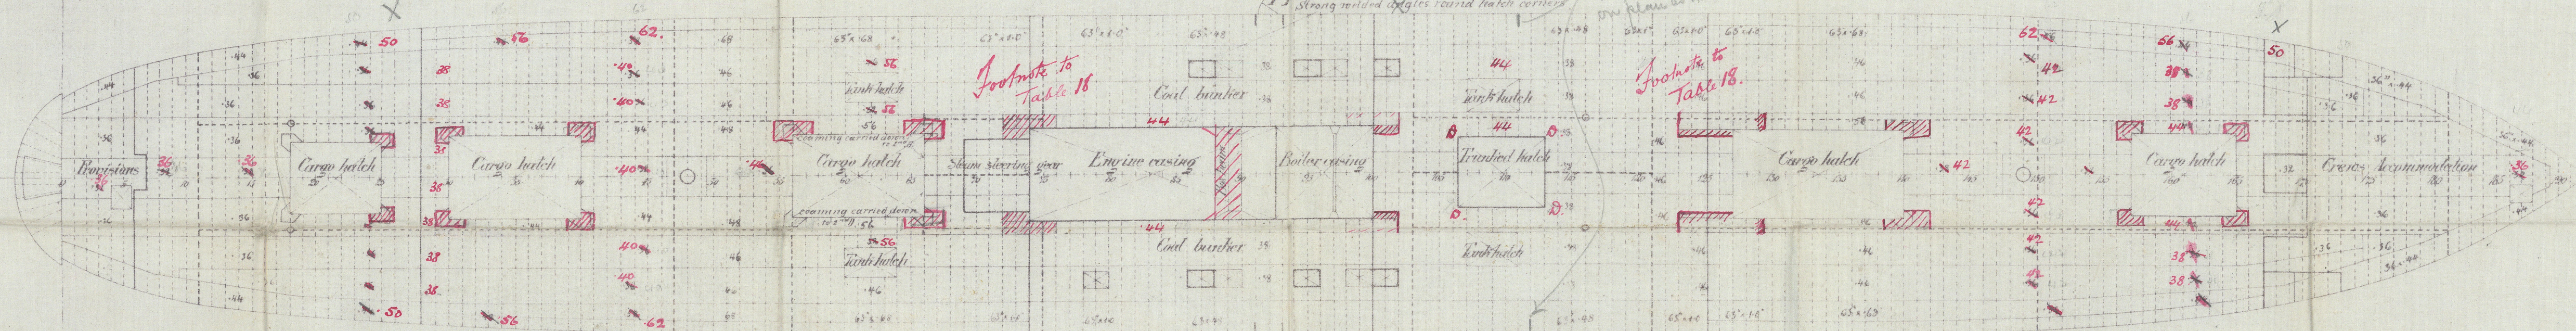

Second deck.

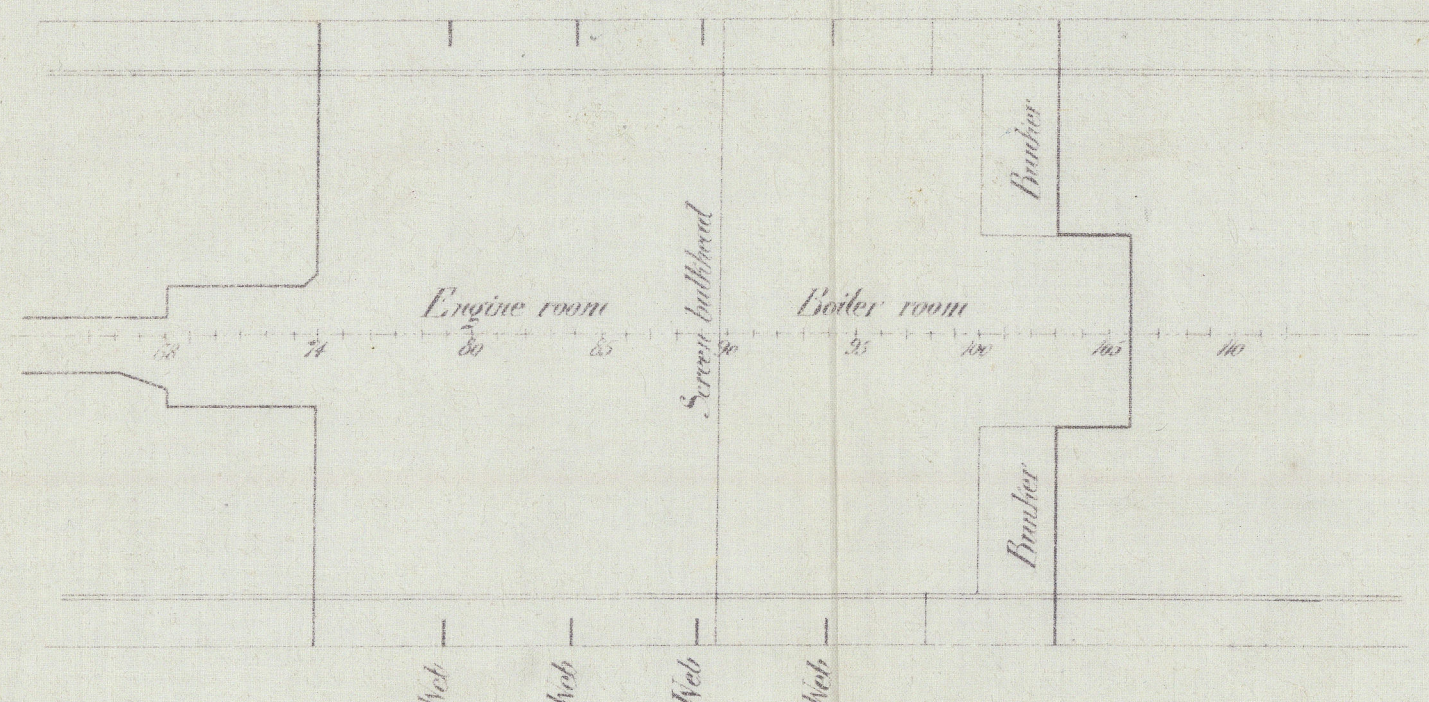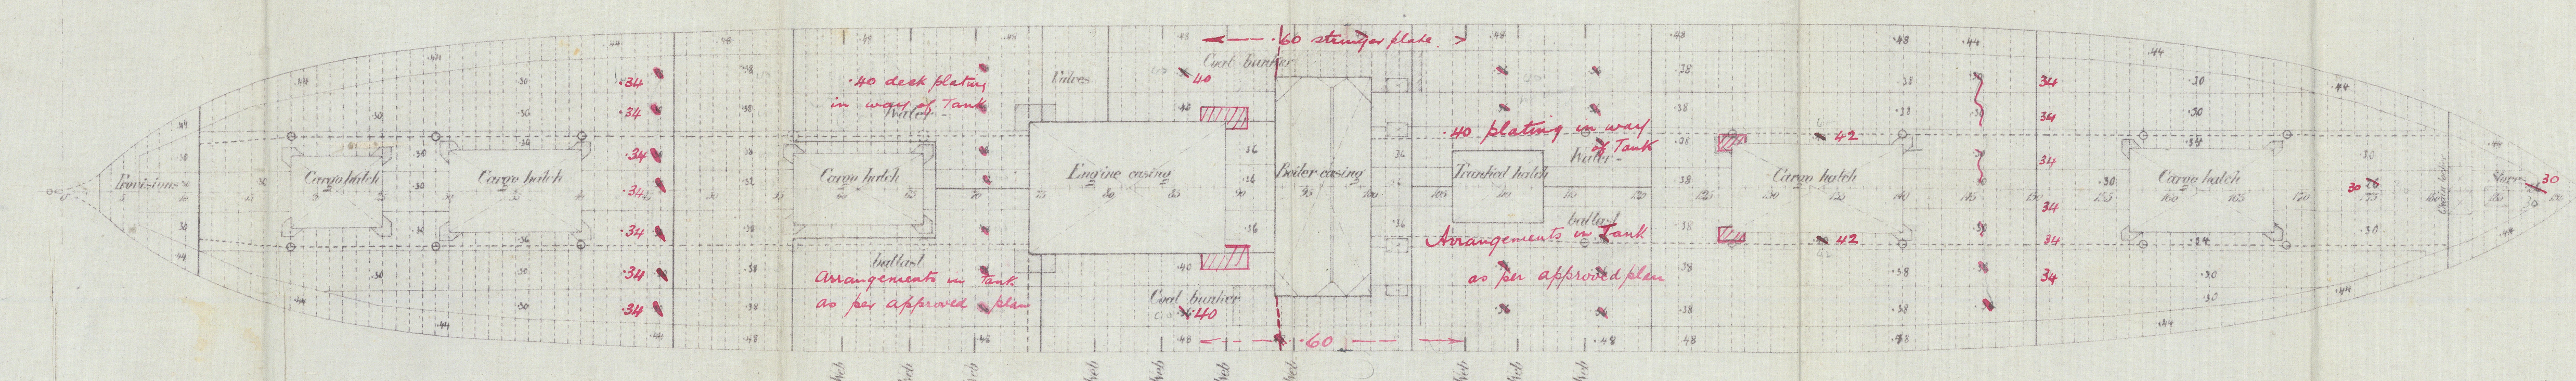

C.B.
18.9.11.

No. 42874.
JOH. C. TECKENBORG A.-G.
SCHIFFSWERFT und MASCHINENFABRIK
BREMERHAVEN-ROSTENBURG.
12.9.11.

GIUSEPPE MAZZINI



^{EX}
"Gerarchia".

Buen 176.

D-S .112.



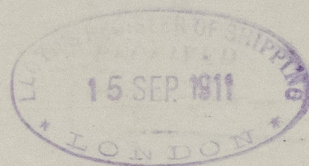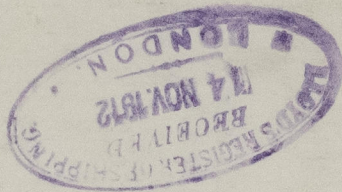

© 2021

Lloyd's Register
Foundation

004842-004848-0109

12.SEP.1911



© 2021

Lloyd's Register
Foundation