


SCALE: $\frac{1}{2}$ INCH = 1 FT.

Shaft Brackets of best forged iron.

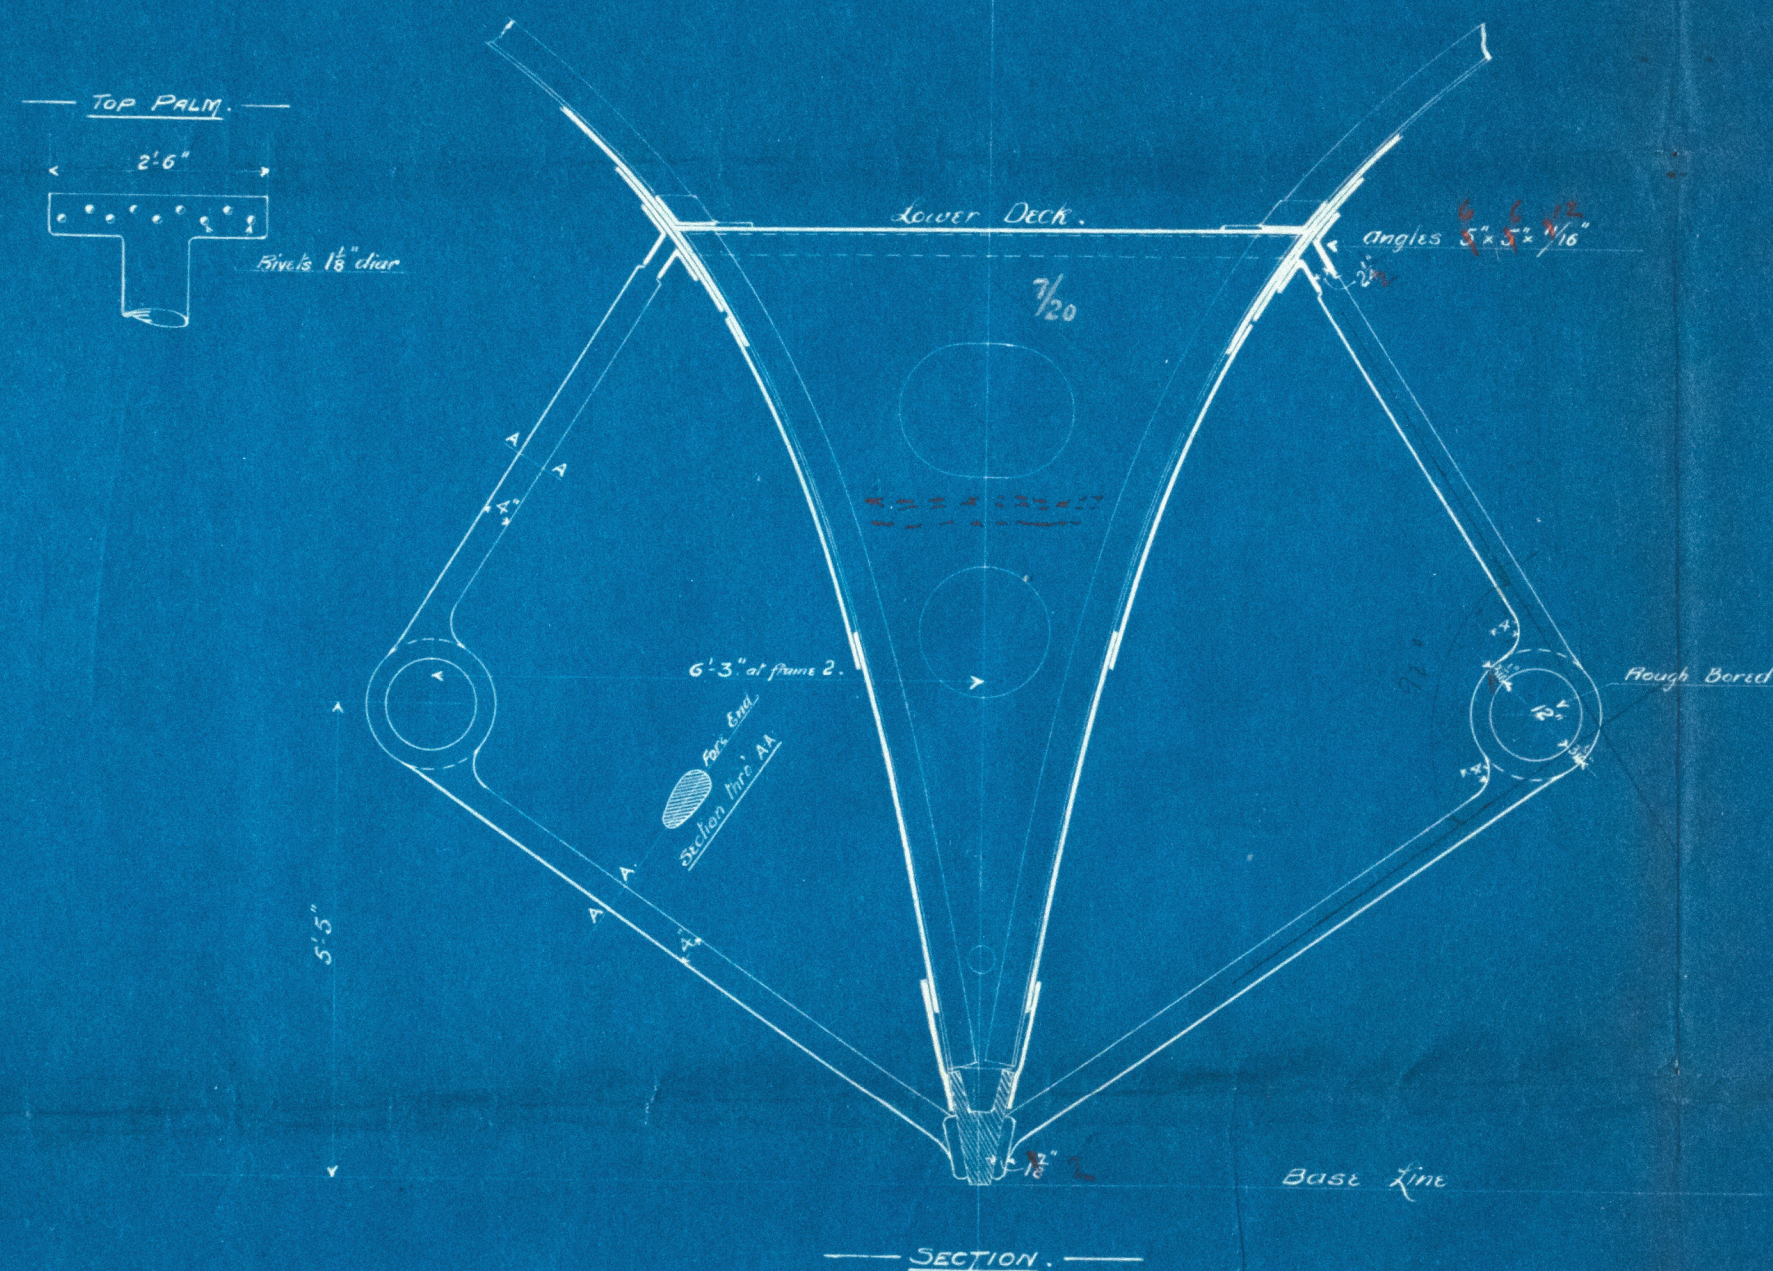

Beardmore's 49.7

Shaft Brackets

S.S. Shieldhall

19

4847

Shaft Brackets.



© 2021

Lloyd's Register
Foundation

004842-004848-0230

Thiger
Arakura 12"
Cacces
Carroo
Dredger 43.
Greville Vernon
Karnah.
Moque
Oshogbo
Regulus
Viking
Julqubar

0230



© 2021

Lloyd's Register
Foundation