




Nº 497.

T. S. SLUDGE STEAMER.

STEM · STERNPOST · & · RUDDER.

SCALE · $\frac{1}{2}$ INCH = 1 FOOT.

Stem, Sternpost, and Rudder, of best
forged scrap iron

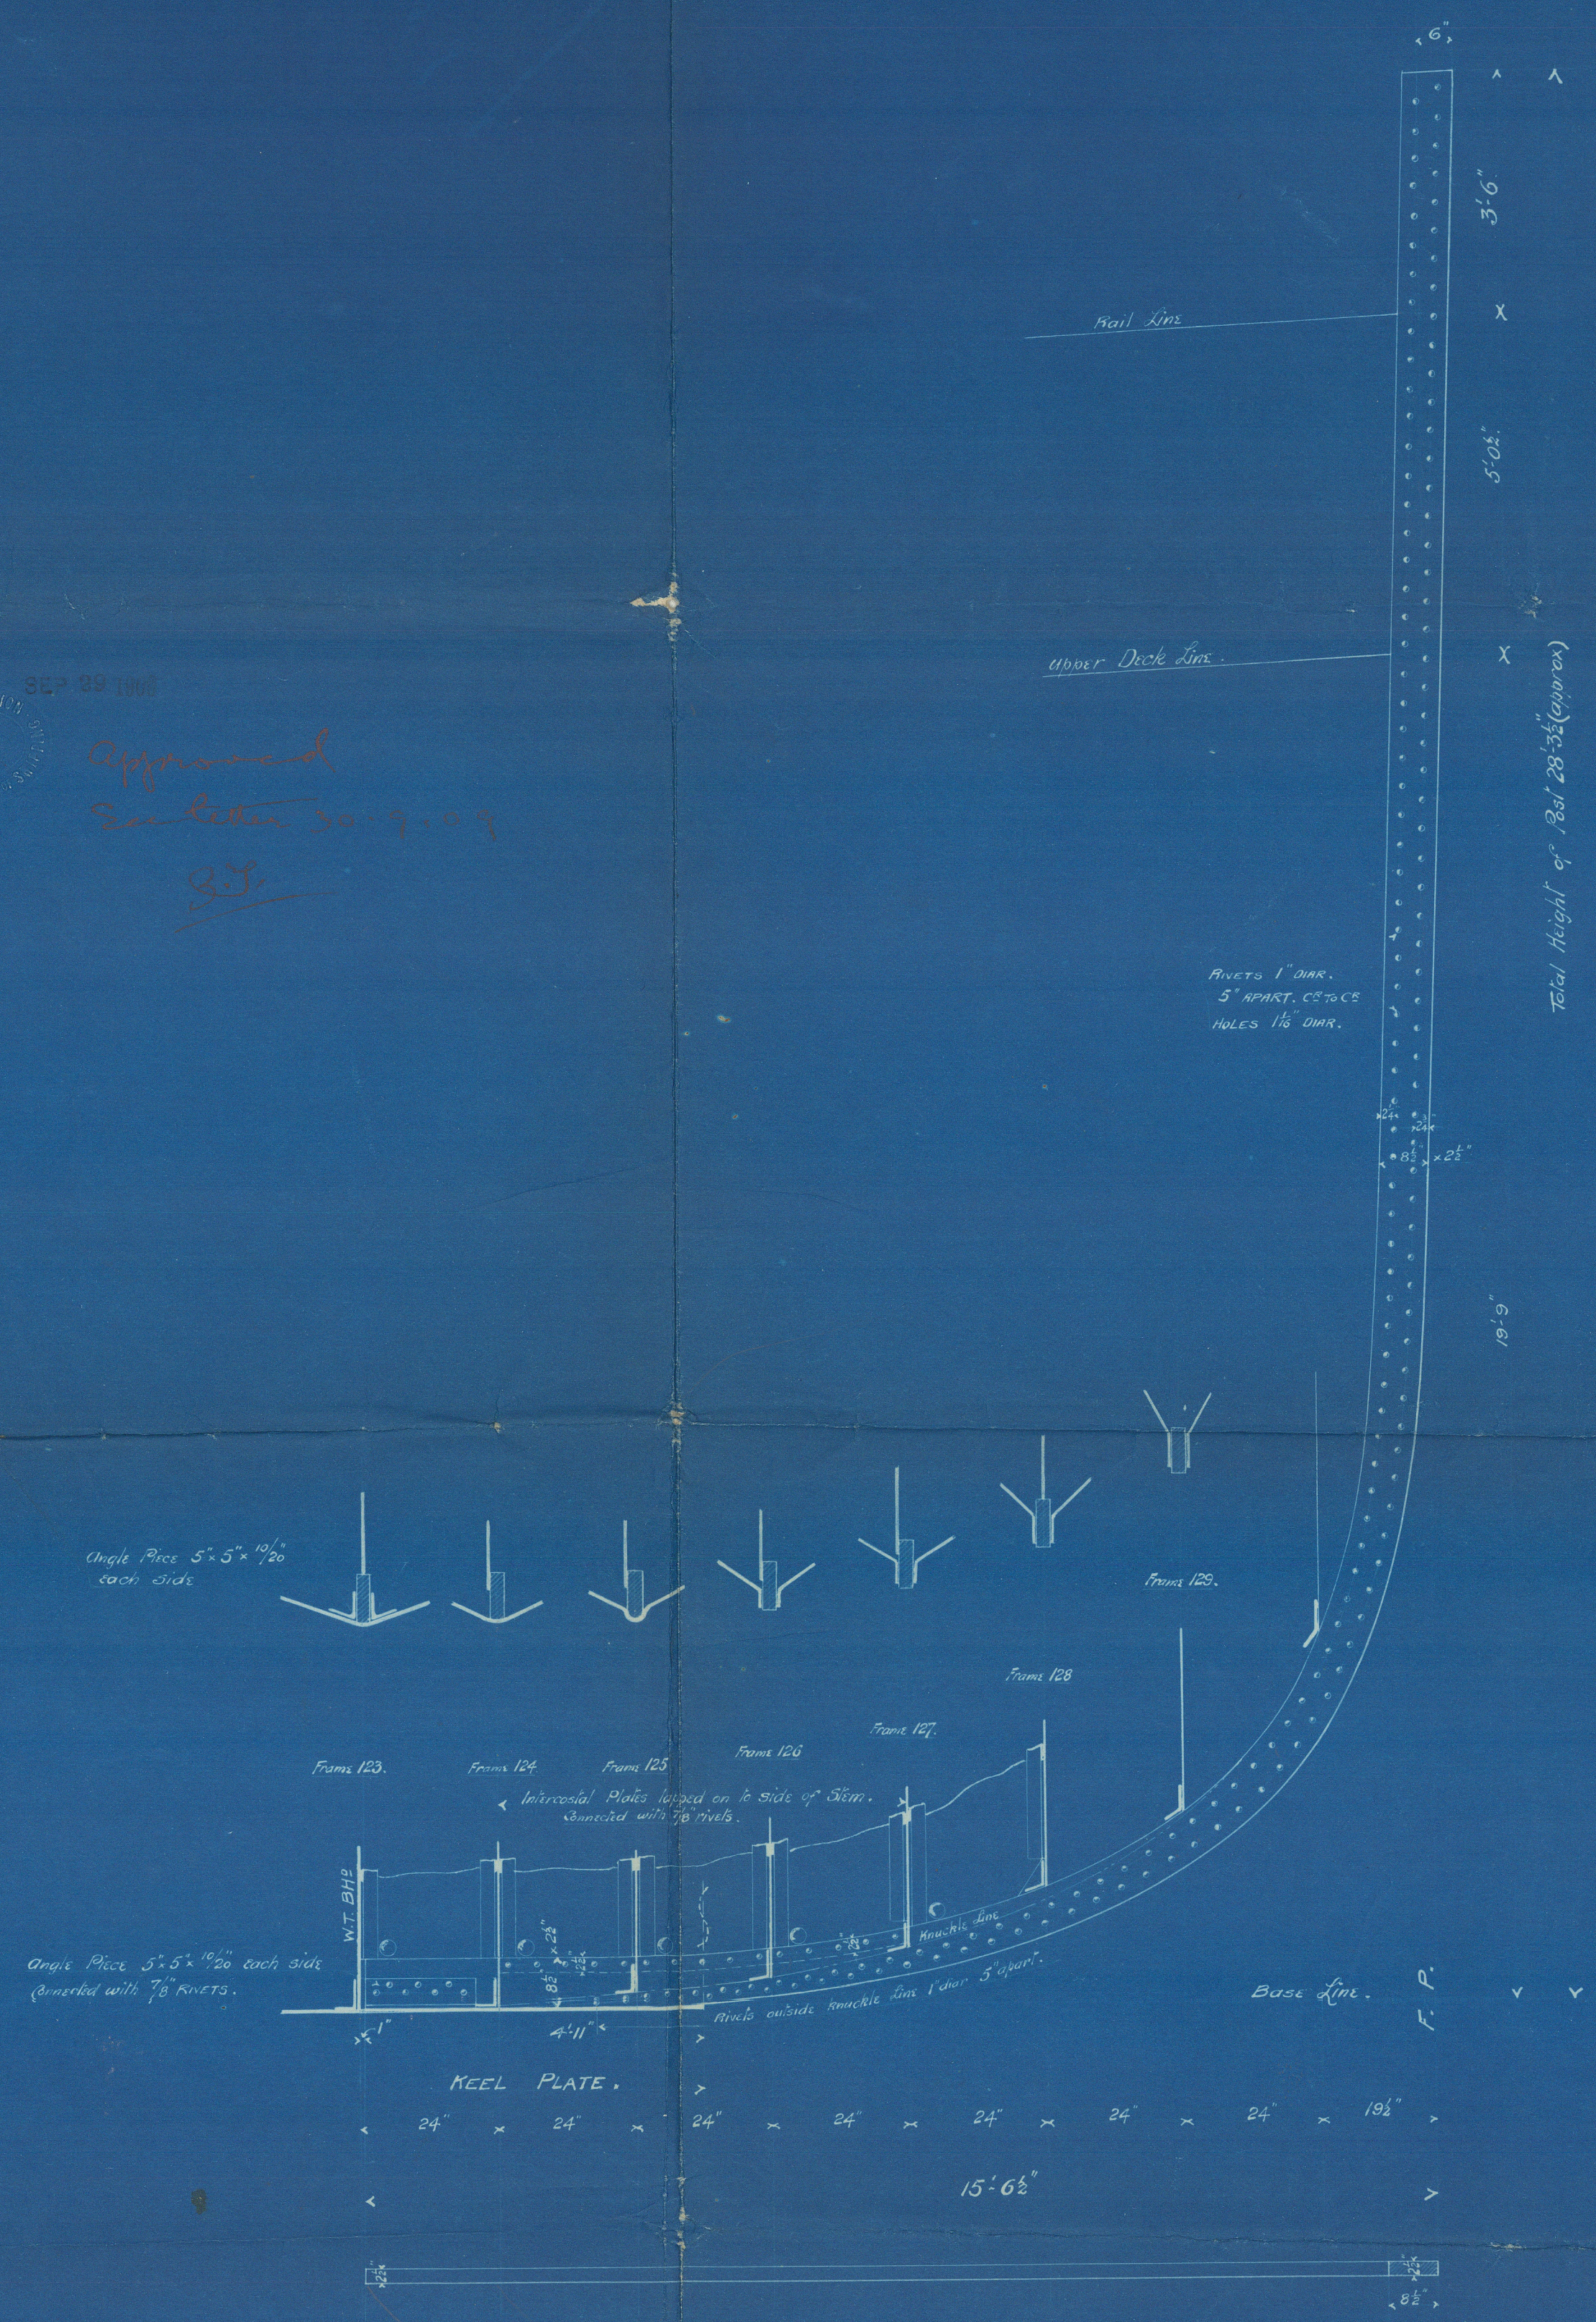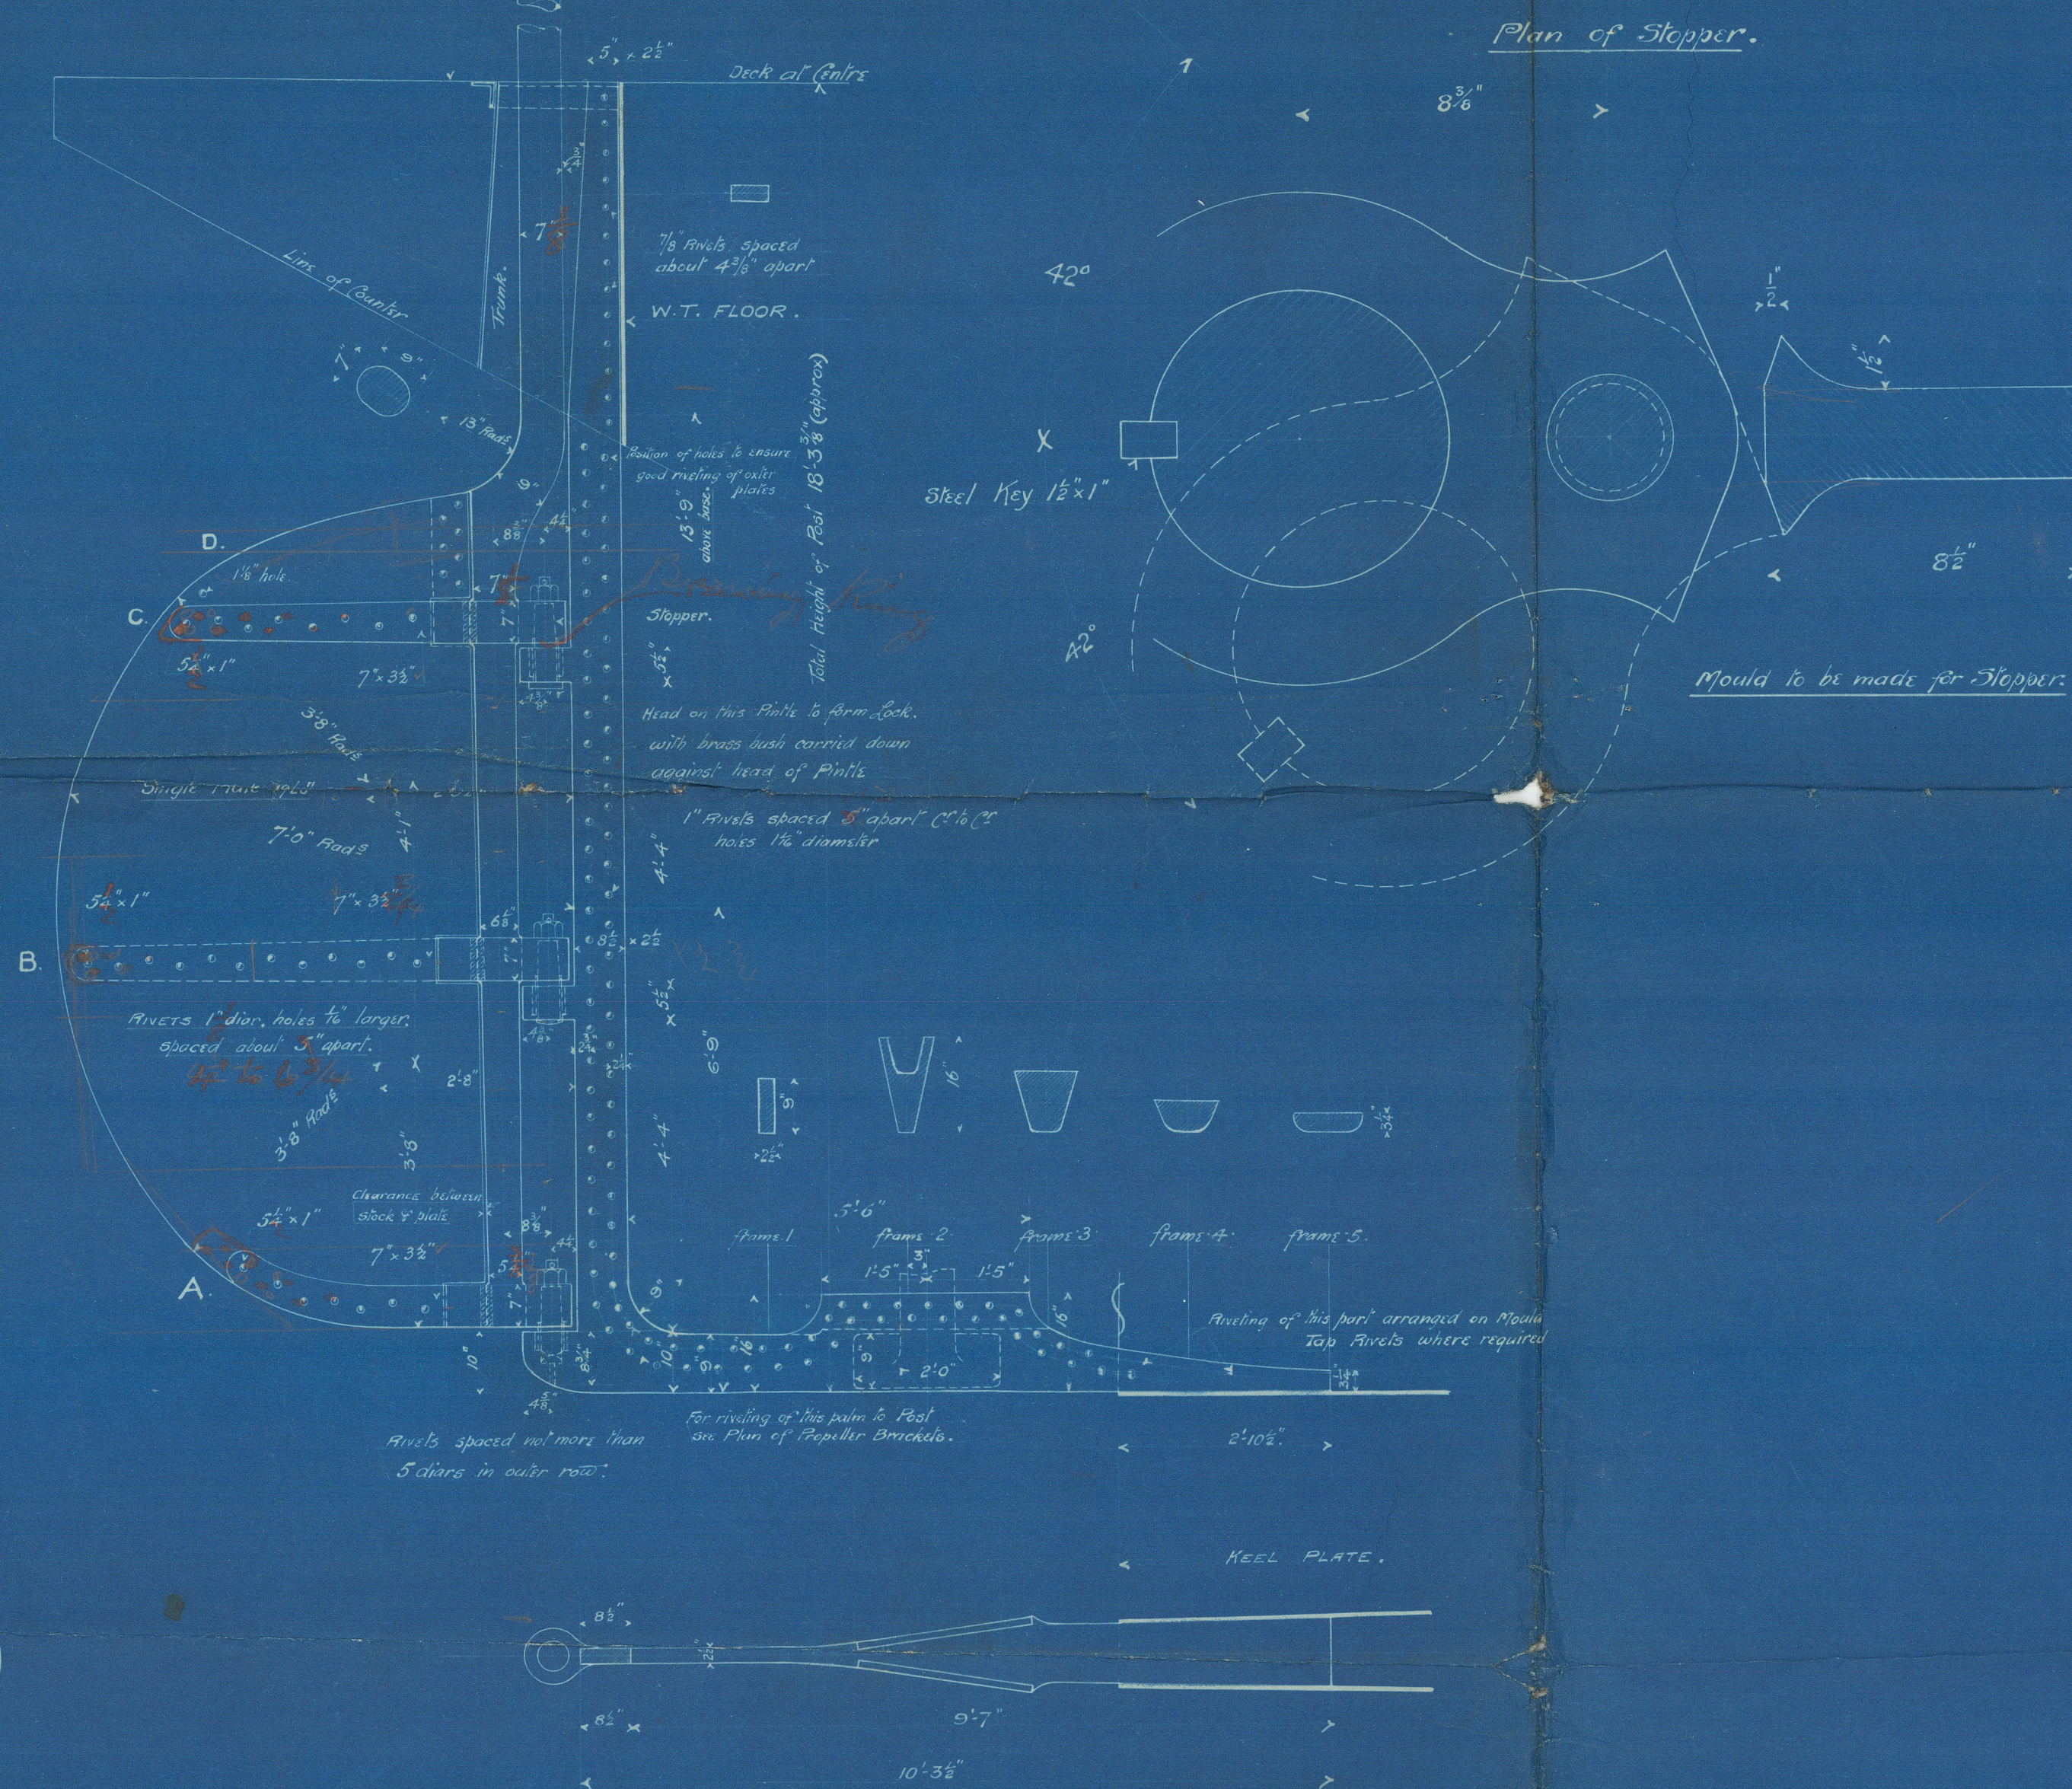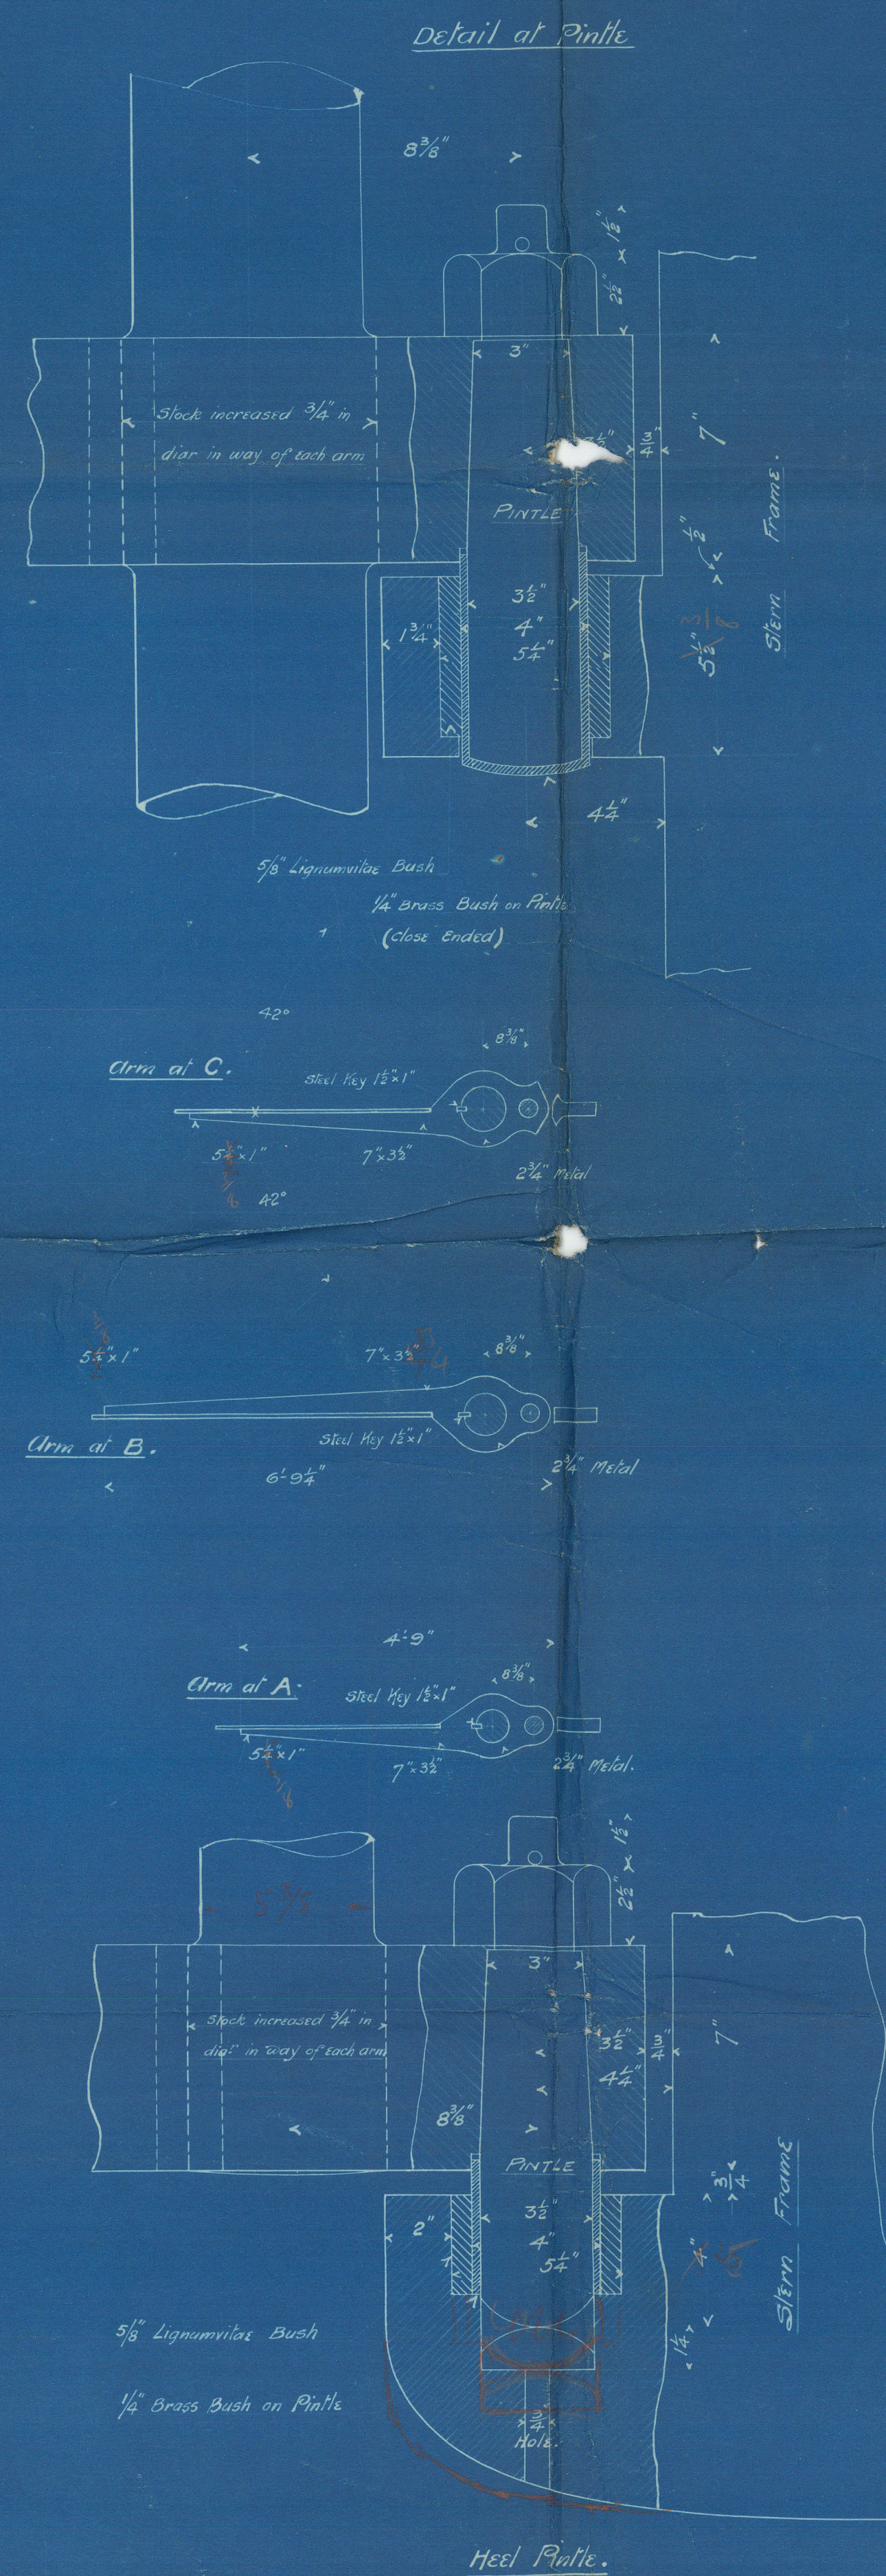

Beardmore's 497

Stem, Sternpost & Rudder

S.S. Shieldhall

6

4.125
3
24375



© 2021

Lloyd's Register
Foundation

004842-004848-0234