

250'-0" x 42'-9" x 26'-6"

1589

Form LL. 4.C. (Revised)

THE BRITISH CORPORATION REGISTER OF SHIPPING AND AIRCRAFT

SURVEY FOR FREEBOARD

STEAMER, TANKER, SAILED: "SELKIRK" S.S. WITH WITHOUT TIMBER DECK CARGO

Nationality British Builders' Name and No. of Ship Davis S.B. & R. Co. Ltd.

Port of Registry Montreal ✓ Official Number 152859 ✓ Owners Canada S.S. Lines Ltd.

Gross Tonnage 2384 ✓ Date of Build 9/1926 Port and Date of Survey Toronto, Ont. Mar 4/38

Particulars of Classification B.S. (GREAT LAKES SERVICE & RIVER ST. LAWRENCE) Name of Surveyor E. Russell Macmillan

Type of Superstructures Livercasth. Names of Sister Ships "WINNIPEG"

Trade of Ship LAKES & RIVERS

Service Endorsement if any

SPECIAL FREEBOARD R.T.O. AGREE WITH PROVISIONAL ASSIGNMENT

BEAMS O.K. FOR LIMITED GULF. ✓

Line	Position	Material	Freeboard
SUMMER FREEBOARD	recommended amidships from centre of disc to top of deck line,	steel	9'-1"
TROPICAL FRESH WATER LINE	above centre of disc		
FRESH WATER LINE	" " "	" "	
INTERMEDIATE TROPICAL LINE	" " " 5 1/2"	" "	9'-6 1/2"
WINTER LINE	below " " 11"	" "	10'-0"
WINTER NORTH ATLANTIC LINE	" " "	" "	

Line	Position	Freeboard
SUMMER TIMBER FREEBOARD	recommended amidships from top of deck line	
TROPICAL FRESH WATER	Timber line above L.S.	
FRESH WATER	" " " "	" "
TROPICAL	" " " "	" "
WINTER	" " below "	" "
WINTER NORTH ATLANTIC	" " " "	" "

Number of years recommended for load line certificate

The scantlings and protective arrangements being in accordance with the Load Line Rules it is submitted that the freeboards be assigned

Passed at a meeting of the Committee of Management of the British Corporation Register of Shipping and Aircraft

on the 3rd May 1939



© 2010

Chief Surveyor
Assistant Chief Surveyor

Lloyd's Register
Foundation
Assistant Secretary

004852-004860-0115 19

1589

LAKE COMPUTATION OF FREEBOARD

Length on summer load line 250'-0" Moulded Breadth 42'-9" Moulded Depth 26'-6" Depth of Keel
 Moulded displacement (ex bossing) at moulded draught of 85 per cent. of moulded depth Tons
 Co-efficient of fineness for use with tables $\frac{\Delta \times 35}{L \times B \times D \times .85} = .838$
 Displacement and tons per inch immersion in salt water at summer load line
 Moulded depth 26.50 Deduction for Fresh Water $\frac{\Delta}{40T} =$ inches
 Stringer Plate .42 Round of Beam Correction
 Sheathing on exposed deck T $(\frac{L-S}{L})$.035 Ships Round of Beam 10 inches
 Rise of floor (in sailers) Standard Round of Beam $\frac{B \times 12}{50} = \underline{10.26}$
 Depth for Freeboard (D) 26.535 Difference .26
 Table Depth 250/15 = 16.667 Restricted to
 Depth Correction $\frac{250}{130} \times \frac{26.535 - 16.667}{9.868} = \underline{18.98}$ Correction $\frac{\text{Difference}}{4} \times (1 - \frac{E}{L}) = .065 \times .8635 = .0601$
 If restricted by superstructures = 18.98

	Enclosed Length	Length of Overhang	Height	Mean Covered Length (S)	Height Correction	Effective Length (E)
Poop						
Raised Quarter Deck						
Bridge		F				
		A				
Forecastle	<u>34'-0"</u>	<u>3"</u>	<u>7'-6"</u>	<u>34.25</u>		<u>34.125</u>
Trunk Aft						
" Forward						
Tonnage Opening Aft						
" " Forward						
Totals				<u>34.25</u>		<u>34.125</u>

Standard Height of Superstructure 6'-0"
 " " R.Q.D.
 Percentage covered S/L = 13.70
 " " E/L = 13.65
 " from Table line A, B, (corrected for absence of forecastle if required) 6.825
 Percentage from Table by interpolation for Bridge less than .2L if required =
 Deduction = 31 x .06825 = 2.12
 Percentage from Table for Tankers (or Timber ships) =
 Deduction =

Station	Actual Sheer	Standard Sheer	Effective Sheer	S.M.	Product
A.P.	<u>27.0</u>	<u>35.0</u>	<u>27.0</u>	1	<u>27.0</u>
$\frac{1}{3}$ L from A.P.	<u>8.0</u>	<u>15.57</u>	<u>8.0</u>	4	<u>32.0</u>
$\frac{2}{3}$ L from A.P.	<u>2.5</u>	<u>3.85</u>	<u>2.5</u>	2	<u>5.0</u>
Amidships	-	-	-	4	-
$\frac{2}{3}$ L from F.P.	<u>4.5</u>	<u>7.70</u>	<u>4.5</u>	2	<u>9.0</u>
$\frac{1}{3}$ L " "	<u>15.0</u>	<u>31.15</u>	<u>15.0</u>	4	<u>60.0</u>
F.P.	<u>36.0</u>	<u>70.0</u>	<u>36.0</u>	1	<u>36.0</u>
				18	<u>169.0</u>
Effective Mean Sheer					<u>9.389</u>
Standard " " .05L + 5					<u>17.5</u>
Difference					<u>8.111</u>

Mean Actual sheer aft = less than 1.
 " Standard " "
 Mean Actual sheer forward = less than 1.
 " Standard " "
 Length of enclosed superstructure forward of amidships =
 Length of Ship
 Length of enclosed superstructure aft of amidships =
 Length of Ship
 Sheer Correction = Difference $\times (75 - \frac{S}{2L}) = 8.111 \times .6815 = 5.53$ ON
 If limited on account of midship superstructure =
 " to maximum allowance of $1\frac{1}{2}$ ins. per 100 ft. =

TABULAR FREEBOARD corrected for flush deck if required = 29.90
 Correction for co-efficient = $\frac{1.518}{1.36} = 33.37$


	+	-	
Depth correction	<u>18.98</u>		
Deduction for superstructures		<u>2.12</u>	
Sheer correction	<u>5.53</u>		
Round of Beam correction	<u>.06</u>		
Correction for thickness of deck amidships			
Other corrections, scantlings, etc.	<u>53.18</u>		
LOW COAMINGS AND TO			
AGREE WITH SERVICE DRAUGHT	<u>77.75</u>	<u>2.12</u>	<u>+75.63</u>
Summer Freeboard in inches	<u>S = 9'-1"</u>		<u>= 109.0</u>
Additional allowance for superstructures on Timber carrying ships	<u>I + 5/2 = 9'-6 1/2"</u>		
Summer Timber Freeboard in inches	<u>W + 11" = 10'-0"</u>		

DRAUGHTS AND SEASONAL CORRECTIONS

	Sailer, Tanker, Steamer	Timber
Depth to Freeboard Deck in feet	<u>26.535</u>	
Summer Freeboard in feet	<u>9.083</u>	<u>4.652</u> = MIN. FREE ^{BD}
Moulded Draught (d)	<u>17.452</u>	<u>21.883</u> (d1)
Addition for Keel	<u>.093</u>	
Extreme draught	<u>17.545</u>	
Deduction for Tropical and addition for Winter freeboard d/4 =	<u>5.47</u> ins.	
Addition for Winter North Atlantic (if required) $\frac{d}{2}$	<u>10.94</u> ins.	
Deduction for Tropical Timber Freeboard $\frac{d}{1}$		
Addition for Winter " " $\frac{d}{3}$		
" " N.A. Timber Freeboard (if required)		

MIN LAKE FREEBOARD = 55.82" THE ABOVE MARKS ASSIGNED IN ORDER TO AGREE WITH PROVISIONAL MARKS ASSIGNED

b/2 S110

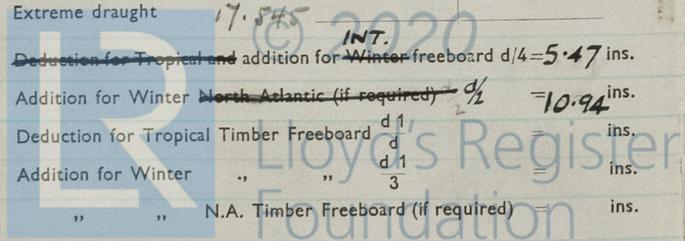

THE BRITISH CORPORATION REGISTER OF SHIPPING AND AIRCRAFT

SURVEY FOR FREEBOARD

CONDITIONS OF ASSIGNMENT

SHIPS NAME

OFFICIAL NUMBER

Nationality and Port of Registry

PARTICULARS OF SUPERSTRUCTURES, TRUNKS, CASINGS, DECKHOUSES

Particulars	Coaming	Plating	Stiffeners	Spacing	End Attachments	No. and size of Openings	Height of Sills	Height of Casings
Poop Bulkhead								
R.Q.D. "								
Bridge Aft Bulkhead								
" Forward "								
Forecastle Bulkhead								
Trunk, Aft								
" Forward								
Exposed Machinery Casings on } Freeboard or R.Q. Decks								
Exposed Machinery Casings on } superstructure decks								
Machinery Casings within Super- structures not fitted with Cl. 1. closing appliances								
Deckhouses on flush deck ships			1/4	3x2 1/2 x 3	30" overlap bars			7'6"

As originally built.

PARTICULARS OF CLOSING APPLIANCES (state if capable of being manipulated from both sides)

Poop Bulkhead	
R.Q.D. "	
Bridge Aft Bulkhead	
" Forward "	
Forecastle Bulkhead	
Exposed Machinery Casings on } Freeboard or R.Q. decks	<p><i>2 doors - 59" x 25" x 1/4 steel - 19" sill.</i></p> <p><i>Eng. Casings - inside house - 1/4 plty - Stiffers - 3x2 1/2 x 3 @ 30"</i></p> <p><i>Stokehold Ent. Pass. - Outer door - 61" x 24" x 1/4 - 16" sill. } Steel casings in</i></p> <p><i>(Inner door - frame but no door) } passage</i></p> <p><i>Eng Room Ent - One door - 60" x 23" x 1 7/8" Solid hardwood - 16" sill,</i></p> <p><i>open stairway inside - surrounded by steel casings</i></p> <p><i>No fantail entrance</i></p> <p><i>All doors open from both sides.</i></p>
Exposed Machinery Casings on } superstructure decks	
Machinery Casings within super- structures not fitted with Cl. 1 Closing Appliances	
Deck houses on Flush Deck ships	

fit plate on door

PARTICULARS OF FREEING ARRANGEMENTS

Particulars	Length of Bulwark	Height of Bulwark	No. and size of Freeing Ports each side	Area each side	Rule Area
After Well			36" Bulwark in way of deckhouse aft		
Forward Well			- open rails elsewhere.		


State fore and aft position and height above deck to bottom of port, for each port

} After Well

} Forward Well

State whether freeing ports are fitted with shutters, bars or rails, and give particulars


Give particulars of freeing port area, etc., on superstructure decks

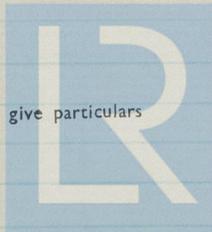


© 2020

Lloyd's Register Foundation


Position and dimensions of superstructure decks, position of superstructure bulkheads and openings, extent and thickness of wood sheathing in wells, position of cargo and coaling hatchways, gangway, cargo and coaling ports, freeing ports, ventilators to spaces below freeboard deck and fully enclosed superstructures, companionways, etc., which affect the freeboard of the ship.

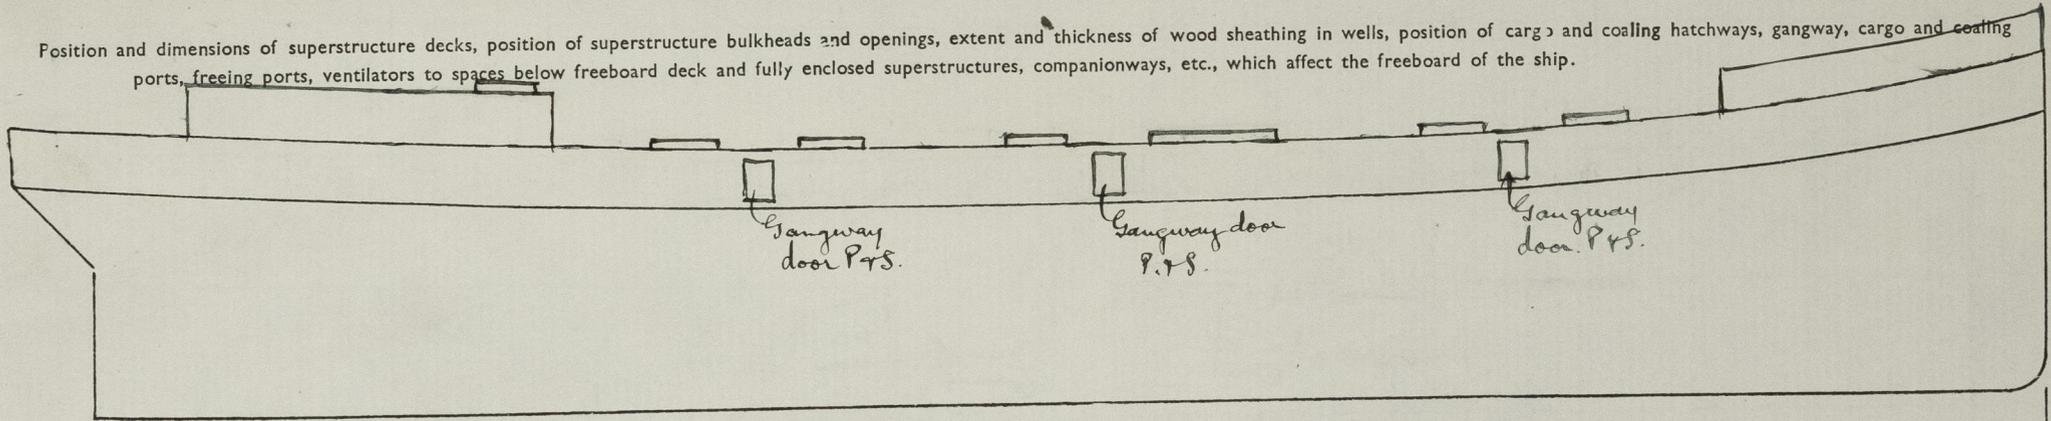

Superstructure Deck

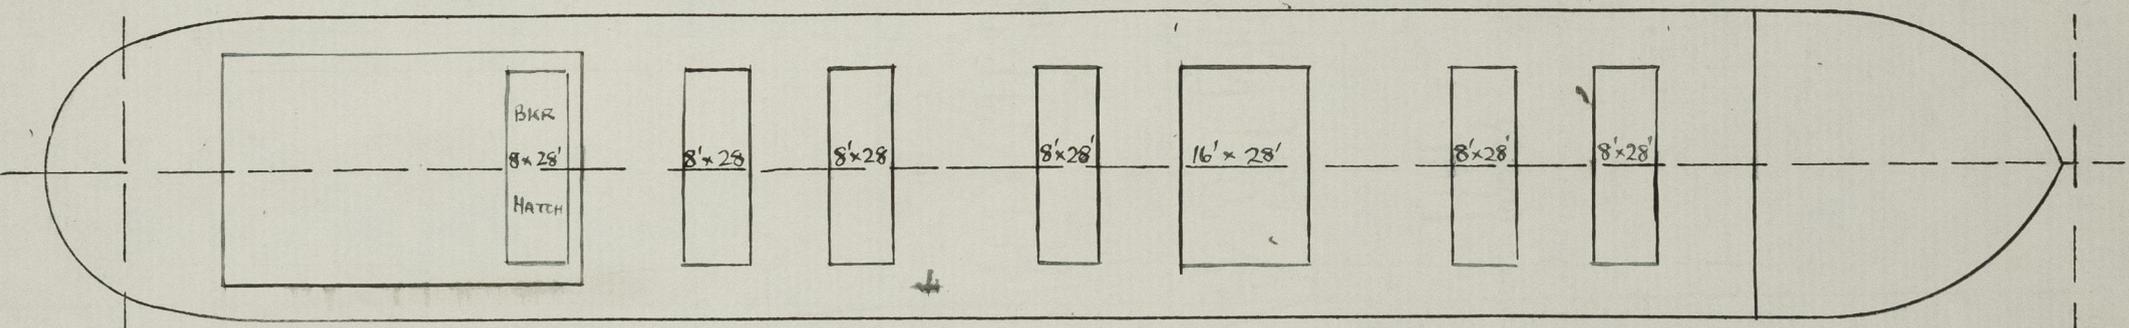

Freeboard Deck

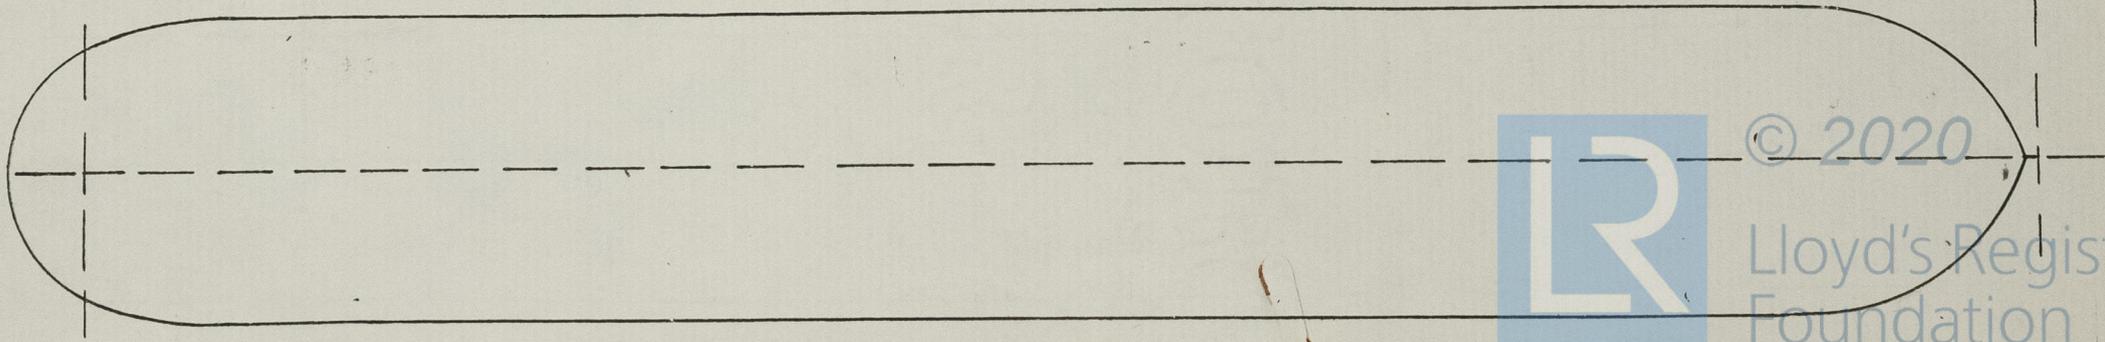

© 2020

Lloyd's Register Foundation

*Office*January 31, 1939.S.S. "SELKIRK"

Freeboard same as provisionally assigned. ✓

Door at engine room entrance to be plated over. ✓

Lifelines to be fitted. ✓




© 2020

Lloyd's Register
Foundation

PARTICULARS OF ALL HATCHWAYS ON FREEBOARD AND SUPERSTRUCTURE DECKS

	← upper deck →				
Number and description of Hatchway from forward	1, 2, 4, 5 & 6	3		On Deckhouse top-front end	
Dimensions of Hatchway	8' x 28'	16' x 28'		8' x 28'	
COAMINGS	Height { steel above } { deck wood }	9"	12"	9"	no exposed deck scuttle hatches.
	Thickness { sides ends }	9 x 3" BA	12 x 3 1/2" BA.	9 x 3 1/2" BA.	
	Stiffeners	none	none.	none	
	Brackets or Stays	none	none	none.	
HATCH BEAMS	Number	1	filled for 3 thwartship beams.	none.	
	Spacing	8' 0"			
	Scantling and Sketch	8" x 6 1/2" wood			
	Bearing Surface and thickness of carriers or sockets	3 1/2 x 3 1/2 x 1/2 + 7 x 3 1/2 x 1/2			
FORE AND AFTERS	Number	2.	none.		
	Spacing	9' 4"			
	Unsupported lengths				
	Scantling and Sketch	7 1/2" x 3 x 3 x 1/4 - 15" x 3/8			
Bearing Surface and thickness of carriers or sockets	3 1/2 x 3 1/2 x 1/2	3 1/2 x 3 1/2 x 1/2			
HATCH COVERS	Material	Wood	As. 1	Wood	Securing bars - 3 1/2 x 3/8 flats - One on Nos 1, 2, 5 & 6 Two " No 3. None on No 4 (Elevator hatch)
	Thickness	2 3/4"	"	2 3/4"	
	How Fitted	F & A	"	F & A.	
	Bearing Surface	3"	"	3"	
Spacing of Cleats	27"	"	"	26"	
Number of Tarpaulins	two	"	"	two	
Are tarpaulins in good condition and in accordance with rule requirements?	Yes			Are wood fore and afters steel shod at all bearing surfaces?	Yes.
Are lashings provided in accordance with rule requirements?	Securing bars fitted.			Are battens and wedges efficient and in good condition?	Yes.

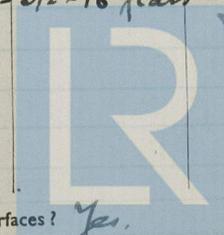

Lloyd's Register Foundation

Give full particulars of the following:—

Fiddley, Funnel and Vent Coamings, Engine Room skylight and other openings ^{on deck house} in Machinery Casings top and their means of closing (state height of coamings, type of fiddley covers, and if these are permanently attached in their proper positions)

Fiddleys - 3" Coamings - hinged steel covers.

Funnel - riveted to plating - no coaming

Eng. Vents have high coamings

Eng. Room skylight - steel

Bunker hatch (abaft funnel) - 9" B.A. coaming; 2 3/4" wood covers, 14ft long
Cleats @ 24" - 3 1/2" x 3/8" flat - securing bar.

Flush Bunker Scuttles on freeboard and superstructure decks (state material, type of joints, etc., and if secured by hinge or permanent chain attachment)

None

Companionways on freeboard and superstructure decks (state material, height of doorway sills, type of doors, and if these can be closed and secured from both sides)

None.

Windlass inside forecastle - steel plates are fitted for inboard ends of hawse pipes.

Ventilators in exposed positions on freeboard, raised quarter and superstructure decks to spaces below freeboard decks and fully enclosed superstructures enclosed by Class 1 appliances (state height of steel coamings, pitch of rivets in deck connection, type of closing arrangements)

4 Forecastle deck - 6" S.D.M. Vents.

Airpipes in exposed positions on freeboard, raised quarter and superstructure decks (state height to opening and if satisfactory closing arrangements are provided)

4 Fore deck - none.



© 2020

Lloyd's Register
Foundation

Scuppers and Sanitary Discharge Pipes (state material, type and number of valves)

Discharges forward (from forecandle)

In store - W.C. discharge starboard - clapper valve on outlet
" " - Scupper from windlass room - short pipe - no valve
In Tween decks - Port - 1 W.C. & 1 drain - clapper valves on outlets.
" " " - 1 drain - outlet 4" below freeboard deck - no valve
" " - Star - 1 drain - clapper valve on outlet.

Discharges aft - (from deck house)

In machinery space - W.C.'s, drains etc - outlets have clapper valves.
except 1 drain Port side Eng. room - outlet 18" below freeboard deck - no valve.

Ashtray - hinged cover on hopper; hinged flap with cover, on outlet.

Side Scuttles to spaces below freeboard and superstructure decks (state type or pattern, and if permanent or portable deadlights are supplied)

Forecastle side scuttles have hinged metal covers.
Forecastle bulkhead - " " " "
Engine Room - no side scuttles.

Vertical distance of sill of lowest side scuttle below top of freeboard deck at side amidships

Guard Rails on freeboard and superstructure decks (state type and where fitted)

Open rails - 2 tier rod (or wire) forward of bulwark aft -
on freeboard deck - portable in way of hatches.

Gangways and Lifelines

Lifelines to be fitted?

Gangway, Cargo and Coaling Ports in sides of ship

Gangway door - P.S. - in Engine Room - good
strong W.T. doors as originally fitted.

Cargo doors - in tween decks - 3 each side, as
originally fitted.

© 2020
Lloyd's Register
Foundation

SUPPLEMENTARY REQUIREMENTS FOR STEAMER CARRYING TIMBER DECK CARGOES

Do Superstructure and Machinery Casings comply with rules?

Is provision made for protection of steering gear?

Is emergency steering gear provided?

Are efficient sockets and eyes for lashings provided and properly spaced?

State particulars of longitudinal subdivision in double bottom

State particulars of Bulwarks and Rails

Particulars of any Special Features in the construction of the Ship

Endorsement at first survey and at surveys for Renewal of Certificate:—

The fittings and appliances are in accordance with the particulars shown in the form and are in good condition



© 2020

Lloyd's Register
Foundation

0115 919