

S.S. No 319



PLAN OF RUDDER.

SCALE $\frac{1}{2}$ -1 FOOT.

NOTE! RIVET HOLES IN RUDDER $\frac{3}{16}$ DIA SPACED
5' APART, CENTRE TO CENTRE
HOLES TO BE COUNTERSUNK.





FORGING

ROBT THOMPSON & SONS LTD
SHIPBUILDERS
SOUTHWICK YARD
SUNDERLAND
28/2/23

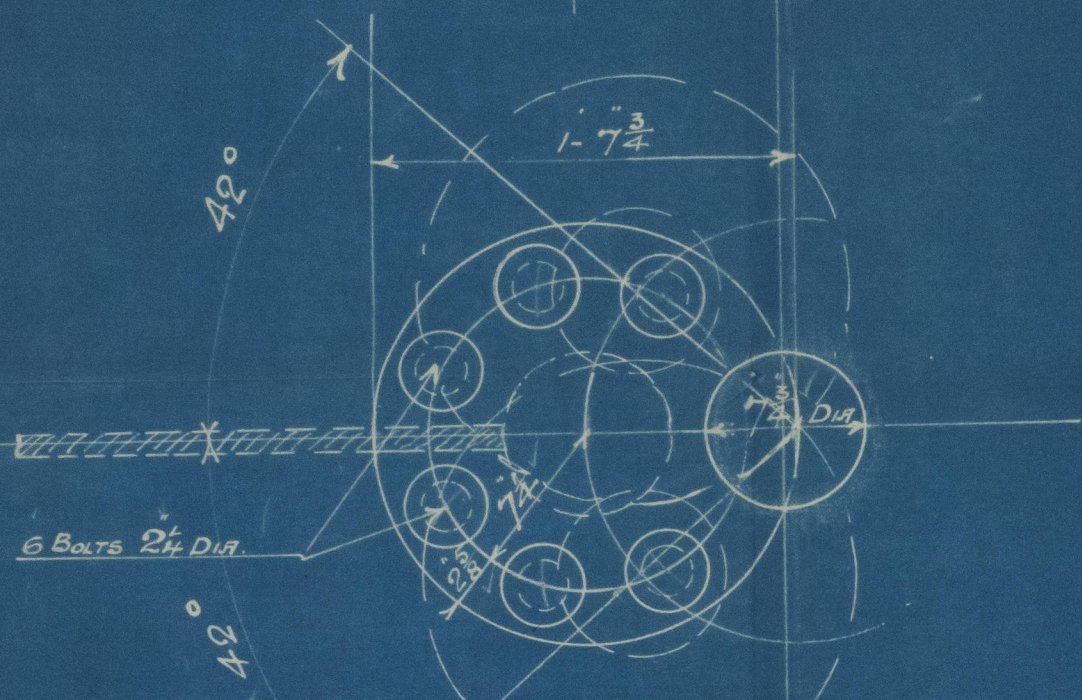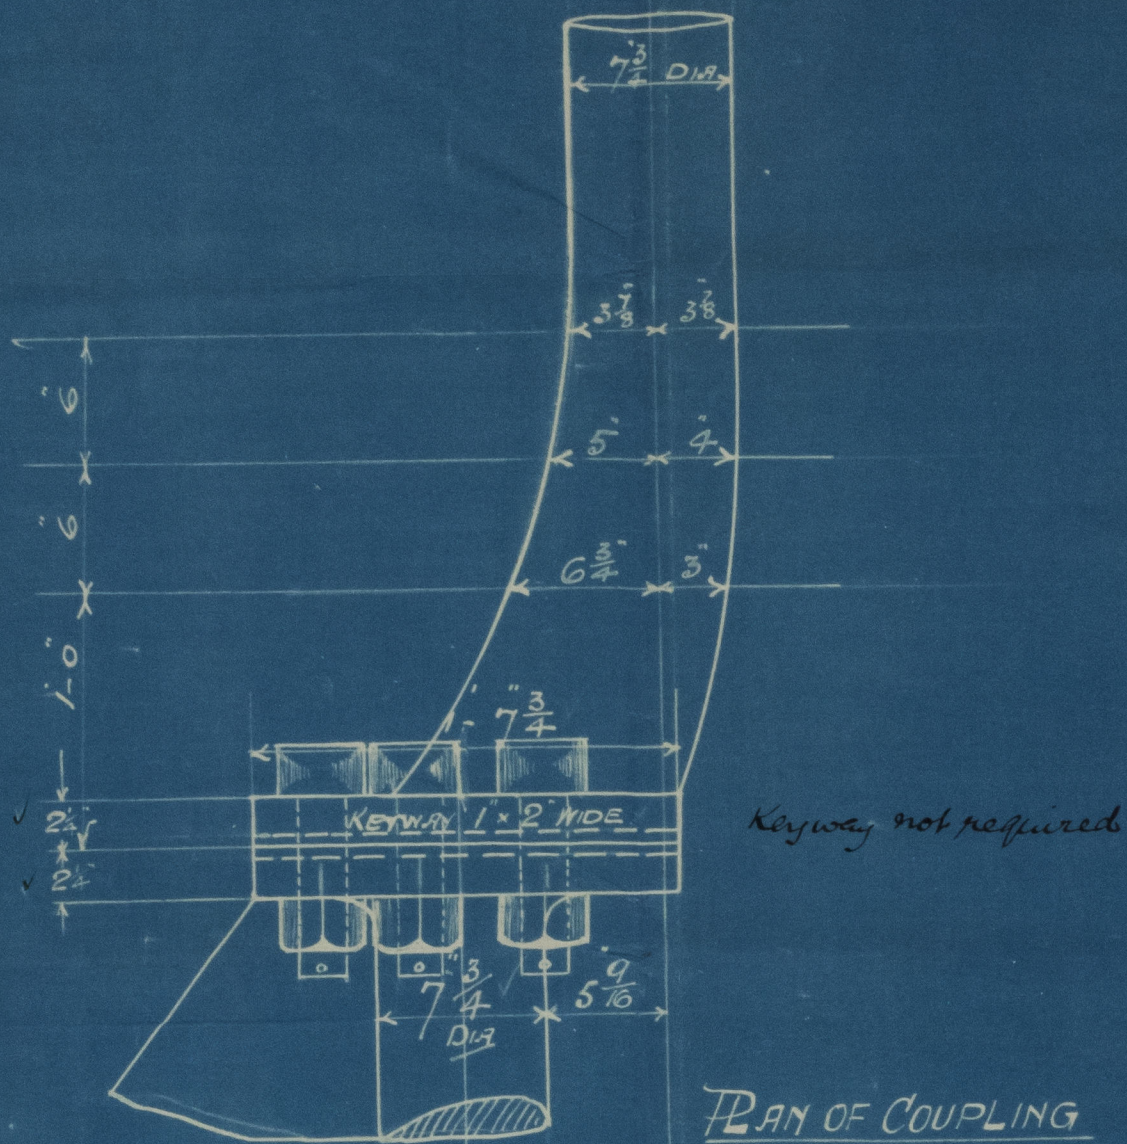

TOTAL AREA OF RUDDER ABRAFT 94.6
FORWARD EDGE OF MAIN PIECE 75.0
DISTANCE OF CENTRE OF GRAVITY ABRAFT
CENTRE LINE OF PINTLES 2.95 FEET
SPEED OF SHIP = 9 1/2 KNOTS.

$$A \times D = 279 = 7 1/4 \text{ dia}$$

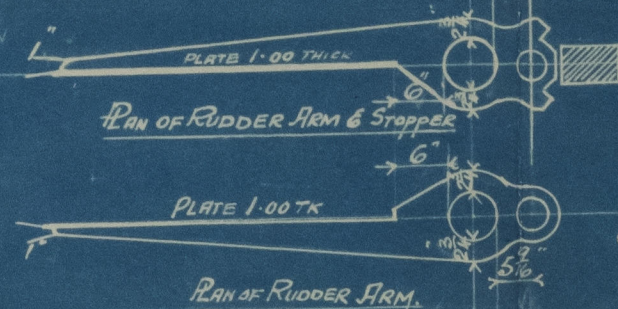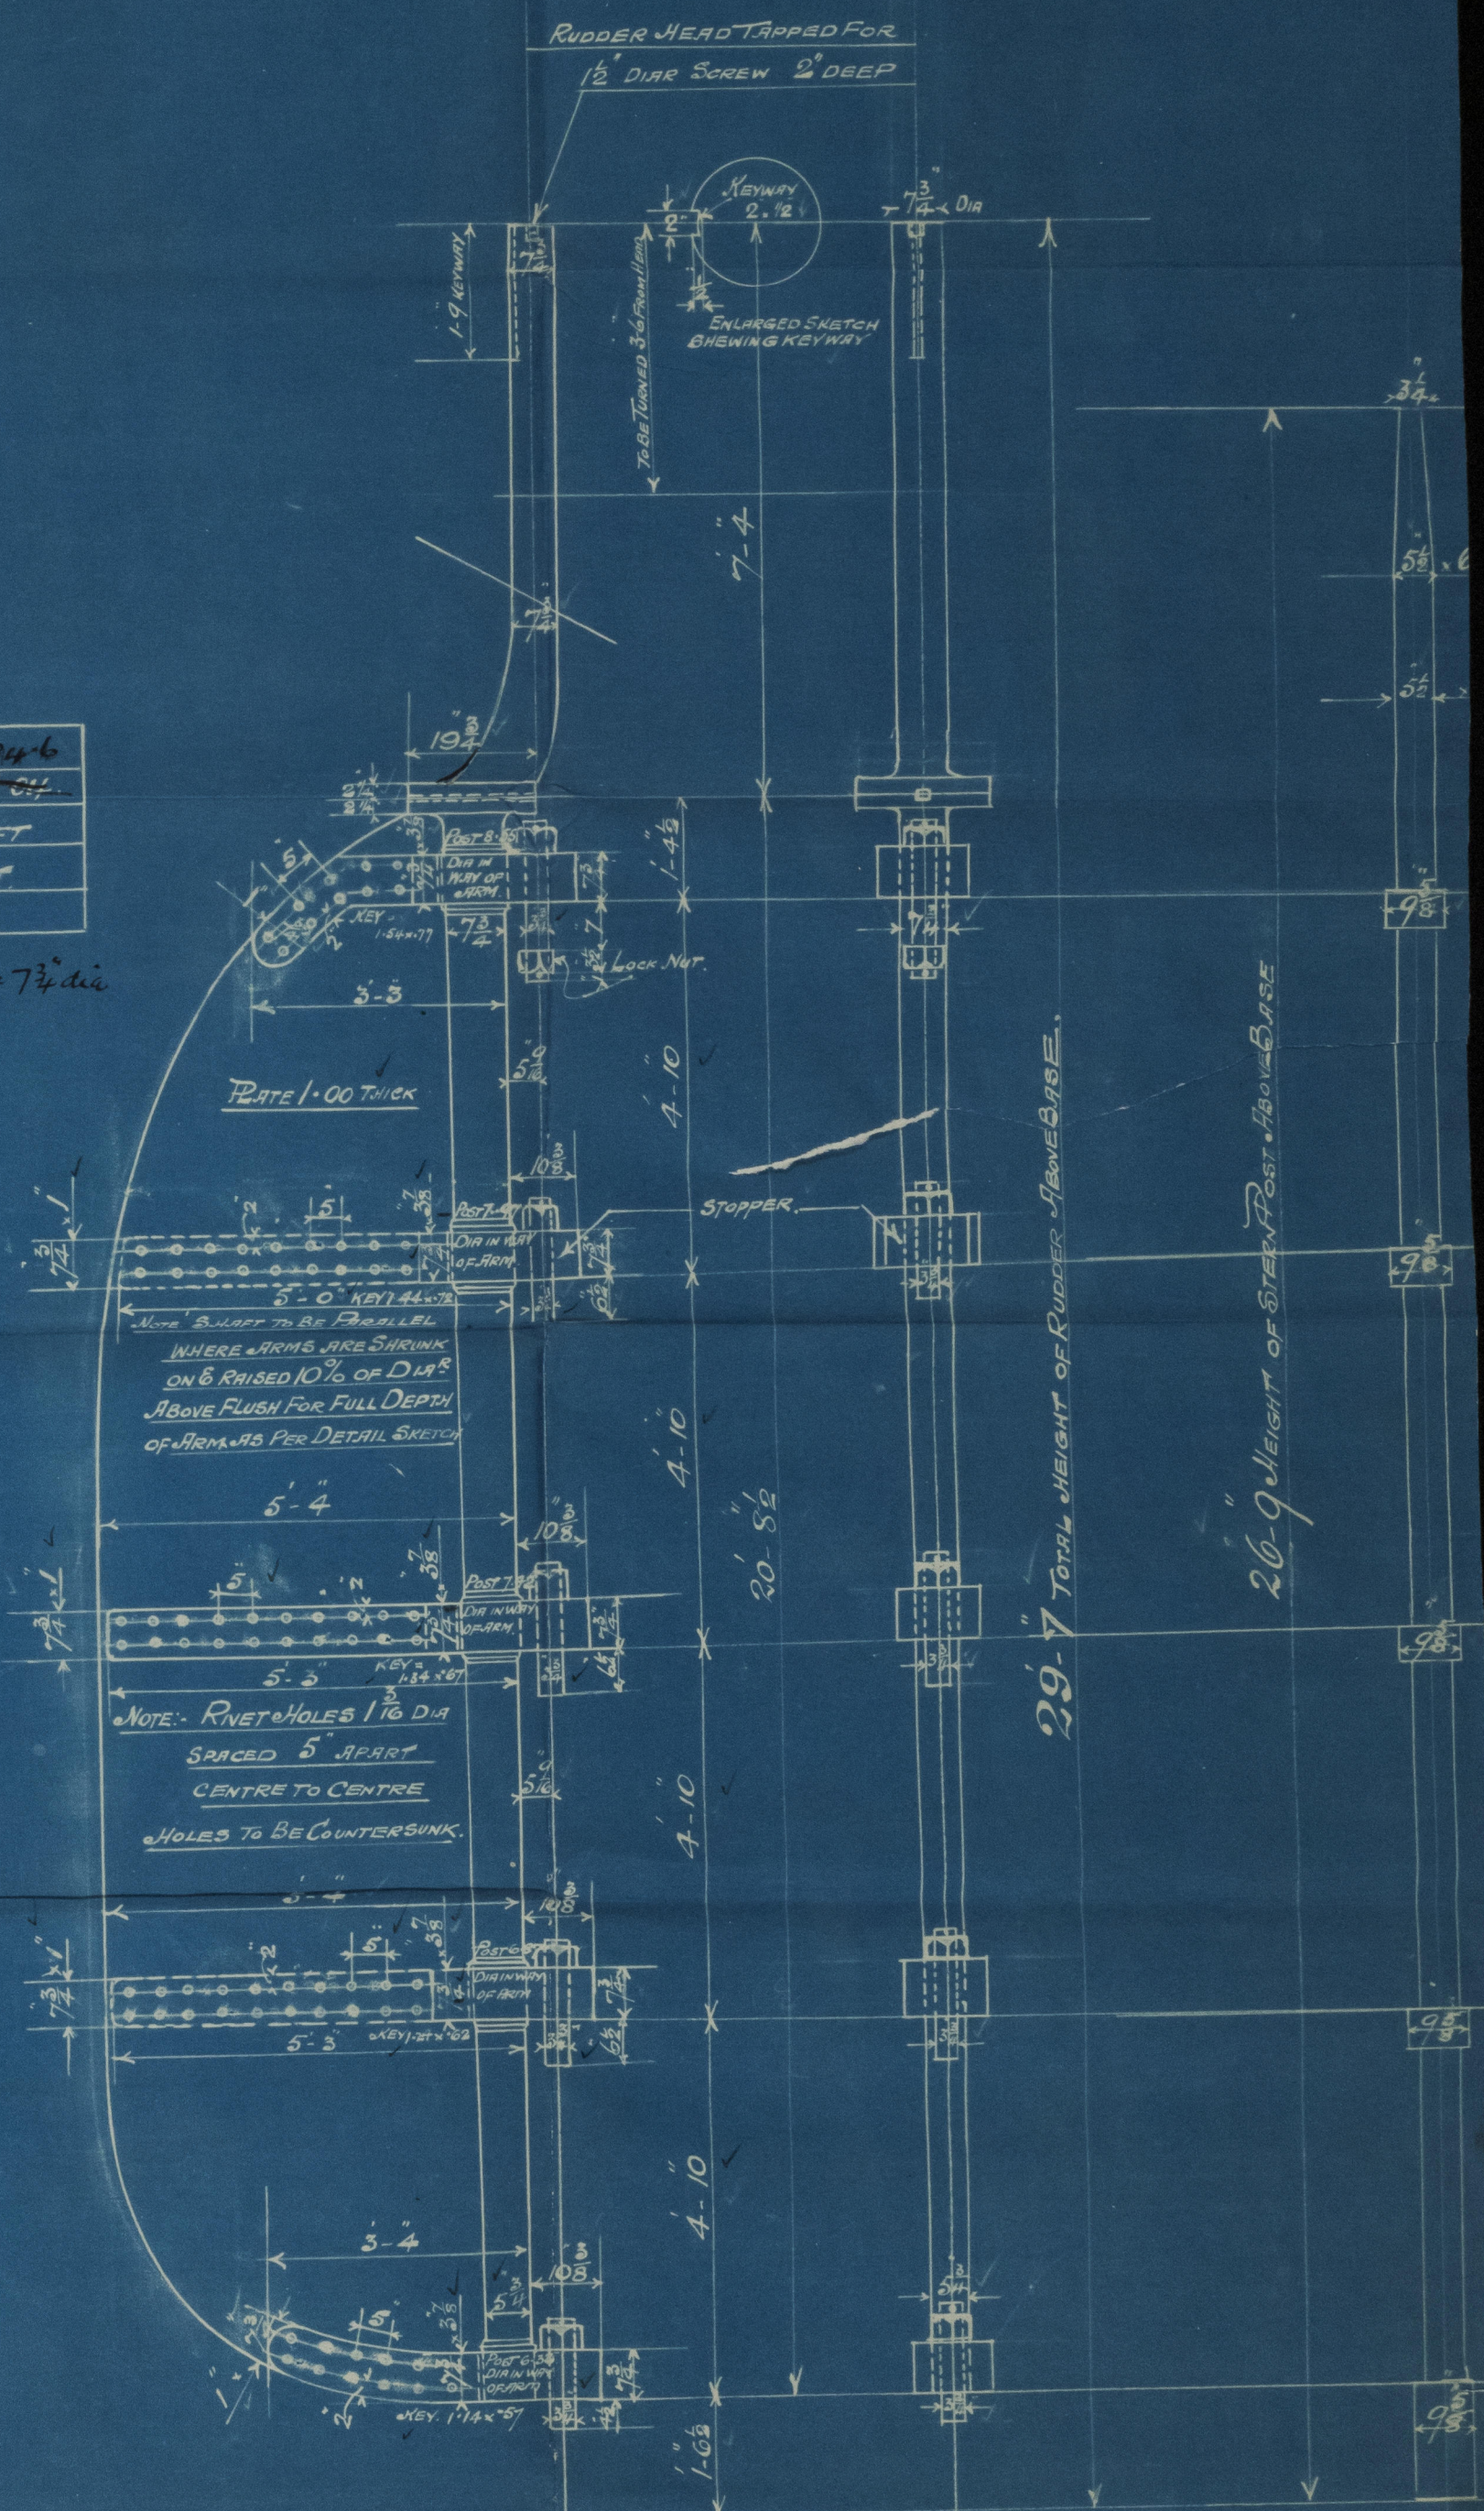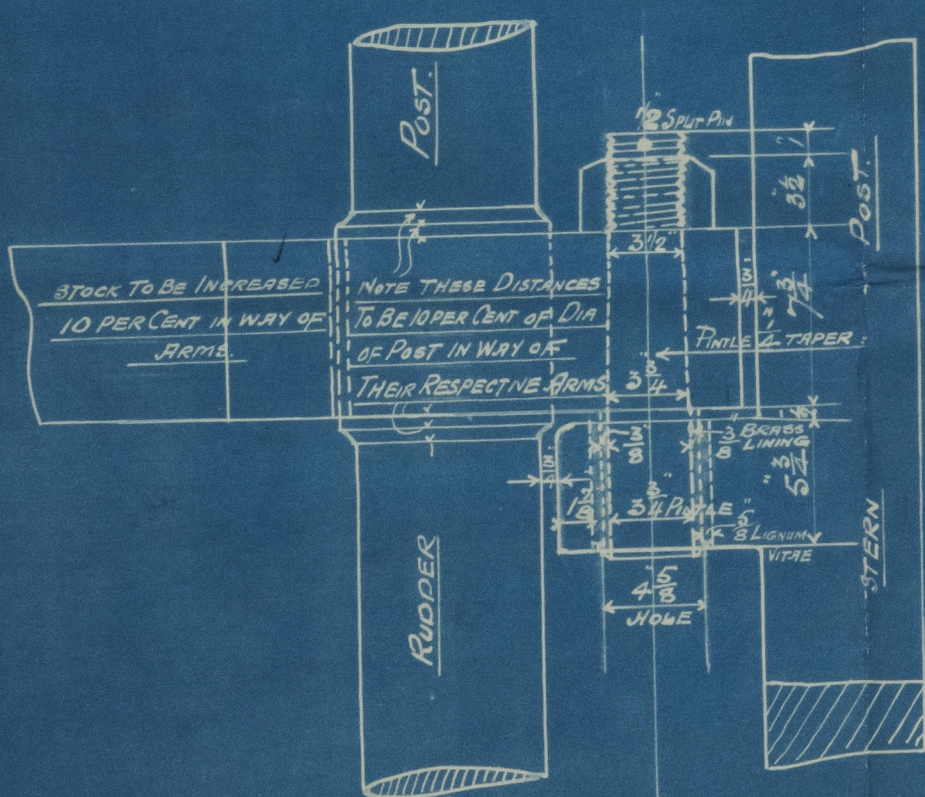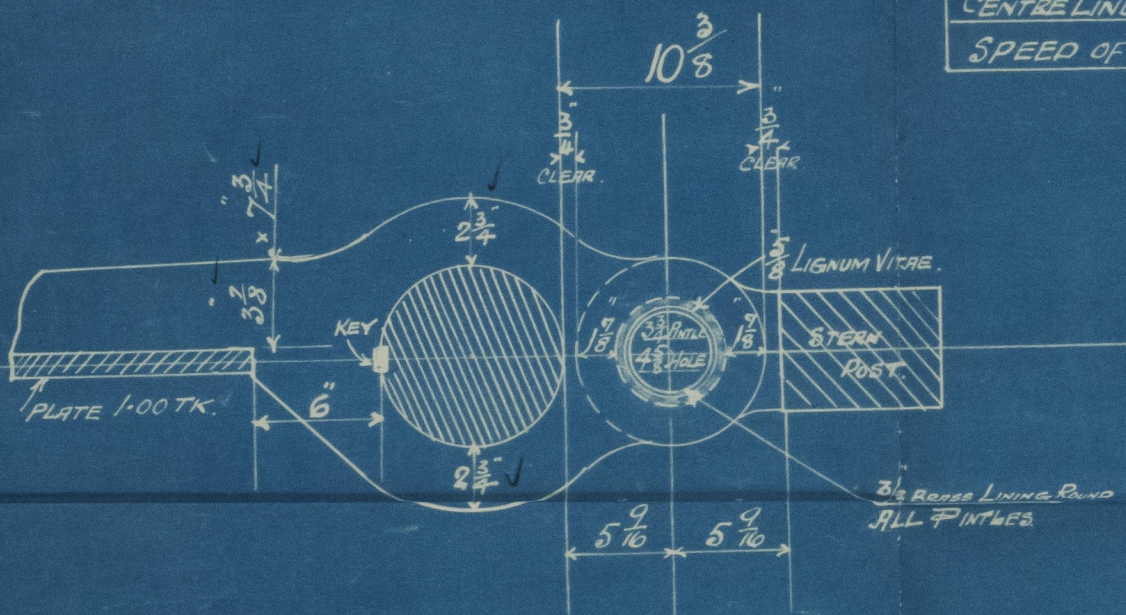

SHIPS NO	319
PLAN NO	9
DRAWN BY	TINB
DATE	23/1/23

SKETCH OF GUDGEON & PINTLE
SCALE 1/2 ONE FOOT.



004852 004260-0121

Sunderland

Robt. Thompson Sons Ltd

Nº 319

RUDDER PLAN.

S.S. GWENTLAND

SUNDERLAND REG. NO. 28617



© 2020

Lloyd's Register
Foundation

004852-004860-0121