Copy.

Rpt. C. 11 (Contd.)

Index No. 31202

Lloyd's Register of Shipping.

11 SEP 1941

Ship's Name Port Dunedin Official No. 148599

Memorandum of alterations reported since ship was surveyed for assignment of Load Lines

in Swansea.

Now done with a view to reversion of freeboards.

Freeing ports in tonnage well closed by means of welded plates. Tonnage opening in shelter deck closed by means of wood hatch covers bolted to rest bars (2 bolts to each cover) and caulked. Steel plates screwed to top of hatch covers. Beam fitted at mid length of tonnage opening

Dimensions of Forecastle as given below

* Present dimensions

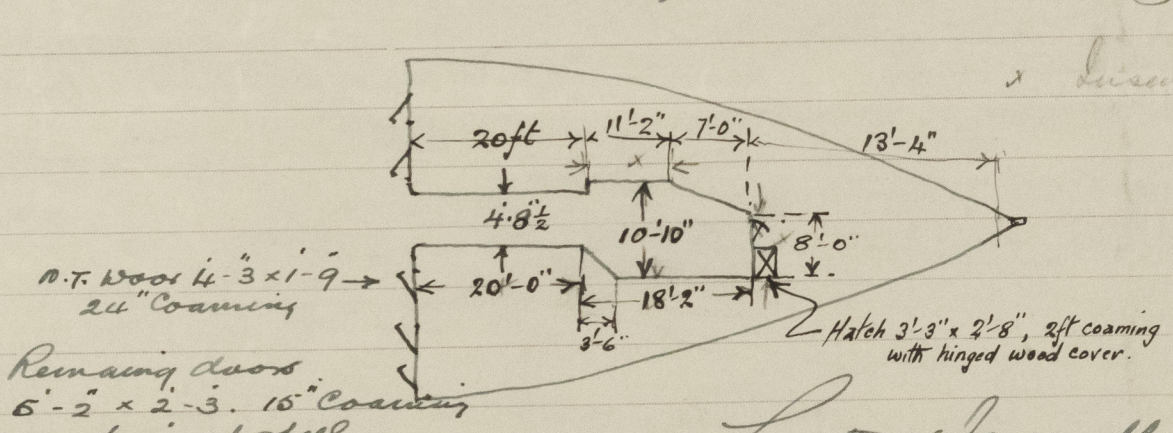

Length of forecastle: 51-6

Height " = 7-6

Sd L. Wake
07/11/41.

Cargo and coal ports efficiently closed, secured & made watertight. See Syd. Eden 23/9/41

—

© 2020 Lloyd's Register Foundation

004881-004886-0472