

## Lloyd's Register of Shipping.

APR 9 1941.


Ship's Name PORT DUNEDINOfficial No. 148599

Memorandum of alterations reported since ship was surveyed for assignment of Load Lines  
in SWANSEA

Now Done with a view to revision of freeboard.

Freeing ports in tonnage will closed by means of welded plates. Tonnage opening in shelter deck closed by means of wood hatch covers bolted to rest bars (2 bolts to each cover) and caulked. Steel plates screwed to top of hatch covers. Beam fitted at mid-length of tonnage opening.

Dimensions of Forecastle as given below.

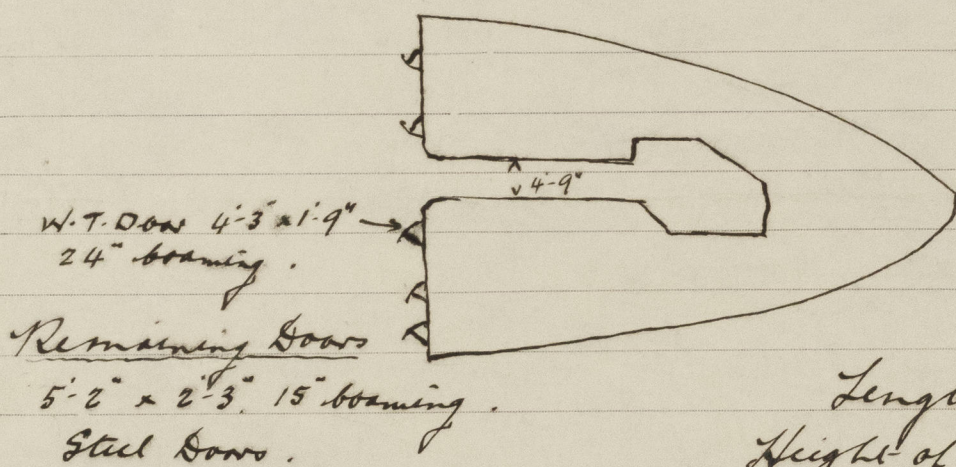

Length of Forecastle = 51'-6"  
Height of Fore Deck = 4'-6"

Ed. Wake

5<sup>th</sup> April 1941.