


15/5/24.

AMENDED FRAME BRACKETS IN ENGINE ROOM N° 477 M.S.

SCALE  $\frac{1}{2}$ " = ONE FOOT.

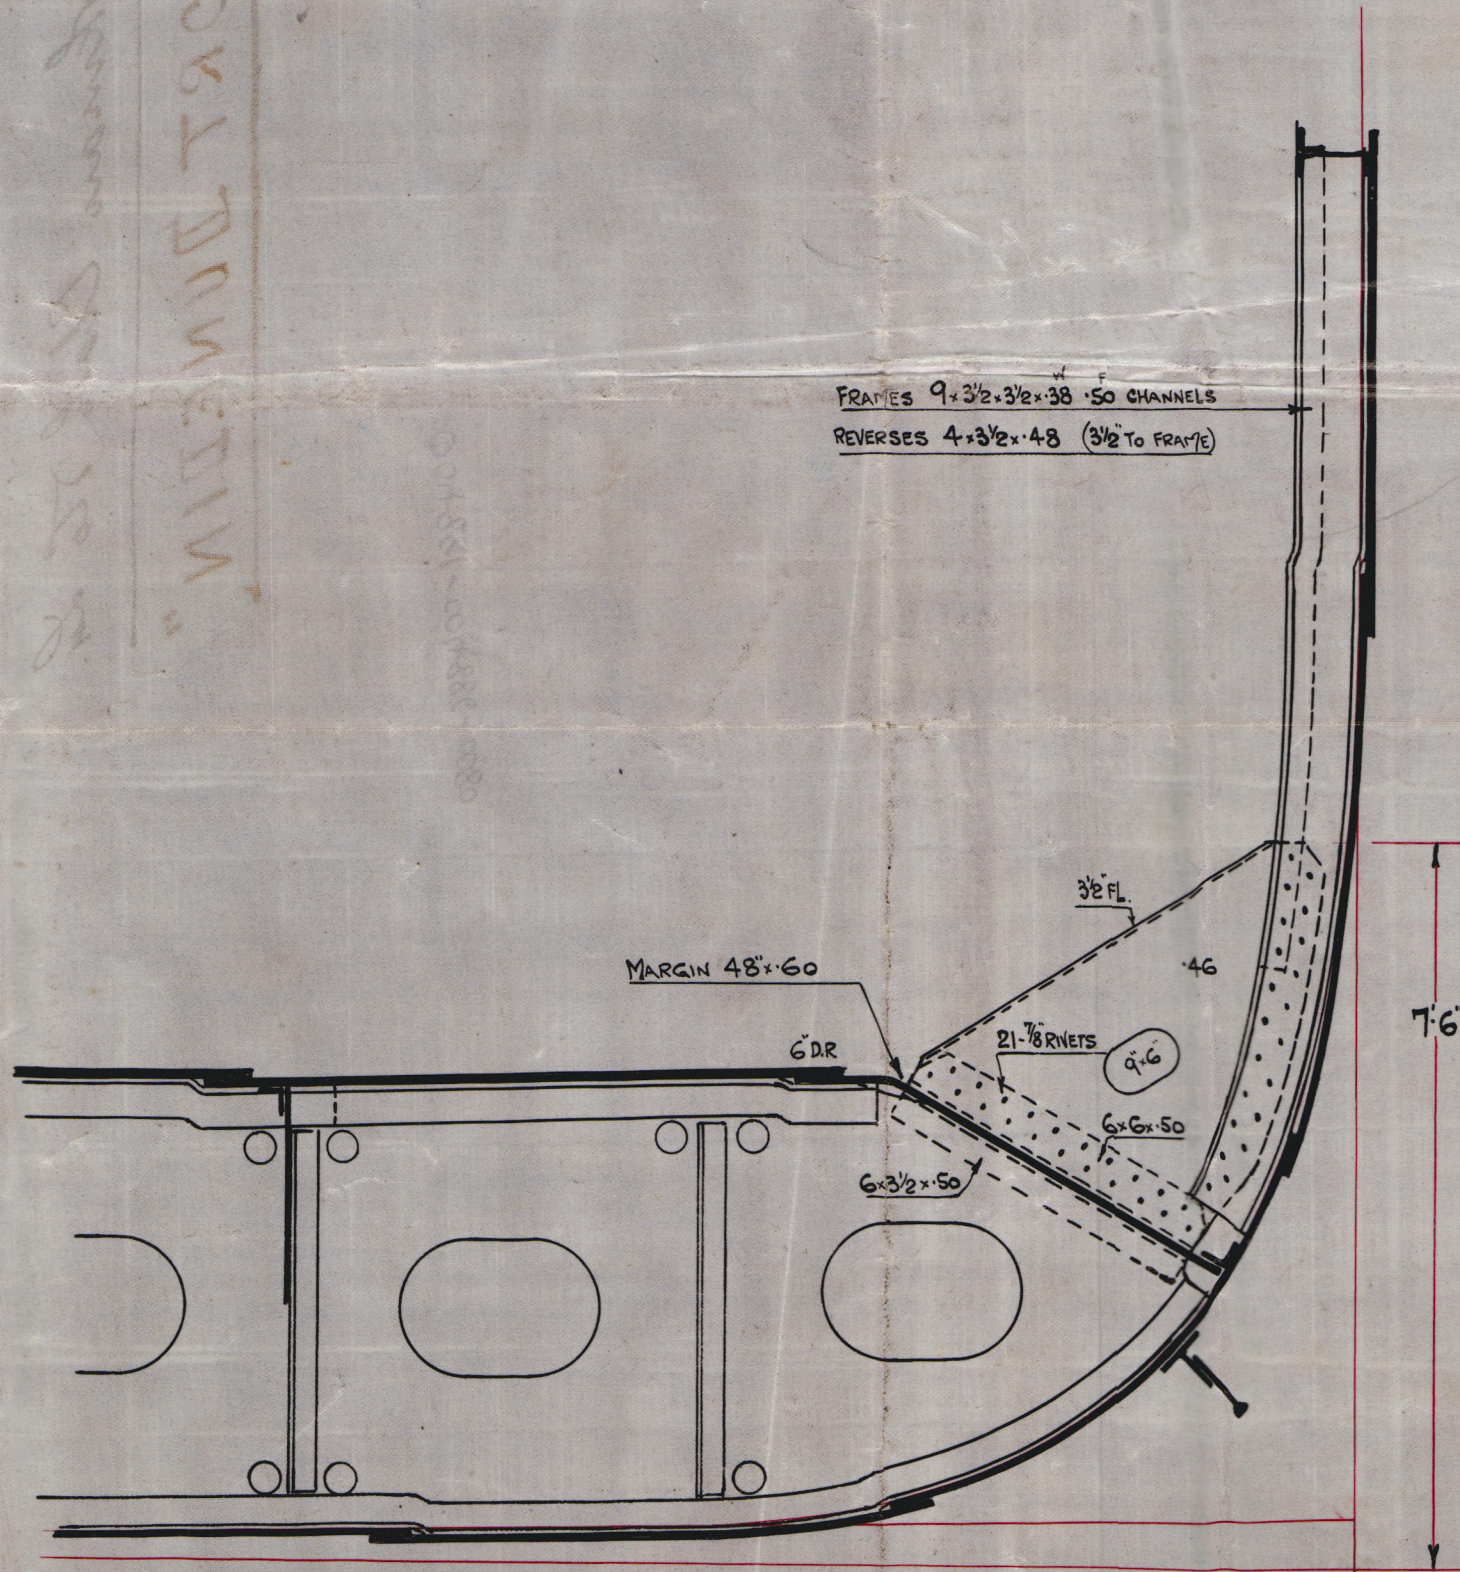

Bdy.  
14-8-24



© 2020  
Lloyd's Register  
Foundation



Frame brackets at bridge  
iii  
Engine Space.

g. 2. 477.

Workman Clark & Co. Ltd.  
"PORT DUNEDIN"

004881-004886-0080