


15/37
8/4/34 (Nos 806-812)
6/4/37 (12813) 8/4

Nº 751.
PROFILE.

520'-0" x 69'-0" x 43'-9" MLD. TO SHELTER DECK.
SCALE 1/16" = 1 FOOT.

SHEER FORWARD = 8'-6"
SHEER AFT = 3'-6"

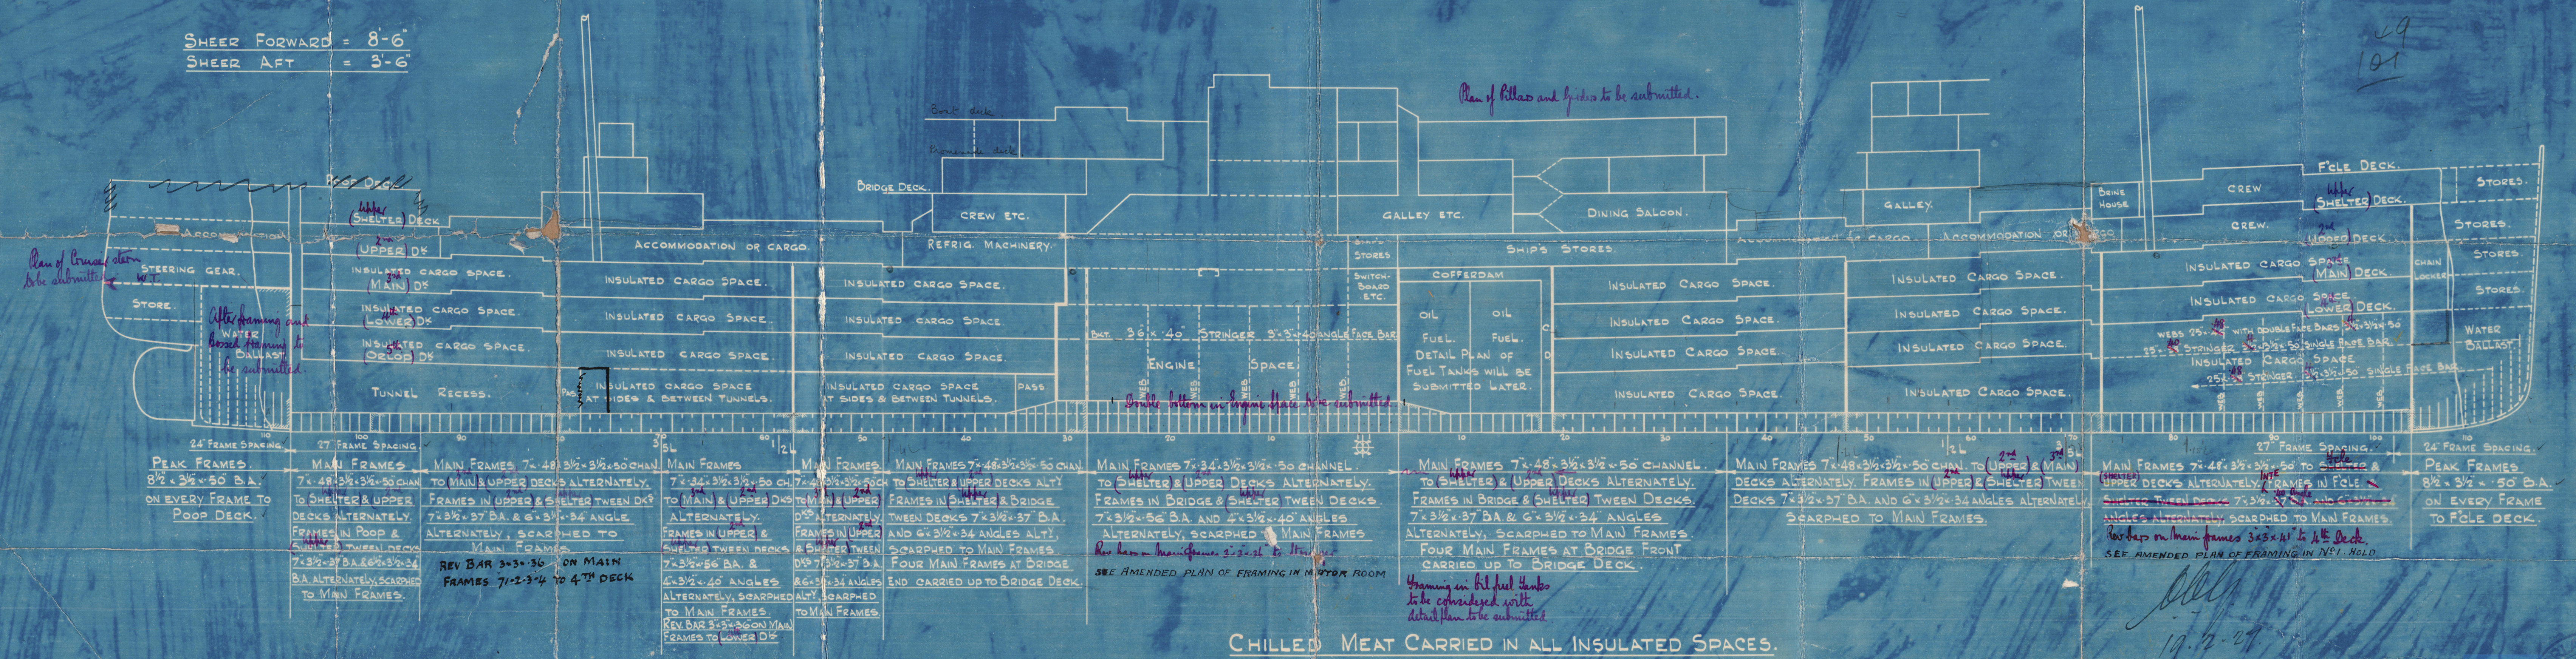

CHILLED MEAT CARRIED IN ALL INSULATED SPACES.

Profile plan

S.S. "Highland Monarch"
Harland & Wolff's No. ~~751~~

Bel. rept. No. 10047

Sister vessels:

Highland Chieftain	No. 806
" Brigade	812
" Hope	813



© 2020

Lloyd's Register
Foundation

004887-004892-0003