


28/4/27 (Rev. 501 + 512)
No 751


DECK PLANS.

DMS- 520'-0" x 69'-0" x 43'-9" M.L.D. TO SHELTER DK.

SCALE 1/8" = 1 FOOT.

 

ELEVATION OF TOP SIDE PLATING AT FORD END OF BRIDGE

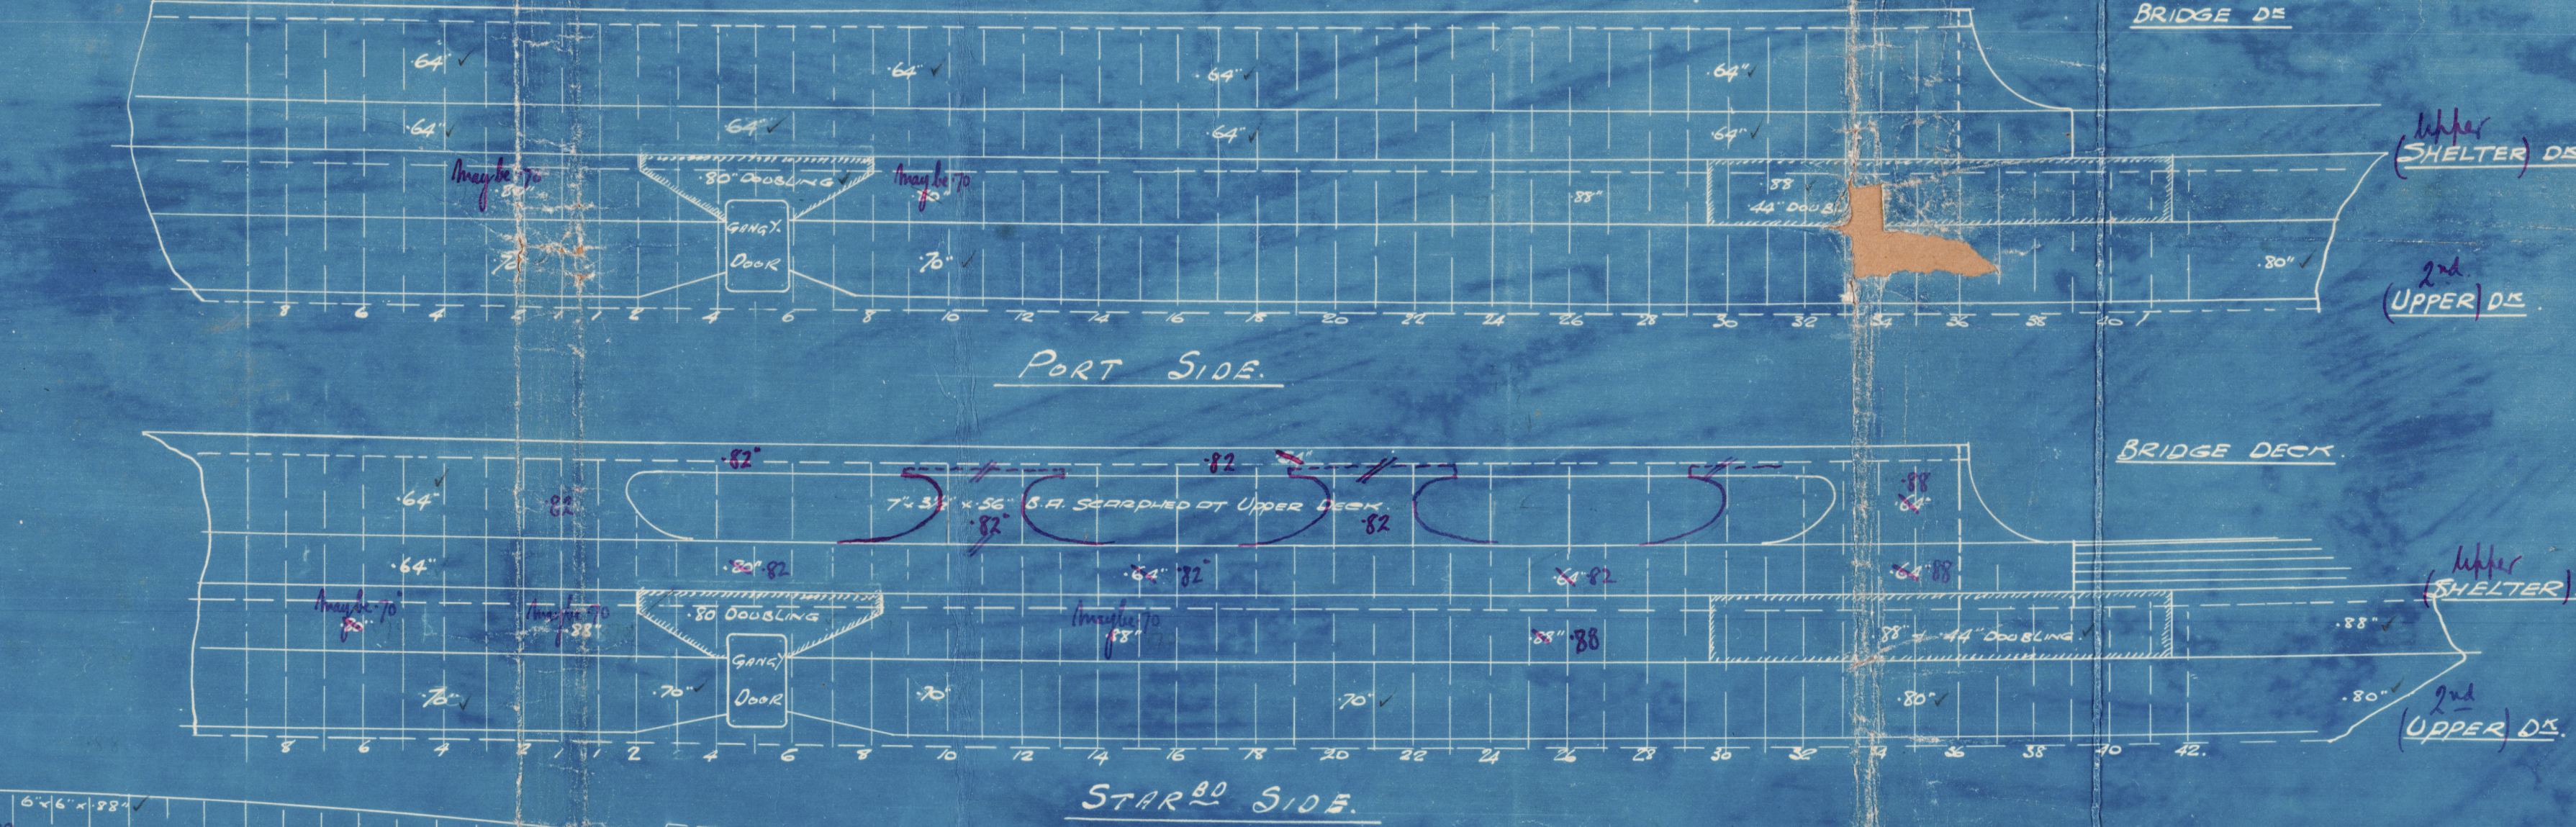

SHELTER DECK

UPPER DECK

Harold & Wolff
nos 751-806-812-814.

Deck plans
"Highland Monarch"

6

004887- 004892- 0004



© 2020

Lloyd's Register
Foundation