

MAR 31 1908

Lloyd's Register of Shipping.


SURVEYS FOR FREEBOARD.

(CONDITIONS OF ASSIGNMENT.)

GREENOCK REPORT N° 20542.

Ship's Name	"DAVILA"	Port of Survey	GREENOCK
Official Number	✓ 166464	Surveyor's Signature	Kenneth Inglis.
Nationality and Port of Registry	BRITISH. LONDON.	Date of Survey	WHILE BUILDING.

Disposition and dimensions of superstructures, trunks, deckhouses and machinery casings to be inserted in the diagrams and tabular statement:—

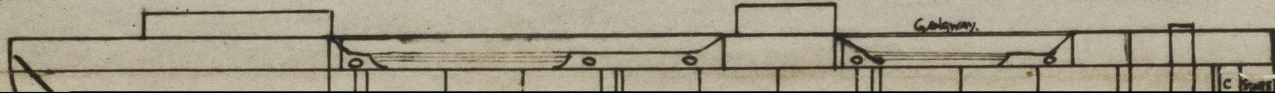


© 2020

Lloyd's Register
Foundation

PARTICULARS OF PROTECTION TO OPENINGS, ETC.

The following diagrams should be used to indicate the positions of cargo and coaling hatchways, gangway, cargo and coaling ports, ventilators, companionways, etc., which would affect the seaworthiness of the ship:—

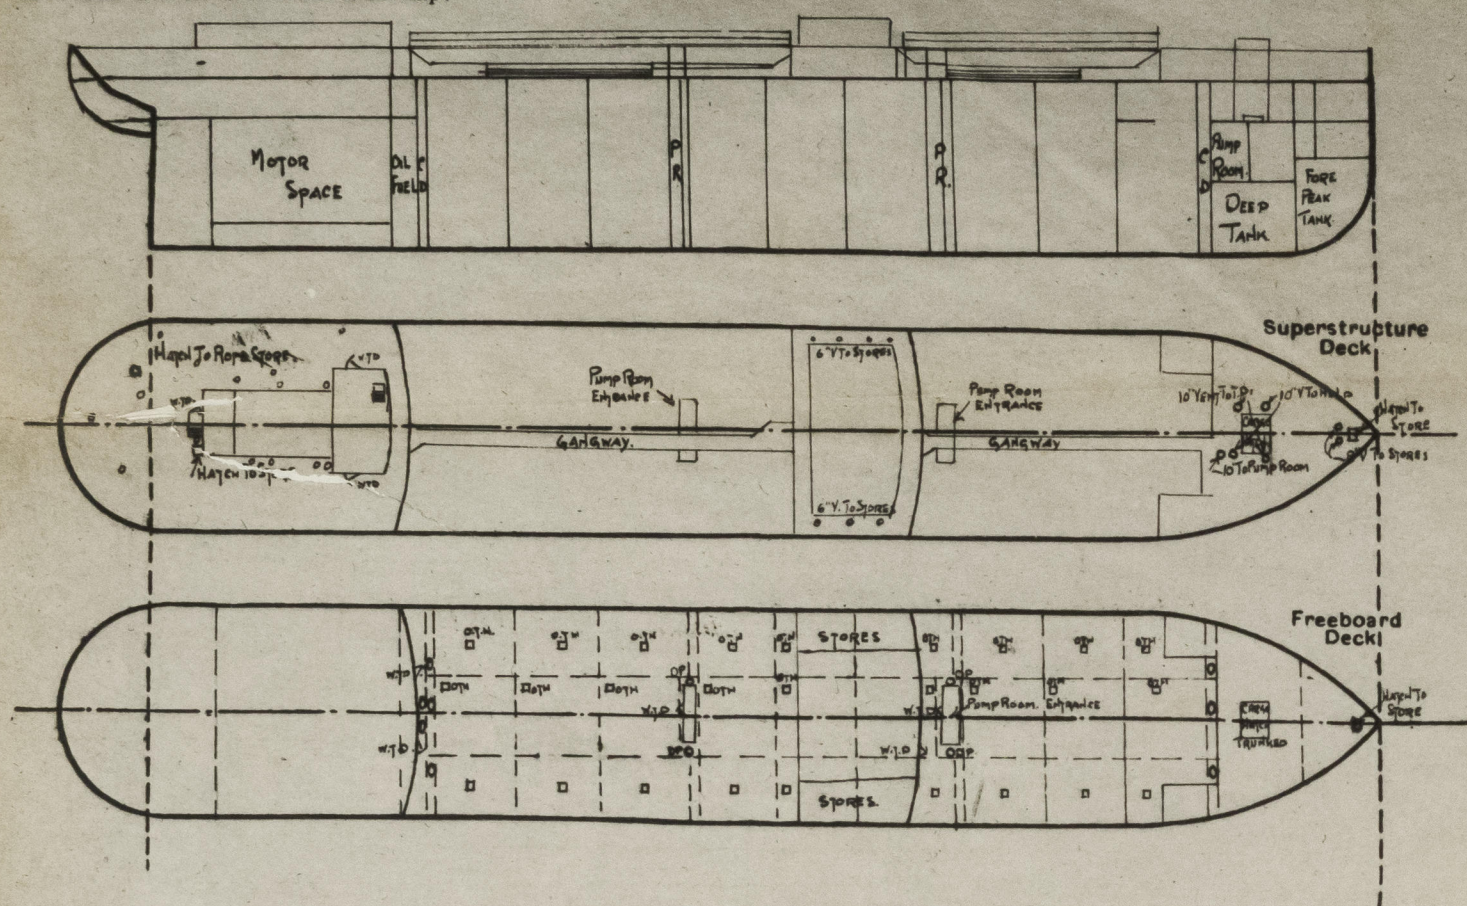

Particulars of hddley, funnel and ventilator coamings, engine room skylight and other openings in machinery casing tops and their means of closing:—

ENGINE ROOM SKYLIGHT OF STEEL STRONGLY CONSTRUCTED.
FIDOLEY FUNNEL VENT COAMINGS EFFICIENT
FIDOLEY COAMINGS FITTED WITH STRONG HINGED STEEL COVERS ✓

Particulars of Flush Bunker Scuttles:— None ✓

Particulars of Companionways:— PUMP ROOM ENTRANCES IN FORE & AFTER WELLS
OPENINGS ENCLOSED BY STEEL HOUSE, SUBSTANTIALLY CONSTRUCTED.
WITH HINGED W.T. DOOR AT AFTER END. SILL 18"
DOORS WORKABLE FROM BOTH SIDES.
ALSO COMPANION TO POOP TWIN DECKS CONSTRUCTED OF STEEL &
HAVING STEEL W.T. DOOR WITH SILL 18" HIGH & WORKABLE
FROM BOTH SIDES ✓

Particulars of Ventilators in exposed positions on freeboard and superstructure decks:—

FORECASTLE DECK
2-10" DIA. VENTS TO FORE HOLD COAMINGS 36" x 32" ✓
2-10" " " " TWIN DECKS " 36" x 32" ✓
1-10" " " " PUMP ROOM " 36" x 32" ✓
3-8" " " " STORES " 36" x 30" ✓

WELLS
1-24" DIA DERRICK POSTS PORT & STARBOARD TO EACH PUMP ROOM.
CONNECTED TO PUMP ROOM ENTRANCE HOUSE & STAYED.

BRIDGE DECK
2-6" DIA VENTS TO BRIDGE SPACE STORES. COAMINGS 30" x 30" ✓

ALL VENTILATORS CONSTRUCTED ACCORDING TO THE RULES &
FITTED WITH EITHER STEEL SCREW DOWN W.T. COVERS OR
WOOD PLUGS WITH CANVAS COVERS. ✓

Particulars of Air Pipes in exposed positions on freeboard, superstructure decks:—

FORECASTLE DECK
2 S.N. AIR PIPES 4" DIA TO FORE PEAK 18" TOLIP
2 S.N. " " " " DEEP TANK 18" TOLIP
FOREWELL
1 AIR PIPE 3" DIA TO COFFERDAM (P/S) ✓
1 AIR PIPE 3" DIA TO COFFERDAM (P/S) ✓
AFTER WELL
1 AIR PIPE (P/S) 3 1/2" DIA TO COFFERDAM 18" TOLIP ✓
1 (P/S) 4" " " O.F. BUNKER ✓
1 (P/S) 3" " " SETTLING TANK ✓
ALL LED UP POOP DECK TO 2-6" ABOVE POOP DECK. ✓

POOP DECK
1 S.N. AIR PIPE TO AIR TANK (P/S) 2-6" TOLIP ✓
1 S.N. " " " " " " " " 2-6" TOLIP ✓
2 S.N. " " " " " " " " 2-6" " " ✓
BOAT DECK
1 AIR PIPE TO OIL TANK D.B. (P/S) 1-6" TOLIP ✓
1 S.N. 3 1/2" " " " " " " " 1-6" " " ✓
2 S.N. 5" " " " " " " " 1-6" " " ✓
2 S.N. 2" " " " " " " " 1-6" " " ✓
2 S.N. 3 1/2" " " " " " " " 1-6" " " ✓

ALL AIR PIPES FROM OIL SPACES
FITTED WITH COPPER GANZE ELBOWS
WOOD PLUGS FITTED.

Particulars of Gangway Cargo and Coaling Ports:—

None ✓

Particulars of Scuppers and Sanitary Discharge Pipes:—

SCUPPERS In Wells:— 6" PIPE SCUPPERS FITTED AT ENDS OF BRIDGE & POOP DISCHARGING ABOUT 18" BELOW FREEBOARD DK. ✓
STRINGER BAR CUT FOR REMAINING SCUPPERS.
In POOPY FLOOR TANKS:— DISCHARGE OVERBOARD FITTED WITH STORM VALVES AT SHIPS SIDE & BRASS SCREWED PLUGS AT INNER END ✓
SANITARY DISCHARGES— FROM ENCLOSED SPACES FITTED WITH STORM VALVES AT SHIPS SIDE & 11 BEND TRAP AT INNER END. ✓
STORM VALVES FROM POOPY FORECASTLE SPACES ABOUT 6' 0" BELOW FREEBOARD DECK.
" " " BRIDGE HOUSES FITTED ABOVE FREEBOARD DK. ✓


Particulars of Side Scuttles:— SIDELIGHTS ARE FITTED IN POOP BRIDGE & FORECASTLE SPACES 8" TO 10" DIA.
ALL SIDELIGHTS ARE OF SUBSTANTIAL CONSTRUCTION & ARE FITTED WITH HINGED STEEL
DEADLIGHTS. ✓

Vertical distance of Sill of lowest Side Scuttle above top of keel. No SIDELIGHTS FITTED BELOW FREEBOARD DECK ✓

Particulars of Guard Rails:— POOP BRIDGE & FORECASTLE DECKS.— RAILS 3' 6" HIGH WITH 3 RODS & STANCHIONS SPACED ABOUT 5' 0" APART. ✓

FORE & AFTER WELLS RAILS STANCHIONS BETWEEN BULWARKS. 3' 6" HIGH WITH 3 RODS
& STANCHIONS 5' 0" APART. ✓

Particulars of Gangways, Lifelines, etc.:—

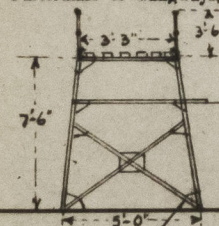

EFFICIENT GANGWAY FITTED OVER BOTH WELLS.
ANGLE SUPPORTS 4x4x40 SPACED ABOUT 7' 6" APART. ✓
DIAGONAL STAYS 3x3x30 ✓
PLATFORM ANGLES 4x4x40 ✓
F&A FT GIRDERS 6x3 1/2x40 CHANNEL ✓
SUPPORTS BRACED F&A WITH 3x3x20 ANGLE STAYS ✓
WOOD PLATFORM 5x3 WOOD SPARRED ✓
RAILS 3' 6" HIGH 2 RODS & STANCHIONS 5' 0" APART. ✓

Particulars of Freeing Arrangements.

	Length of Bulwark	Height of Bulwark	Size of Freeing Ports	Number each side	Area each side	Net area each side
After Well	For O of Poop 18' 0"	3' 6"	3' 0" x 1' 6" OVAL.	1	4.75	OPEN RAILS 8' 4"
	Aft of Bridge 55' 3"			2	9.5	
Forward Well	For O of Bridge 18' 6"	3' 6"	3' 0" x 1' 6" OVAL.	1	4.75	OPEN RAILS 6' 9"
	Aft of F.C. 27' 5"			1	4.75	

State position of each freeing port ... After Well:—
(F. and A. position and height above deck edge) Forward Well:— ✓

State whether the freeing ports are fitted with shutters, bars, or rails, and give particulars of such:— FITTED WITH 3 VERTICAL BARS. ✓

Additional area where sheer is less than standard.

PARTICULARS OF PROTECTION TO OPENINGS, ETC.

HATCHWAYS ON FREEBOARD AND SUPERSTRUCTURE DECKS.									
		SUPERSTRUCTURE DECK							
Description of Hatchway		On Light Hatches in Fore Well in After Well	Hatch to Hold On Fore Deck	Hatch to Hold On Fore Deck	Hatch to Hold On Fore Deck	Hatch to Hold On Fore Deck	Hatch to Hold On Fore Deck	Hatch to Hold On Fore Deck	Hatch to Hold On Fore Deck
Dimensions of Hatchway		4'-0" x 3'-0" ✓	8'-0" x 10'-0"	2'-6" x 2'-6"	2'-9" x 3'-0"	16 1/2" Dia.			
COAMINGS	Height above Deck	30" ✓	30" ✓	6 x 3 x 40 Angle Coaming					
	Thickness	40" ✓	44" ✓	Hinged Steel W.T. Covers 40					
	Sides	40" ✓	44" ✓	Secured By Toggles 15" Apart					
	Stiffeners	✓	6 x 3 x 40 BA ✓						
	Brackets, Stays	✓							
HATCH BEAMS	Number	Steel Hinged Covers 50 Holes	Trunked To 2" Dk.						
	Spacing	With Spacing 4 x 3 x 40	30 PLATING						
	Scantling and Sketch	Closed By Toggles Spaced 15" Apart ✓	24" Apart						
FORE AND AFTERS	Bearing Surface	MANHOLES 3 To Fore Coppeadam. 3 To Aft 2 To O.P. Bunker. 25" x 18 1/2"	STEEL HINGED W.T. COVER 40 WITH 4 x 3 x 40 STIFFEN 33" APART						
	Number	COAMING 12 x 3 x 40	COVER SECURED BY TOGGLES						
	Spacing	Channels	SPACED 15" APART ✓						
	Unsupported Lengths	50 Steel Covers							
	Scantling and Sketch	With Bolts Spaced 4" Apart ✓							
HATCH COVERS	Material								
	Thickness								
	How fitted								
	Bearing Surface								
Spacing of Cleats									
Number of Tarpaulins									

*Are wood fore and afters steel shod at all bearing surfaces? ✓
 Are battens and wedges efficient and in good condition? ✓
 Are tarpaulins in good condition and in accordance with rule requirements? ✓
 Are lashings provided in accordance with rule requirements? ✓

Particulars of any special features:—

Endorsement at first survey and at surveys for renewal of Certificate:—

The fittings and appliances are in accordance with the particulars shown on this form (or as now modified) and are in good condition.



© 2020

Lloyd's Register Foundation