
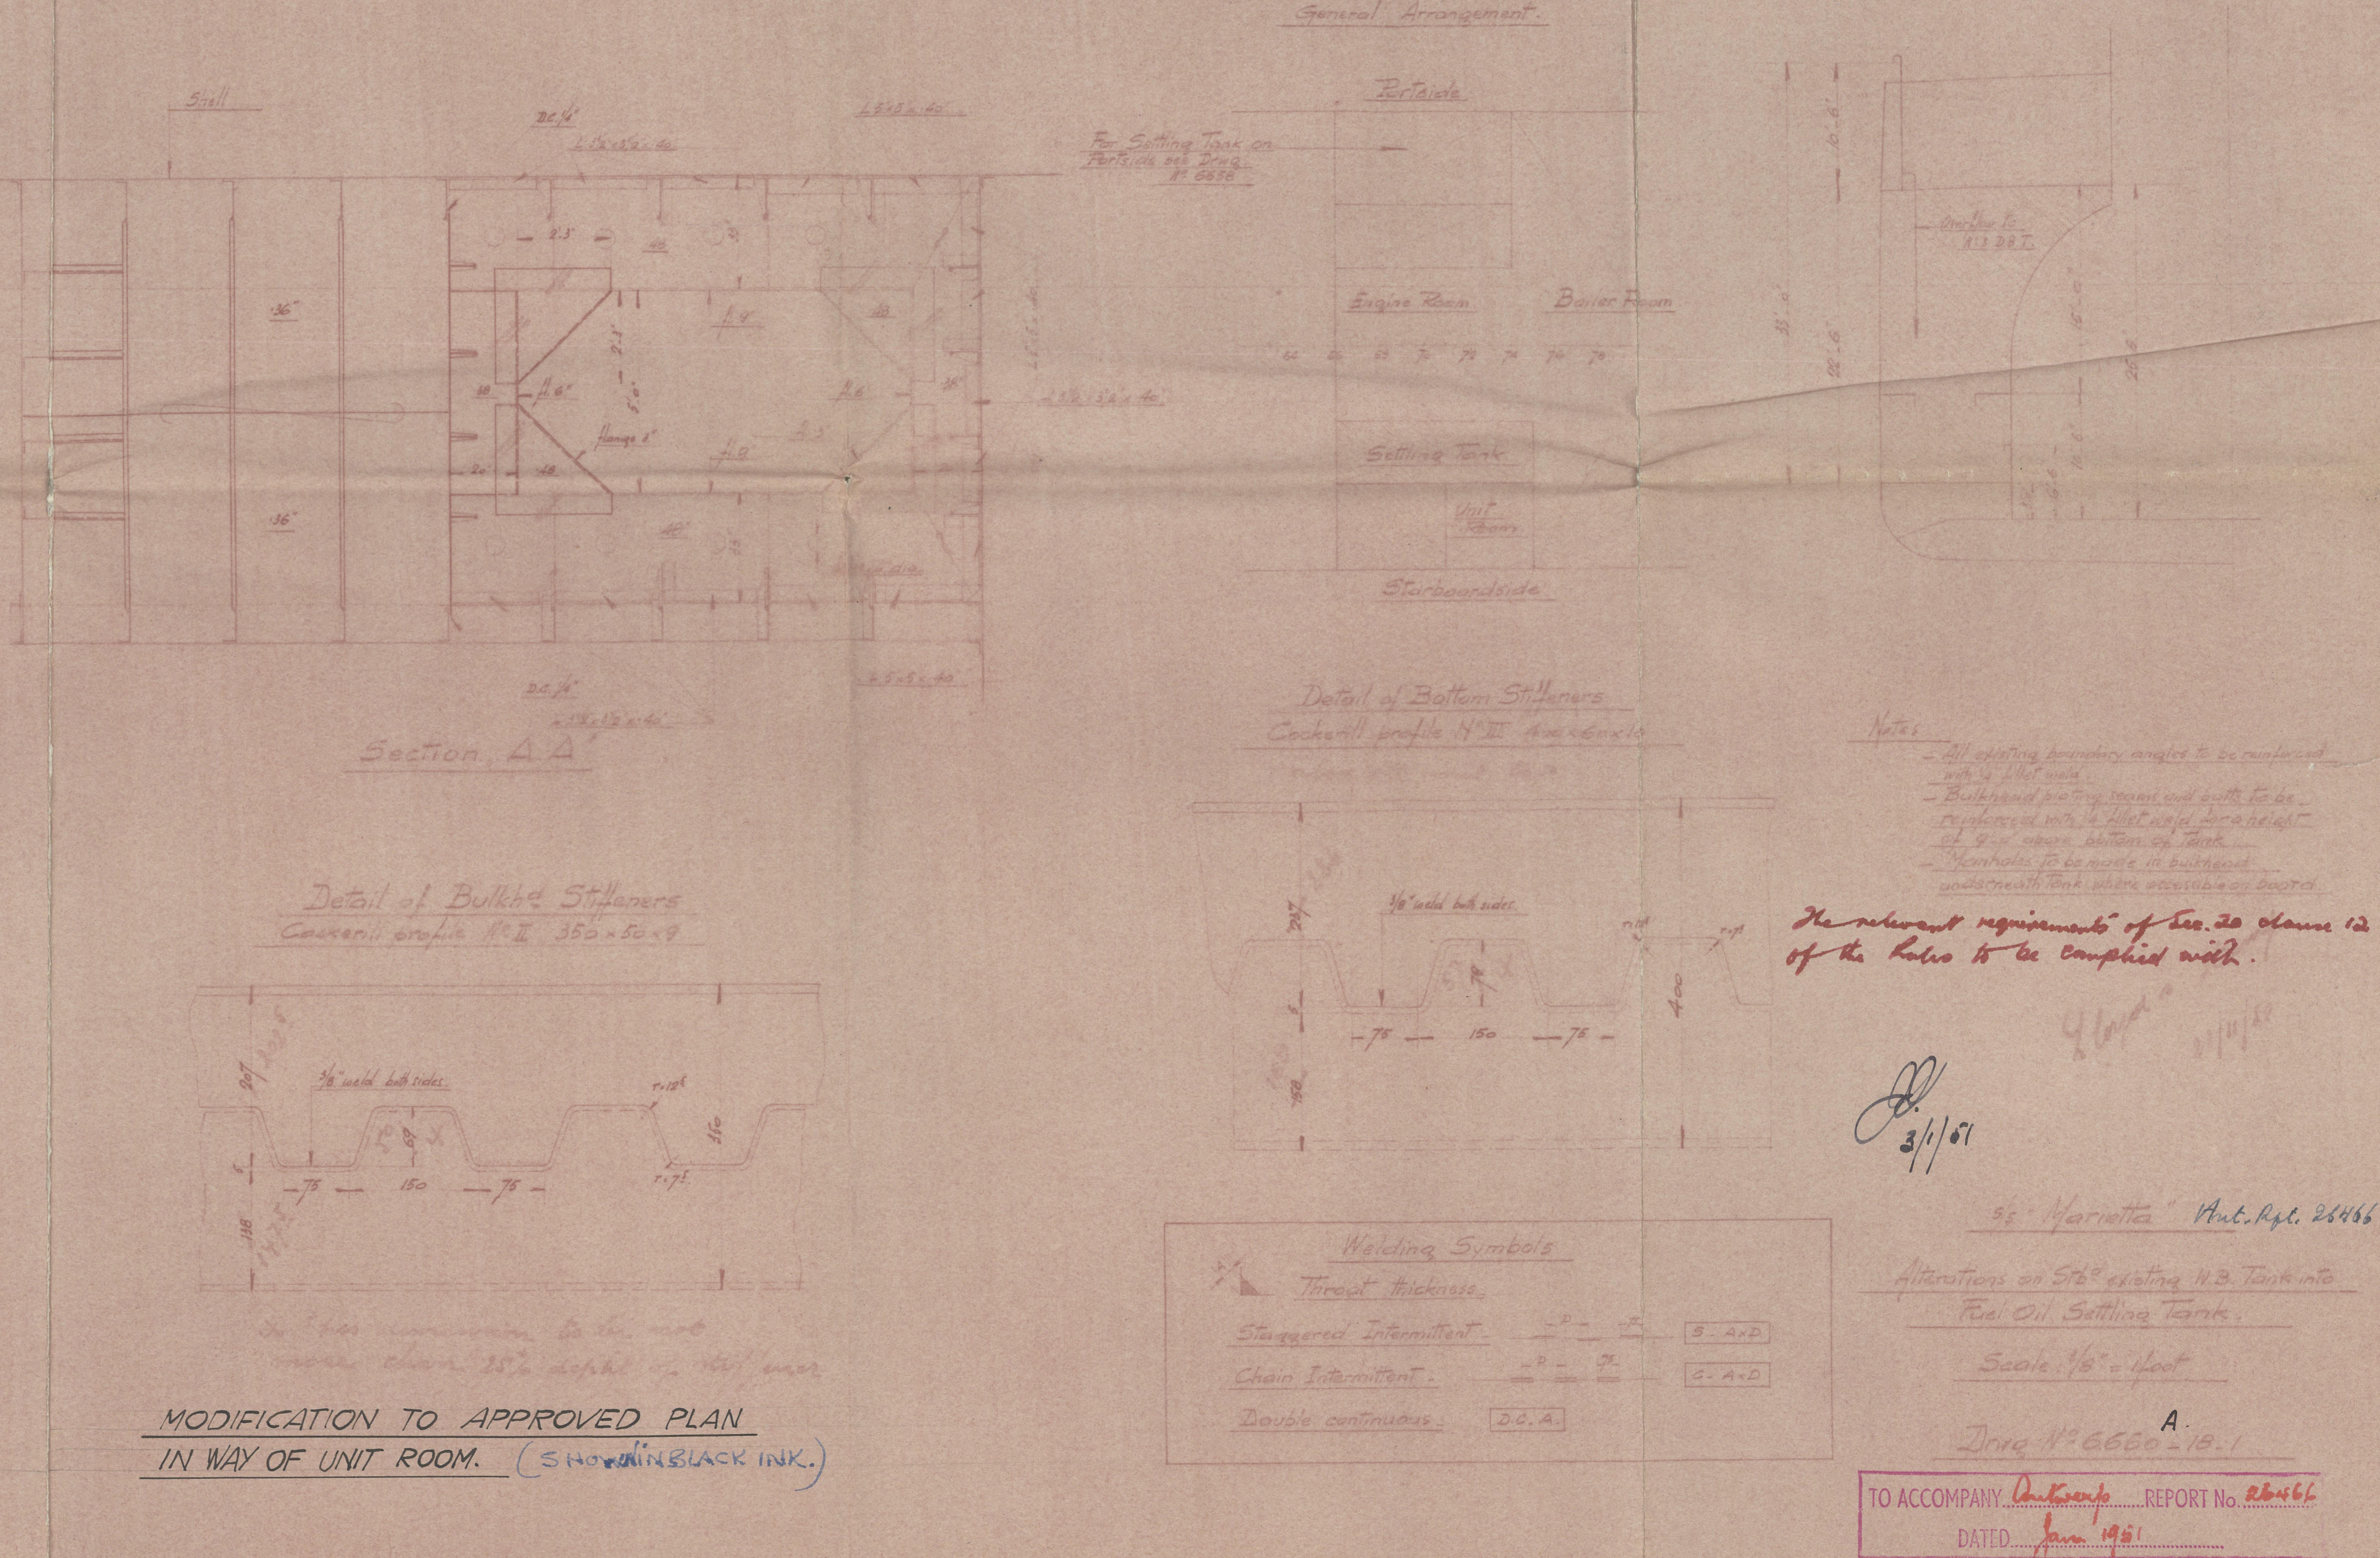
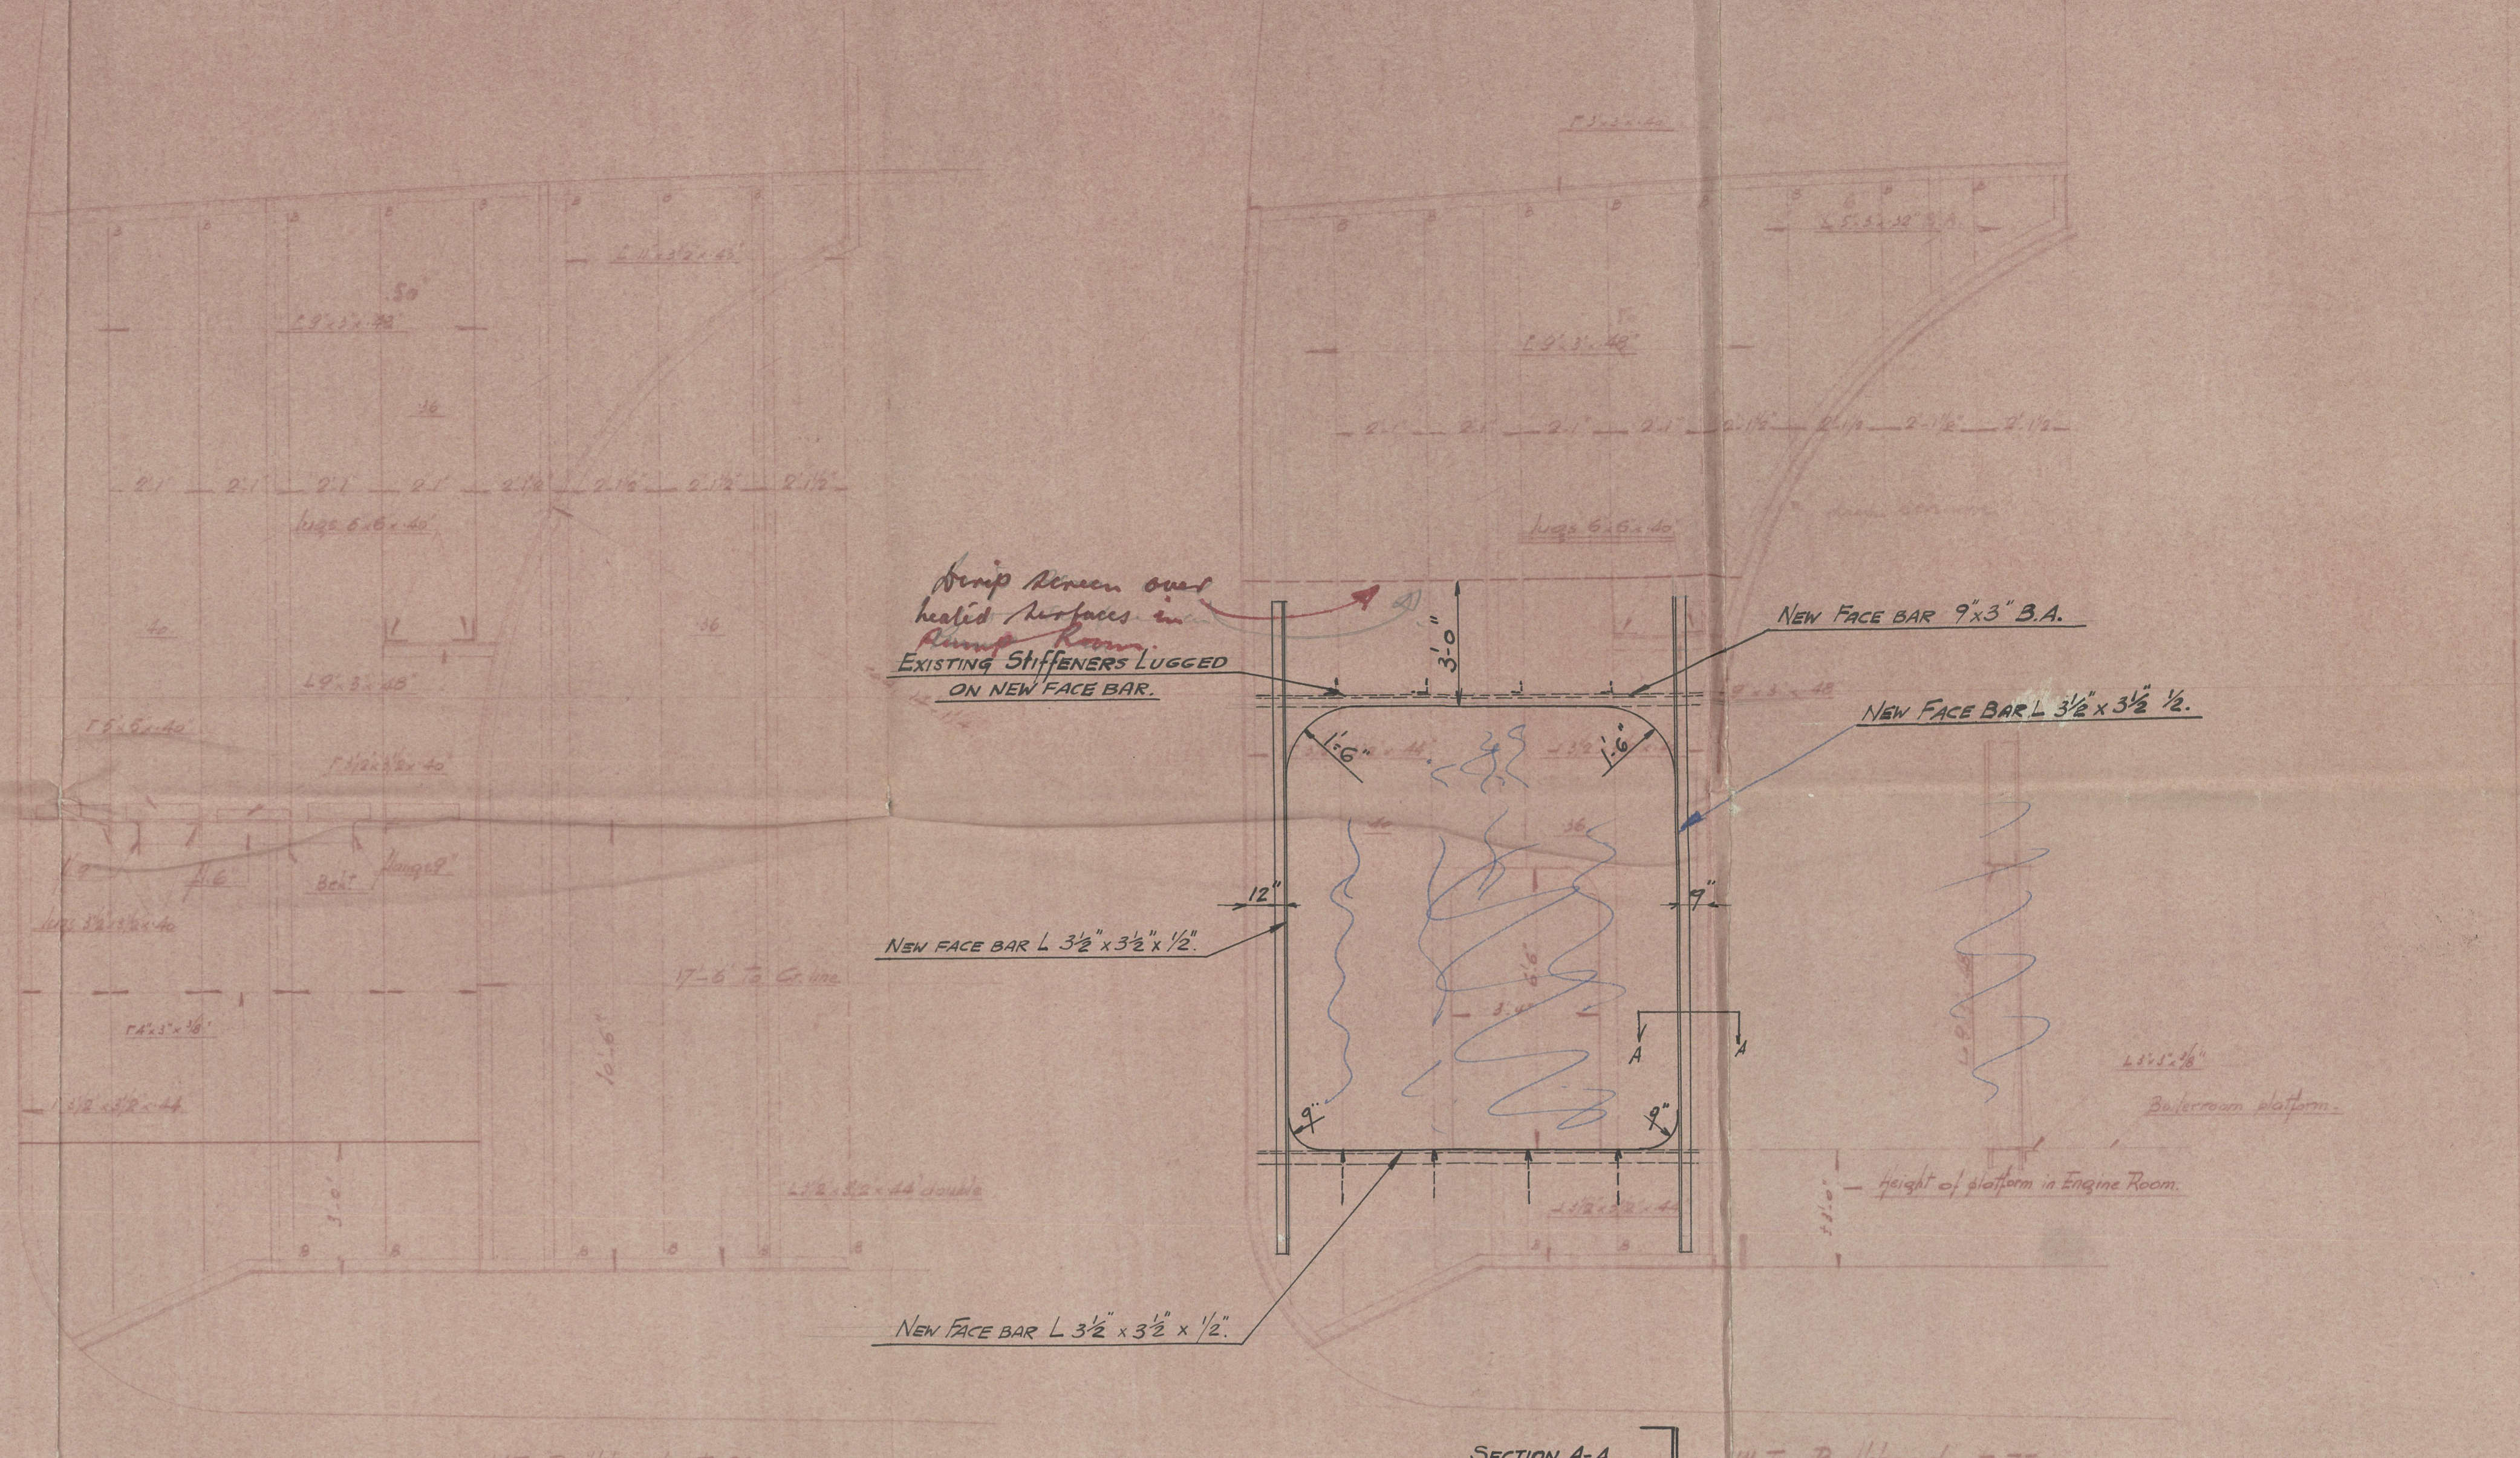
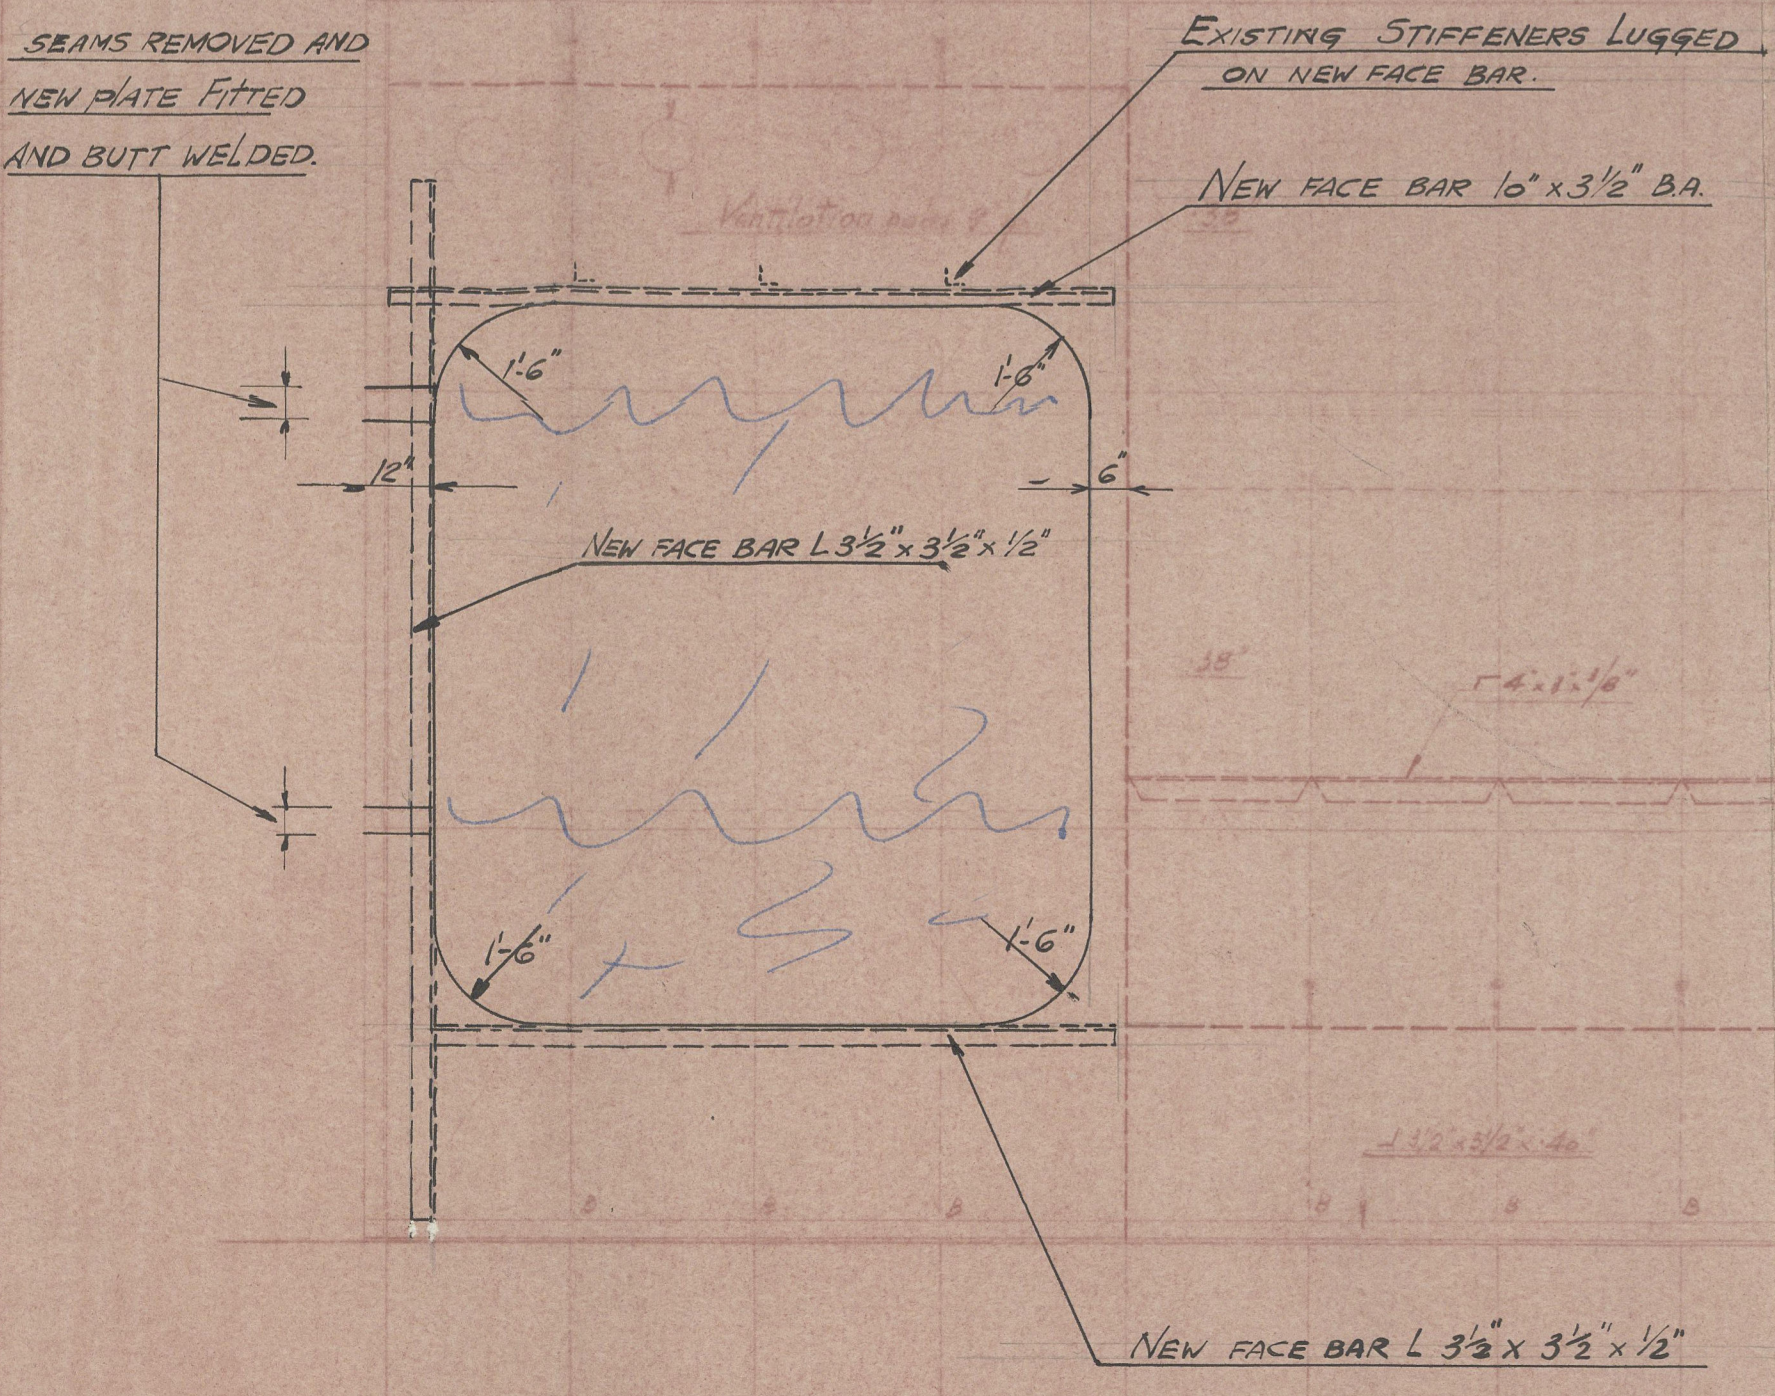
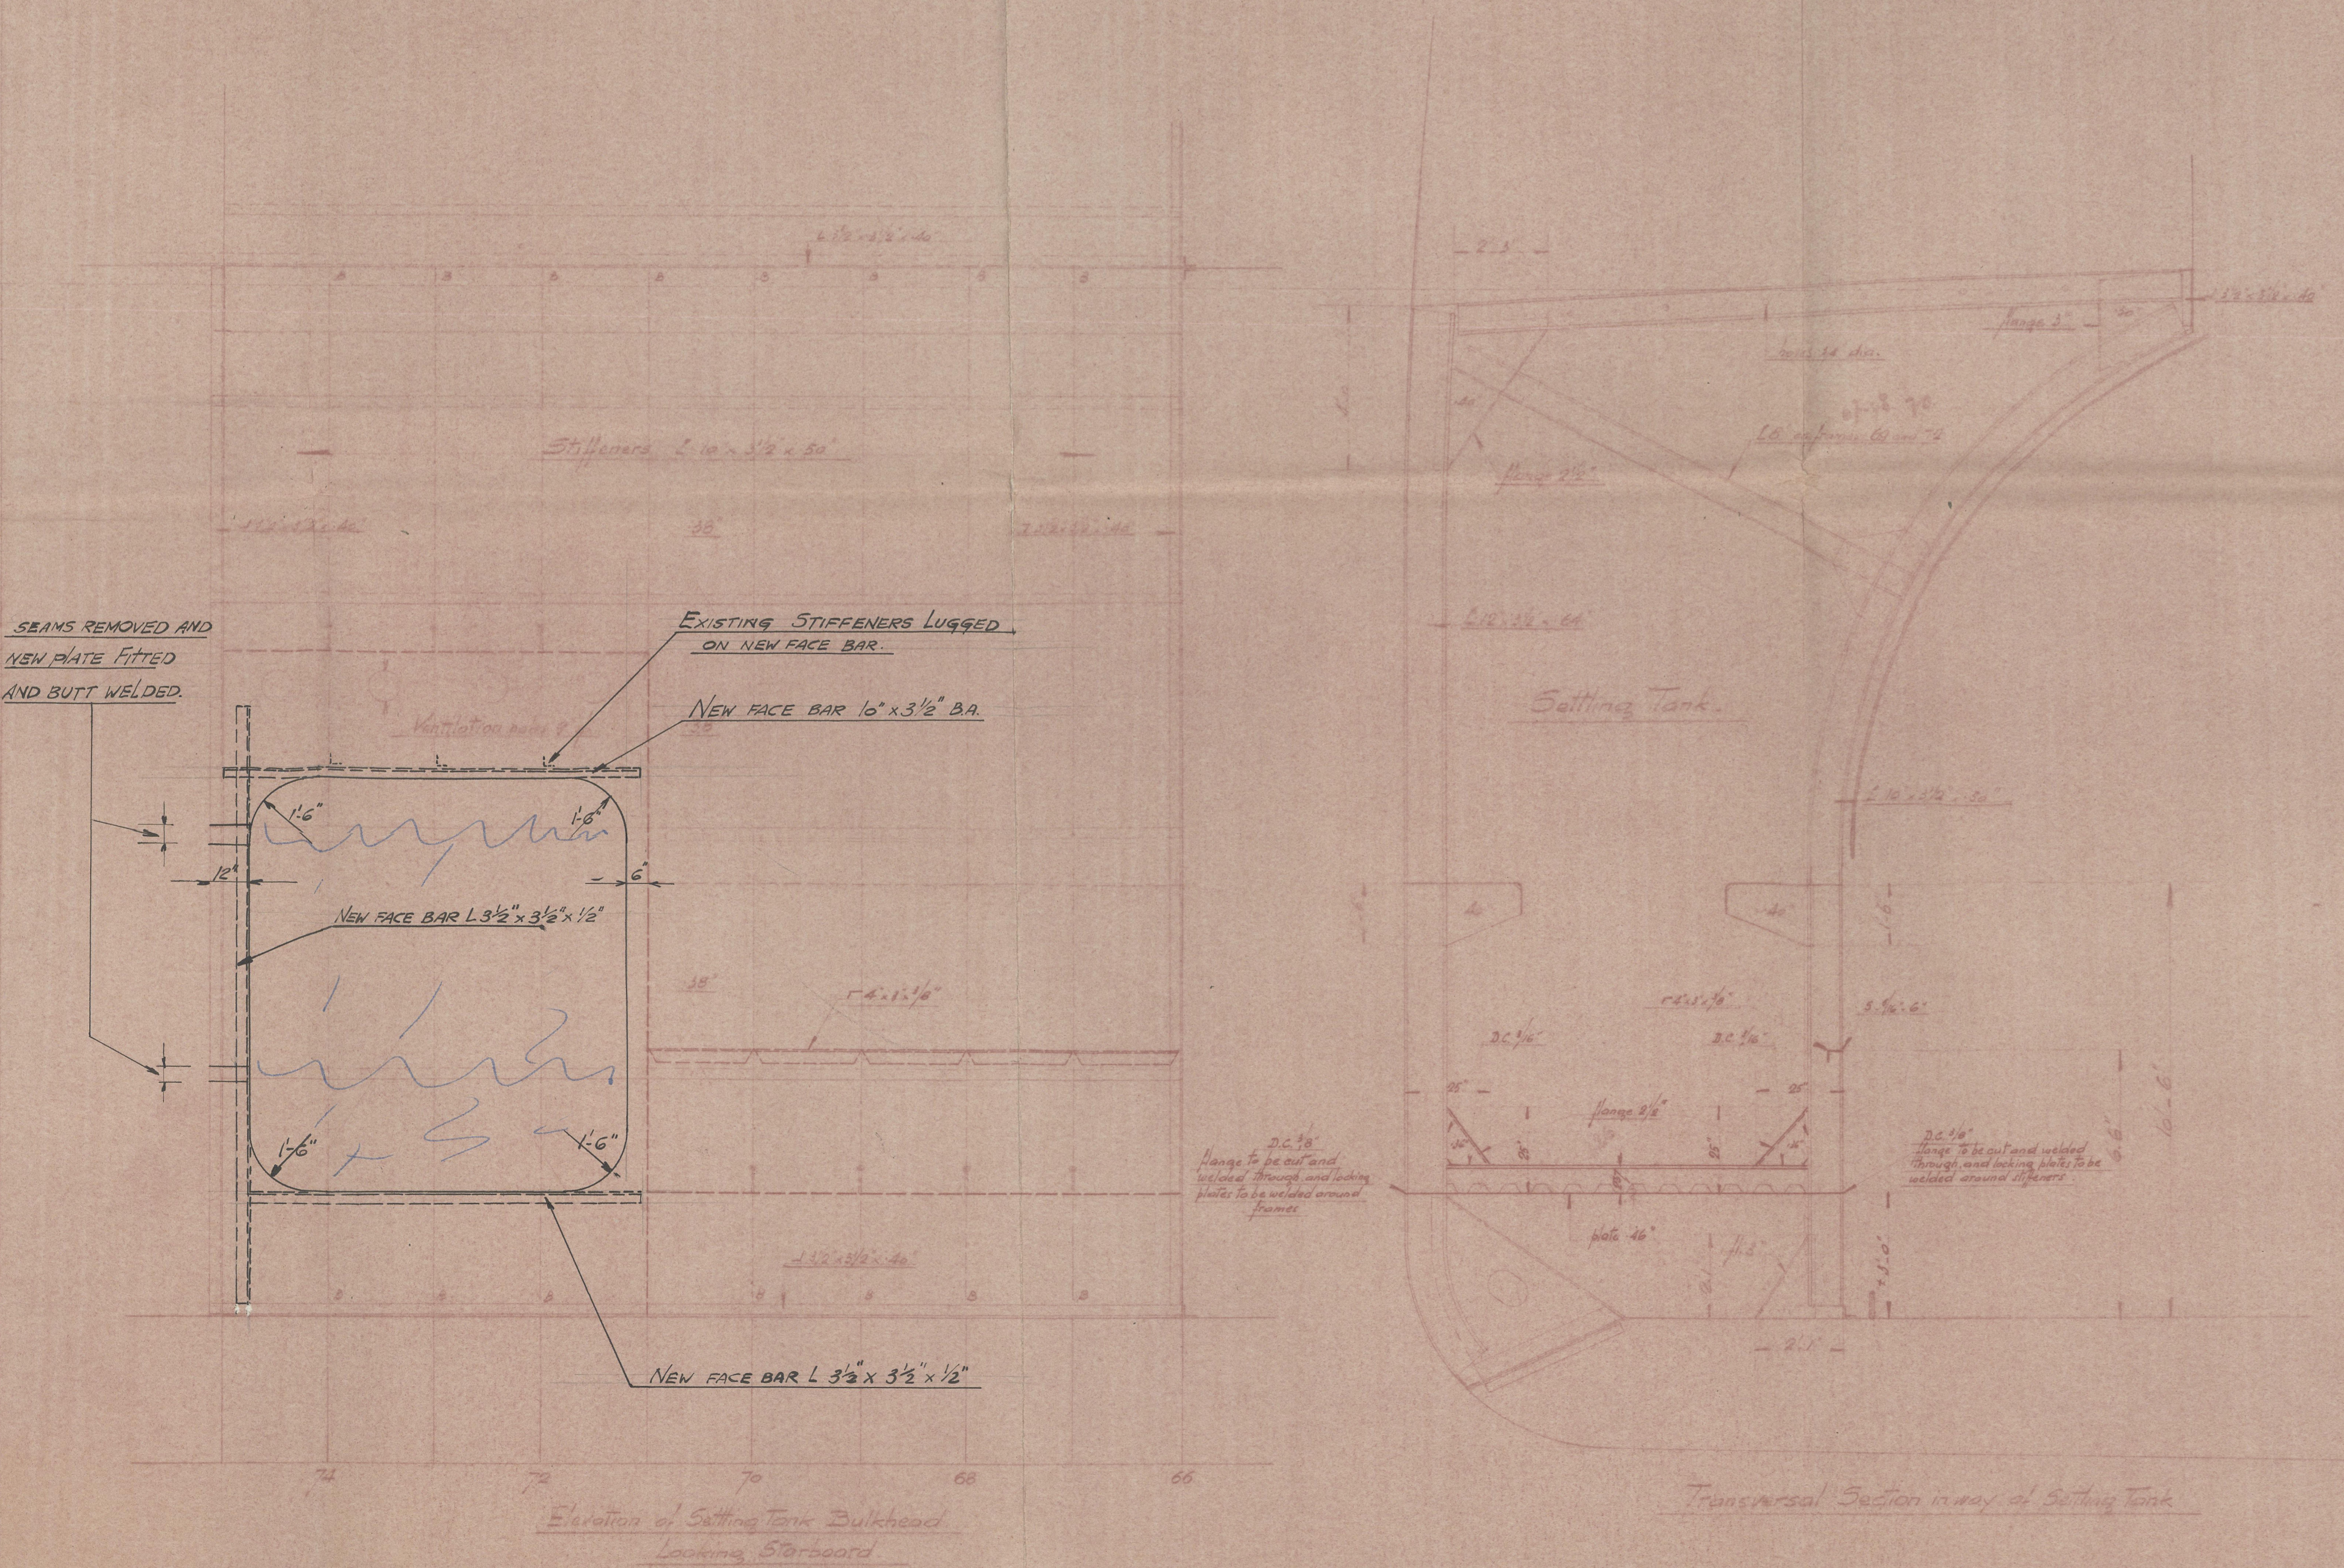


74 JAN 1951

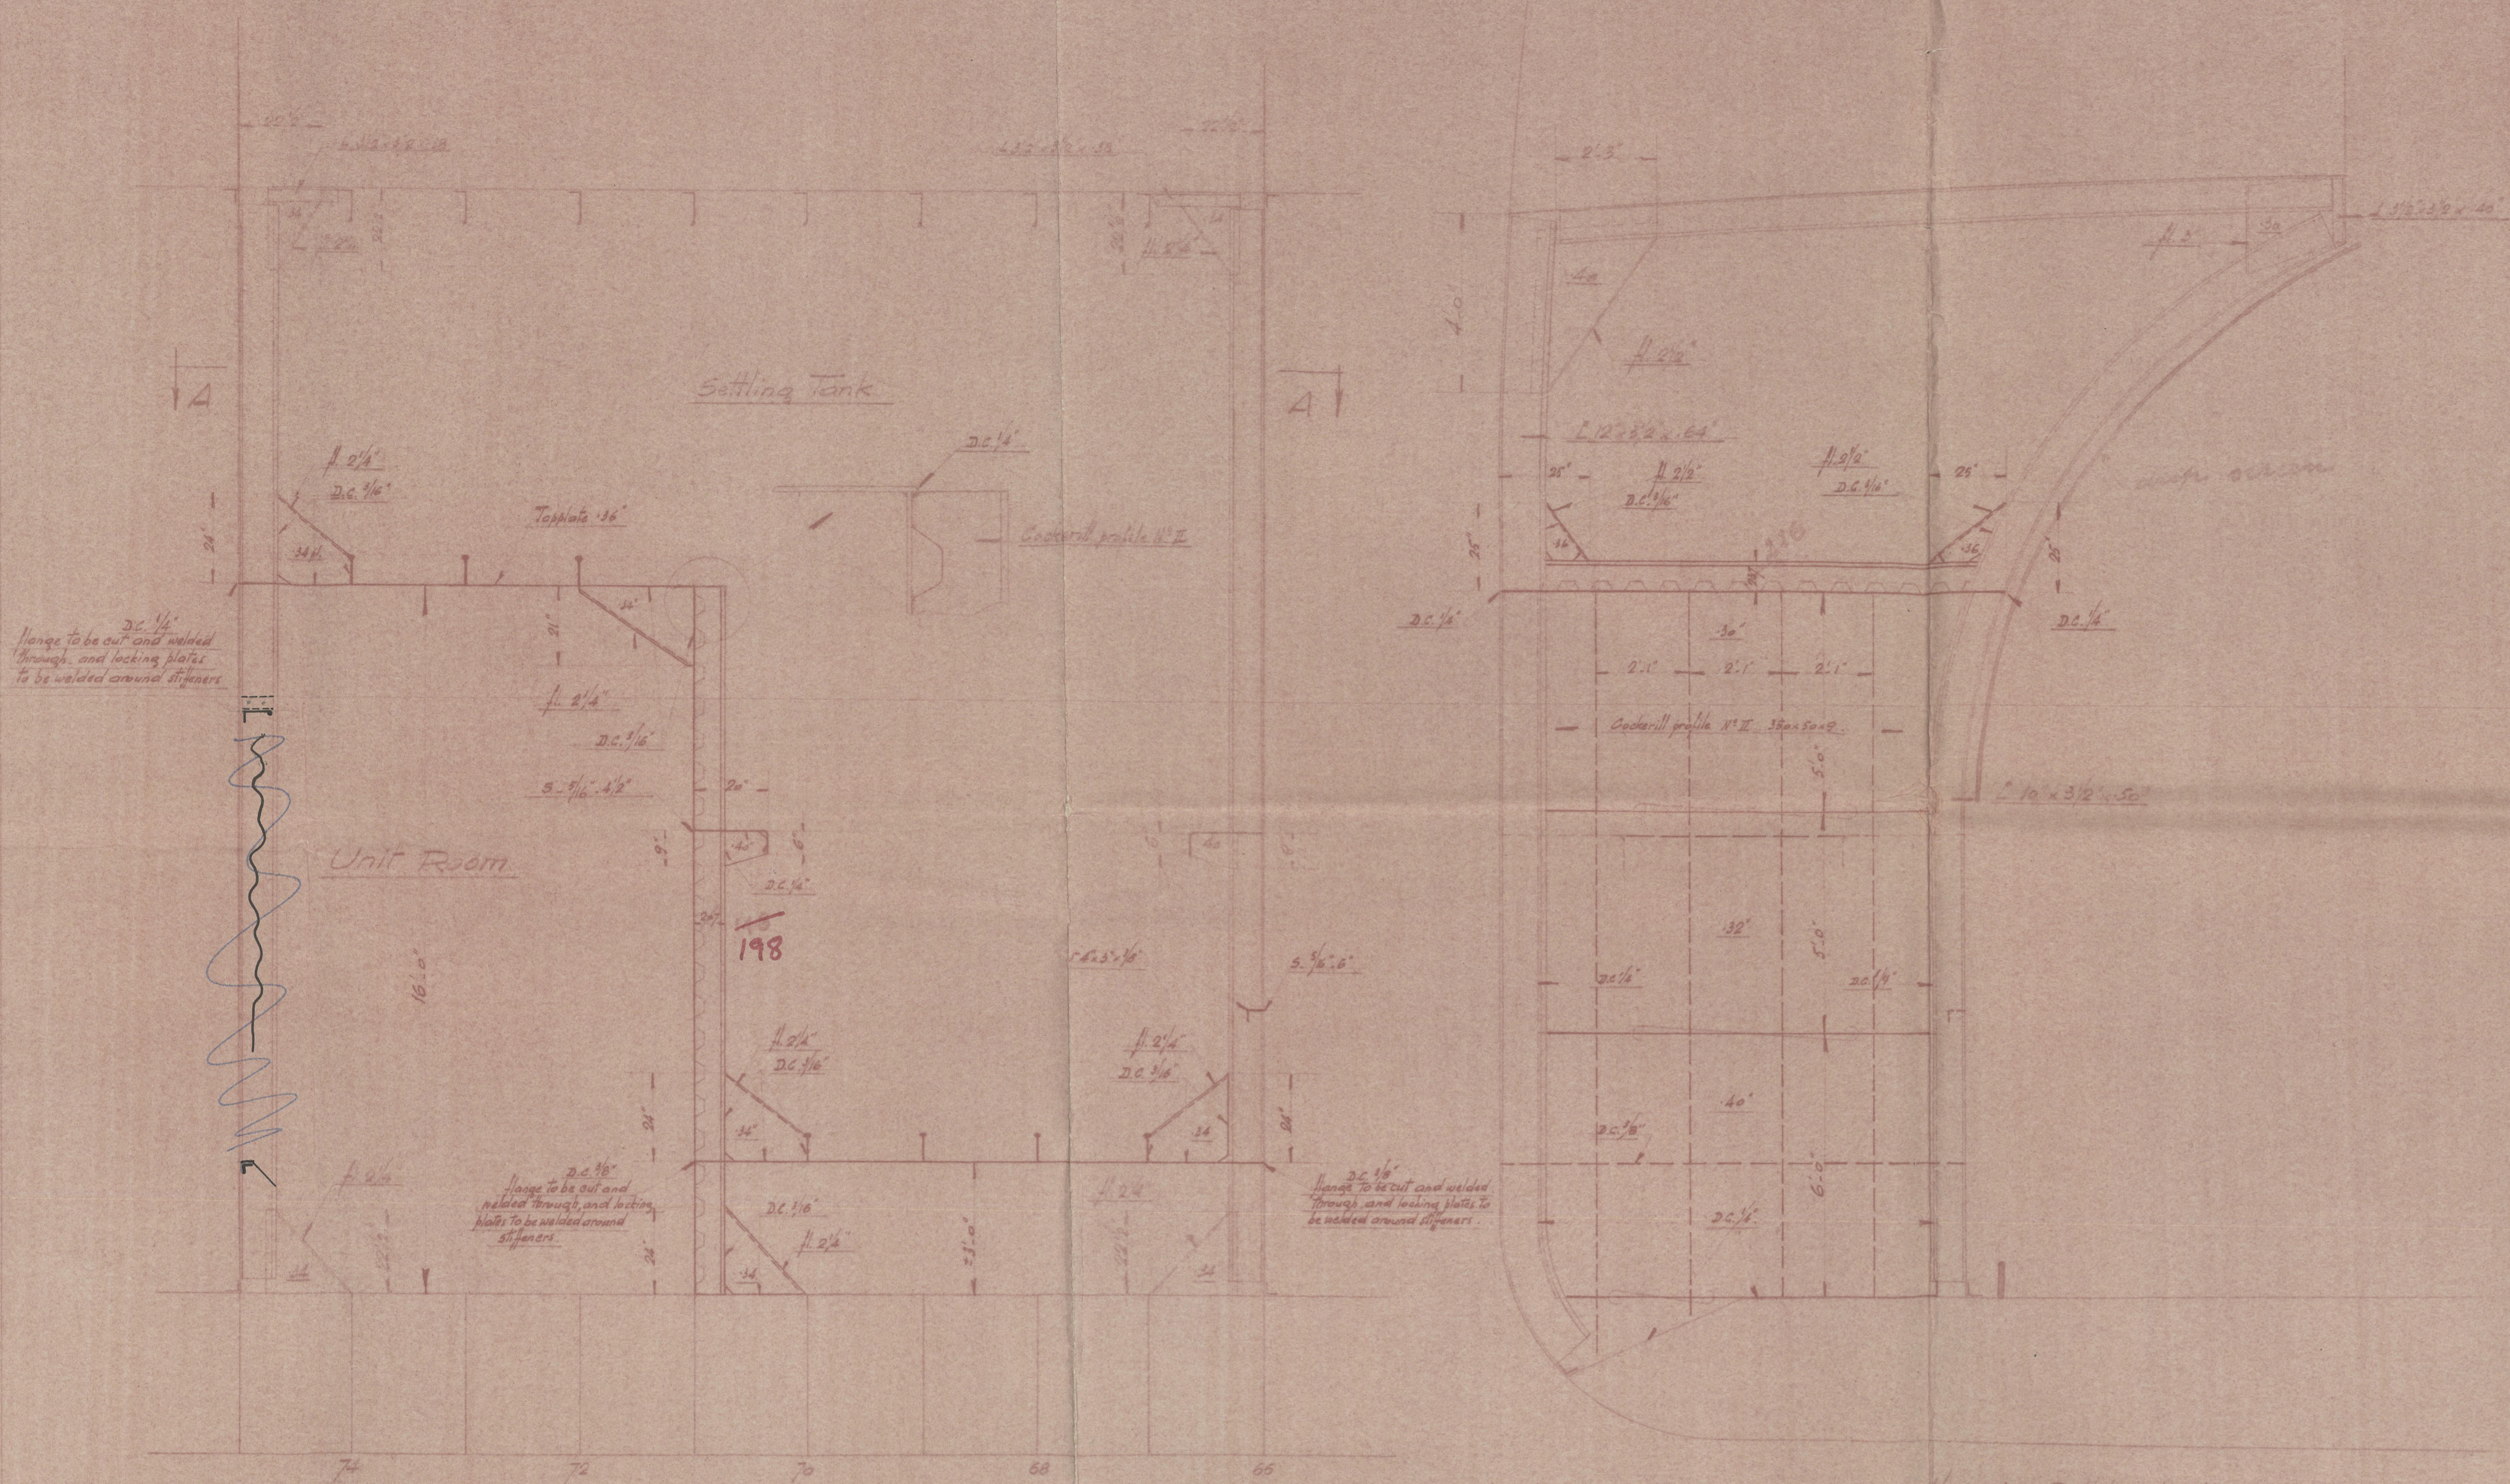

The relevant requirements of Sec. 20 clause 12 of the Rules to be complied with.

3/1/51

Mr. Harcourt M.S. 26466

Alterations to 5th existing W.B. Tank into

Reel Oil Settling Tank

Scale 1/8" = 1' 0"

Drawn 1/2 6666-15.1

TO ACCOMPANY Amendment REPORT No. 26466

DATED Jan 1951

"Marietta"

Alterations of stbd. side
W.B. tank into deck
tank



© 2020

Lloyd's Register
Foundation

004906-004917-0022