


SUNDERLAND SHIPBUILDING CO. LTD.
DRAWING OFFICE.
No. 12452 5 FEB. 1909
SUNDERLAND.

No. 253 1/2. PROFILE.

PRINCIPAL DIMENSIONS 250'-0" LBP x 42'-6" B.M. L x 18'-6" D.M.L.
CLASS B.S. * WITH FIXED FREEBOARD 14'-0" DRAFT (FRESH WATER)
SCALE 8"=1'

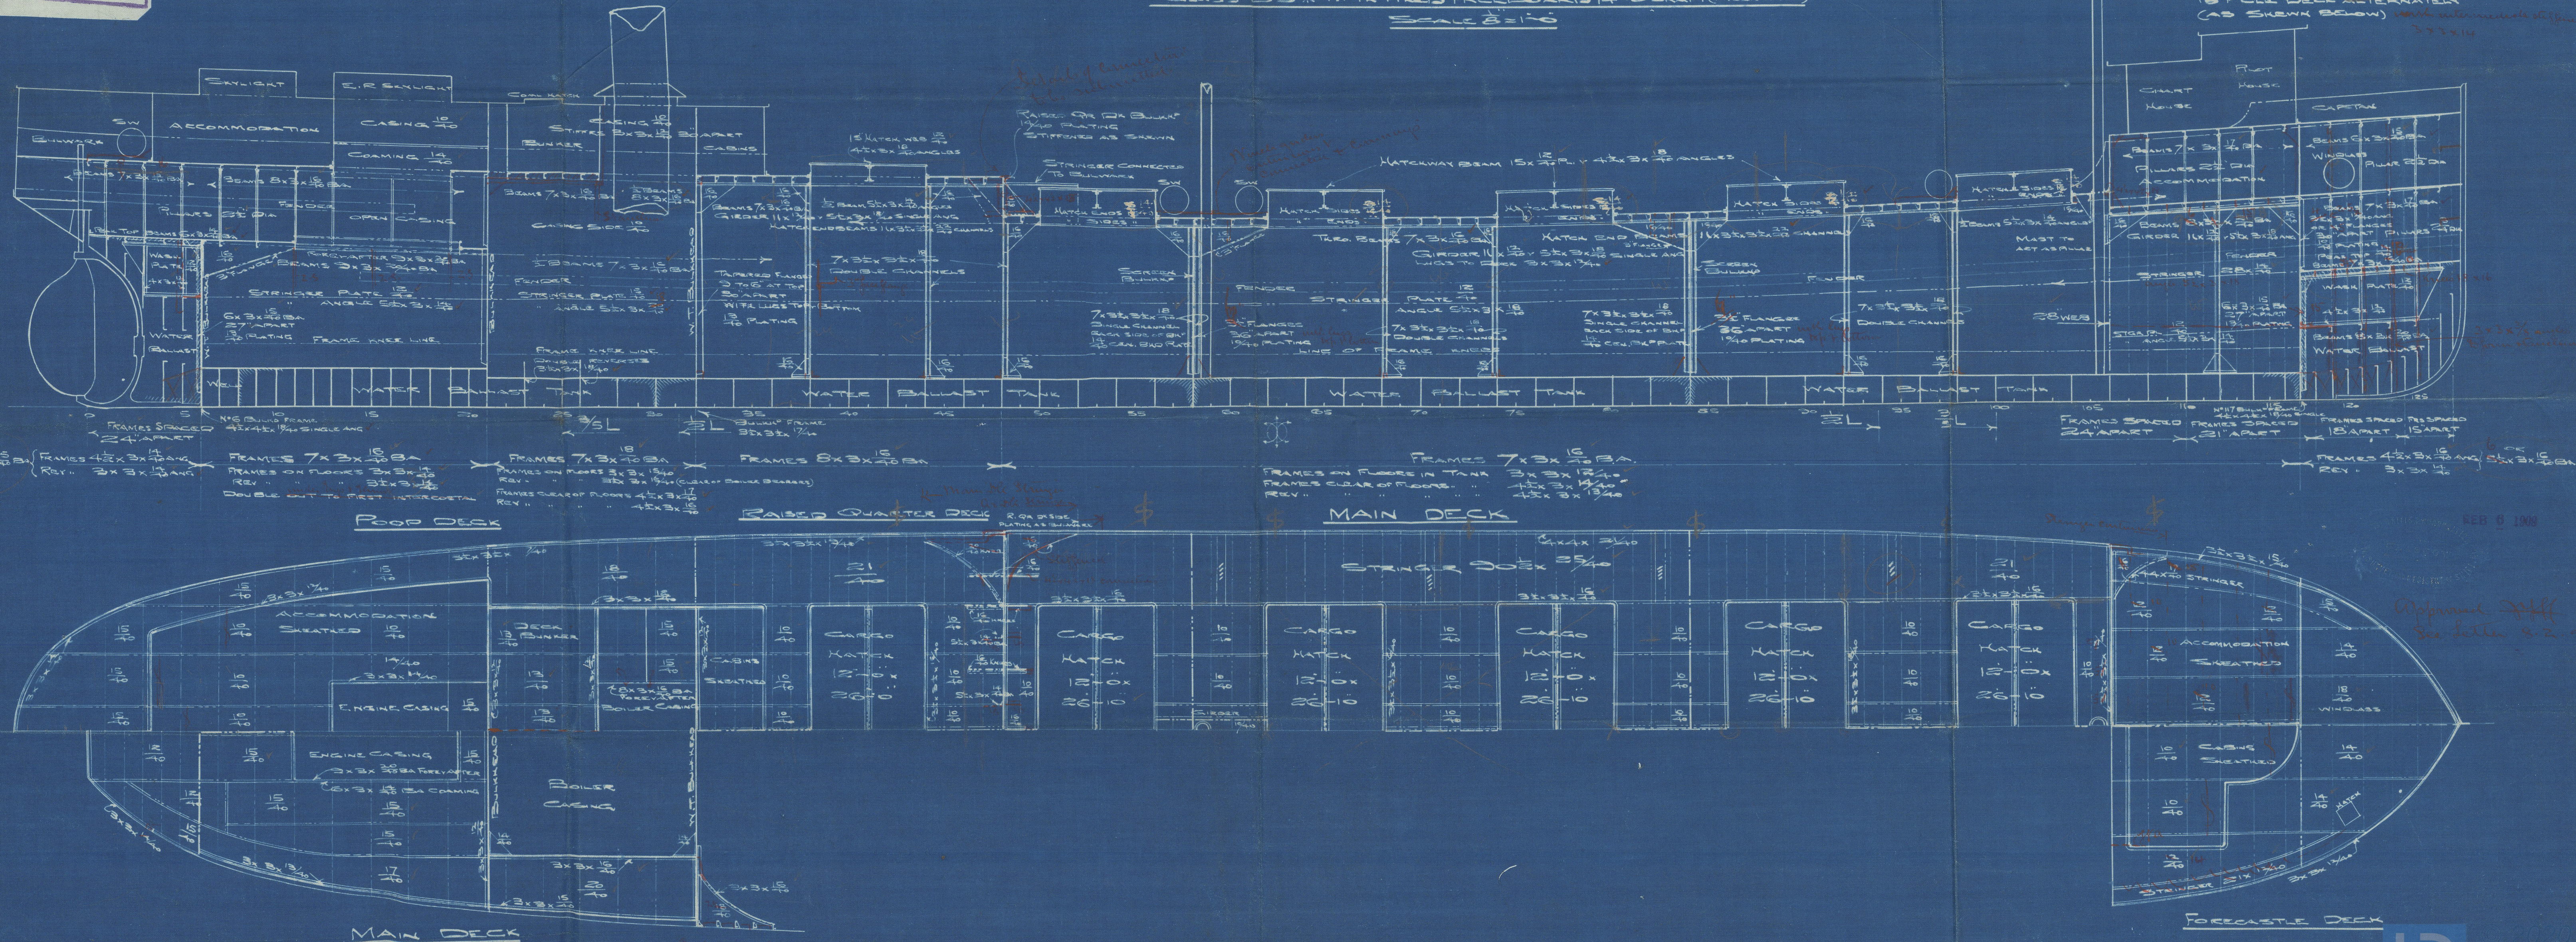

NOTE: MAIN FRAMES TO EXTEND TO POLE DECK ALTERNATELY (AS SHOWN BELOW) WITH MINIMUM 1/2" STEEL

FEB 9 1909

Approved J.H.H.
See Letter 2.2.9



Sunderland. S. & Co 253

Profile & Deck

S.S. Mafleton.

now Eastern Med

T. C. 2.4-2.09

W. & Mallett



004906-004917-0156



© 2020

Lloyd's Register
Foundation