

No 405.

S.S. WYCHWOOD.


PROFILE & DECKS.

PLAN AT TOP OF HATCHES.

Scale :- 1/8" = 1 foot.

B. P. AUSTIN & SON, LTD.
SHIPBUILDERS & REPAIRERS,
SUNDERLAND.
Date 11/1/38
Reference No. 1010

DIMENSIONS		ERECTOR'S	
LENGTH BETWEEN PERPENDICULARS	298'-0"	POOP	26'-0"
BREADTH MOULDED	44'-0"	BRIDGE	79'-5"
DEPTH MOULDED TO UPPER DECK	21'-6"	FORECASTLE	25'-5"
BRIDGE	8'-0"		
POOP & FORECASTLE	7'-6"		
SHEERS:- 3'-6" AFT (PARABOLIC)	7'-6" FWD		
		TOTAL	131'-5"
		NUMERALS	LAD : 6407
		L (870) = 19742	L (UPPER DECK) = 1386'
		L (BRIDGE DECK) = 1010'	

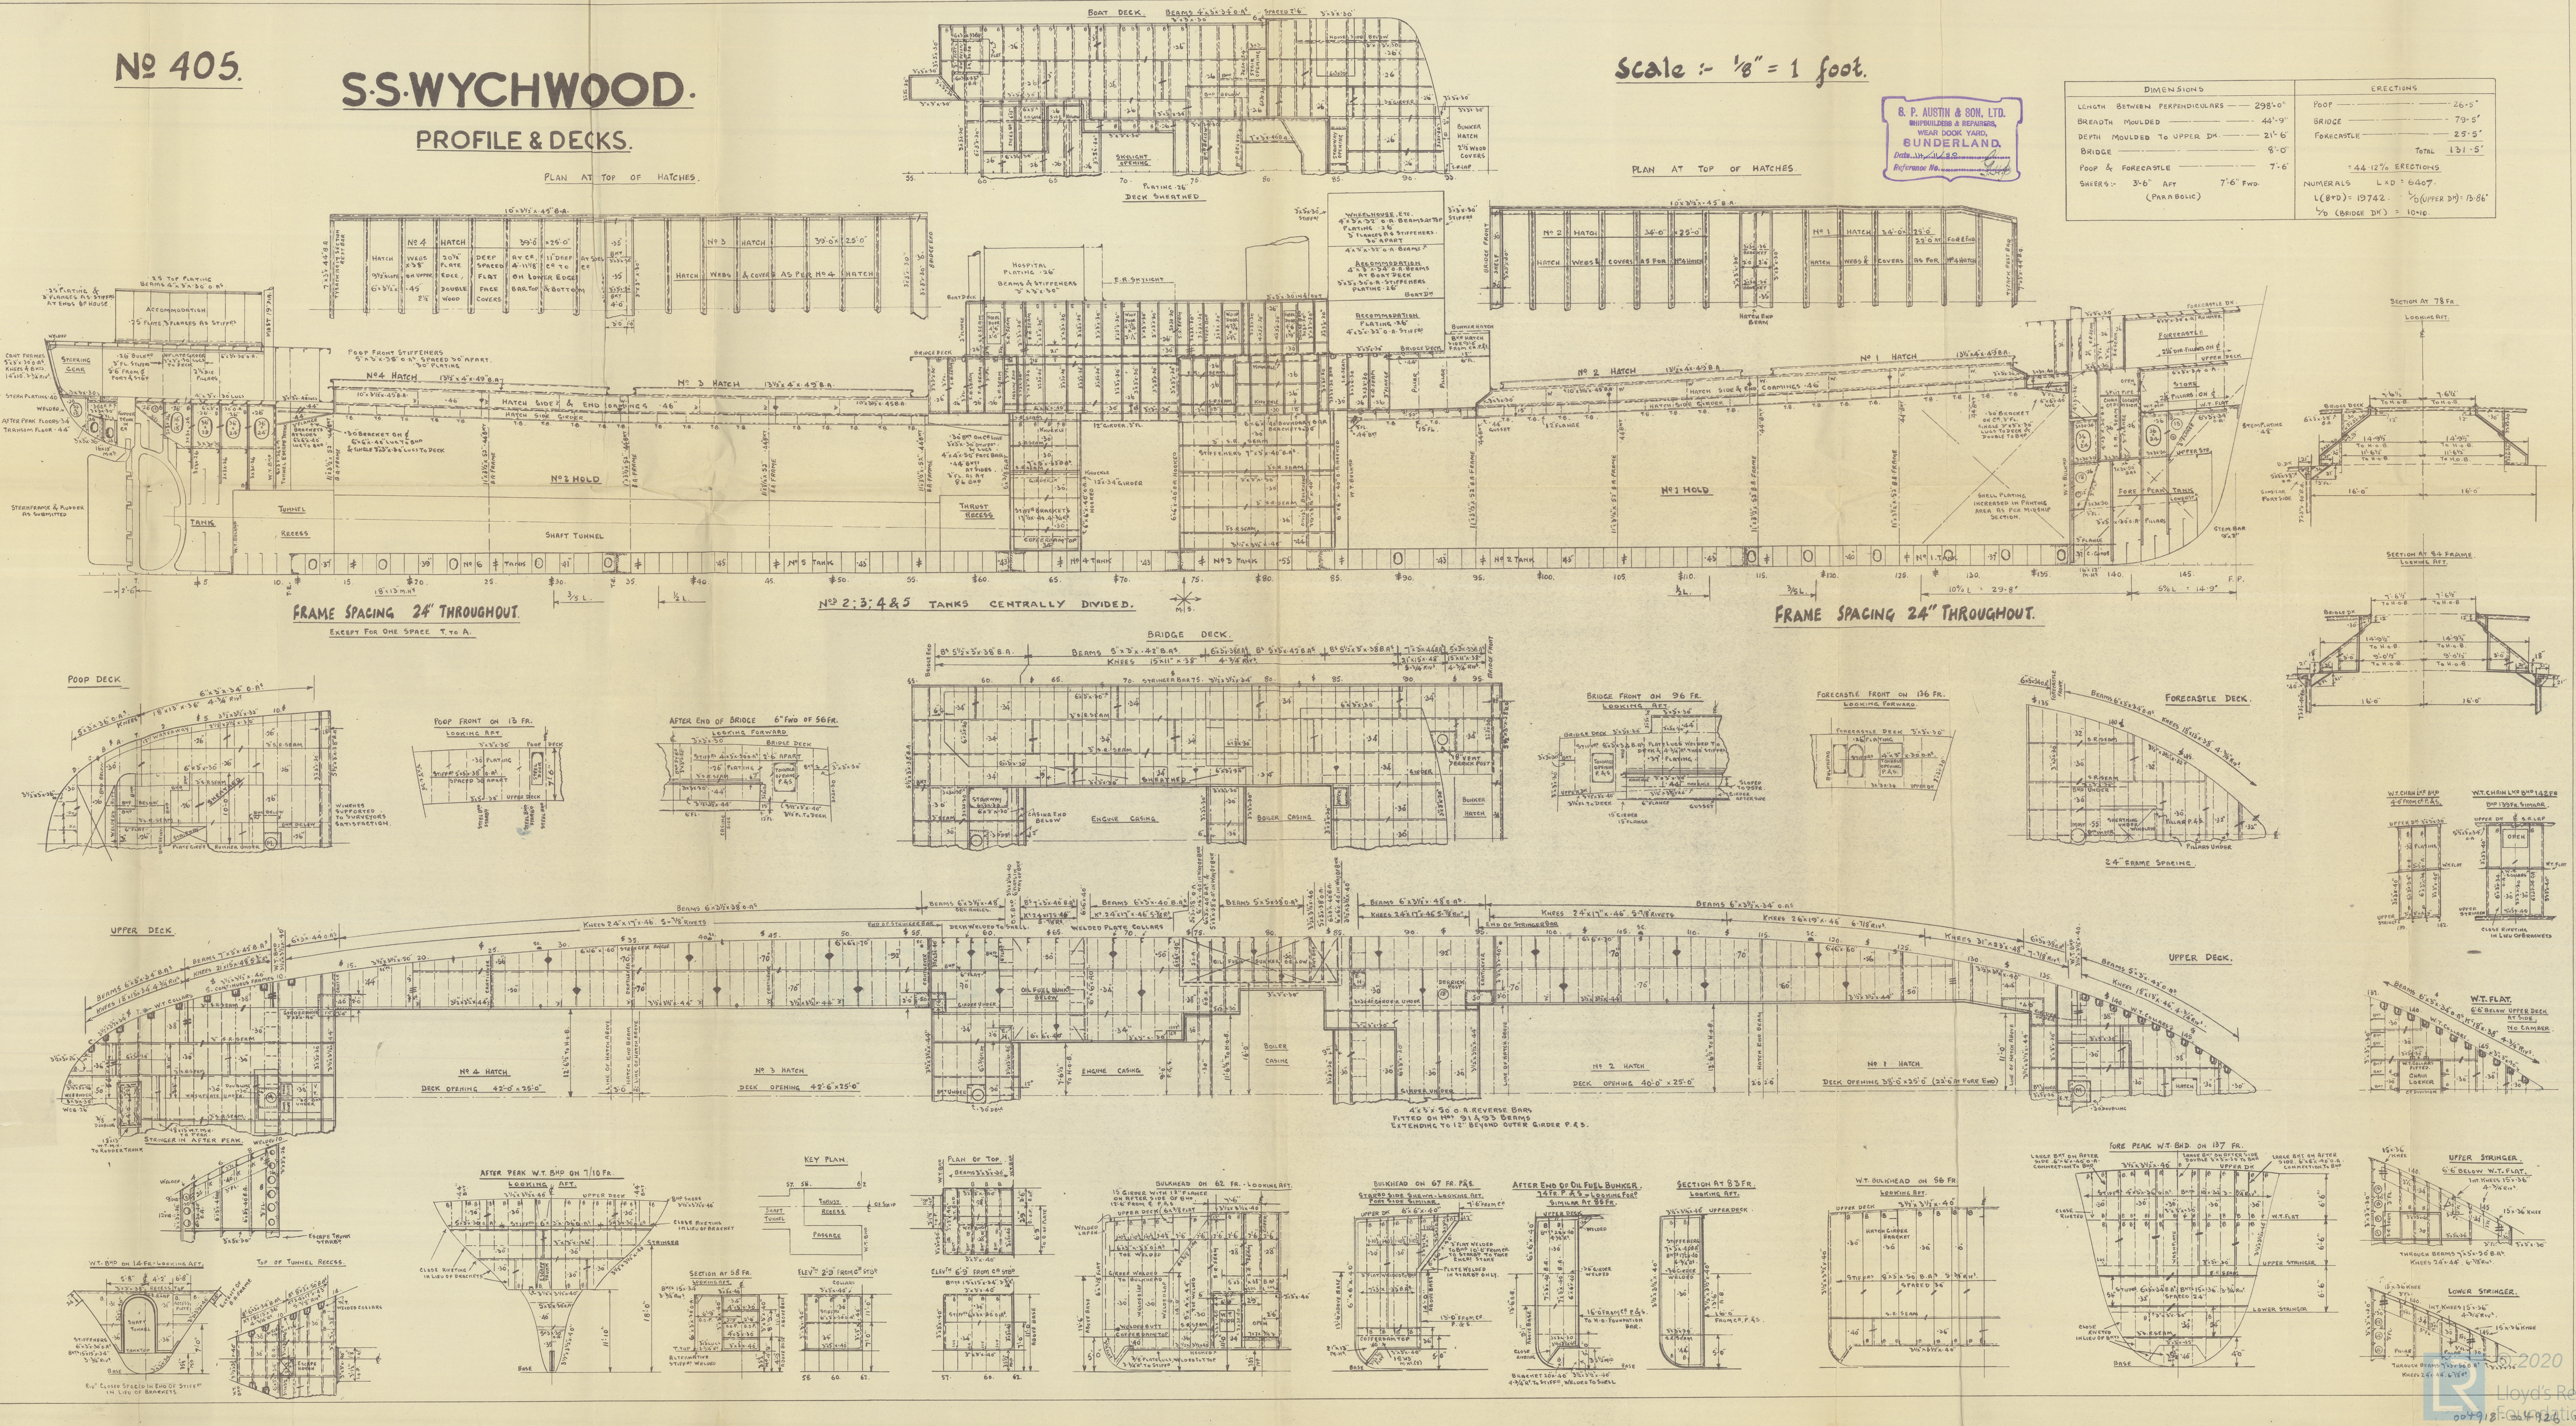

WRECK
SECTION
No. 1082

SUNDERLAND RPT. NO. 35457.

S.D. Austin 405

S.S. "Wychwood"




PROFILE + DECKS. as built

RECORDS DEPT.,
LONDON

2

RETAIN

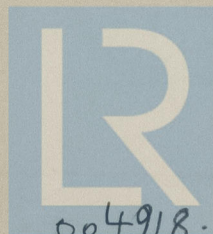

© 2020

Lloyd's Register
Foundation

004918.004926.0079