

No 179. "Algol"

TO CLASS 100.A.I. AT LLOYDS. "PARTIAL AWNING DECK."


## LLOYDS DIMENSIONS

LENGTH FROM FORE SIDE OF STERN POST TO AFTER SIDE OF STEM	278.29
BREADTH MOULDED	39.70
DEPTH TO SKIN ASSUMING 10" ROUND UP OF BEAM.	20.33
DEPTHS TO LENGTH	13.6

$\frac{1}{2}$  GIRTH 36.33  
 $\frac{1}{2}$  BREADTH 19.85  
 DEPTH 20.33  
 76.51 = GRADES 76/80  
 278.29  
 ✓ 2129.96 = GRADES 199/21300

8 ) 1291.96 ✓  
 2661.48 ✓  
 23953.44  
 50x = 345.99  
 1/3 24299.43 = GRADES 24220  
 27140

2 BOWER ANCHORS 40 CWT STOCKLESS  
1 " " 34  
1 STREAM " 10½ " EX STOCK  
1 KEDGE " 5½ " " "  
240 FATHOMS 1½" STUD CHAIN CABLE  
75 " 4½" STEEL WIRE  
TOWLINE, HAWBSERS & WARPS AS PER TABLE 22

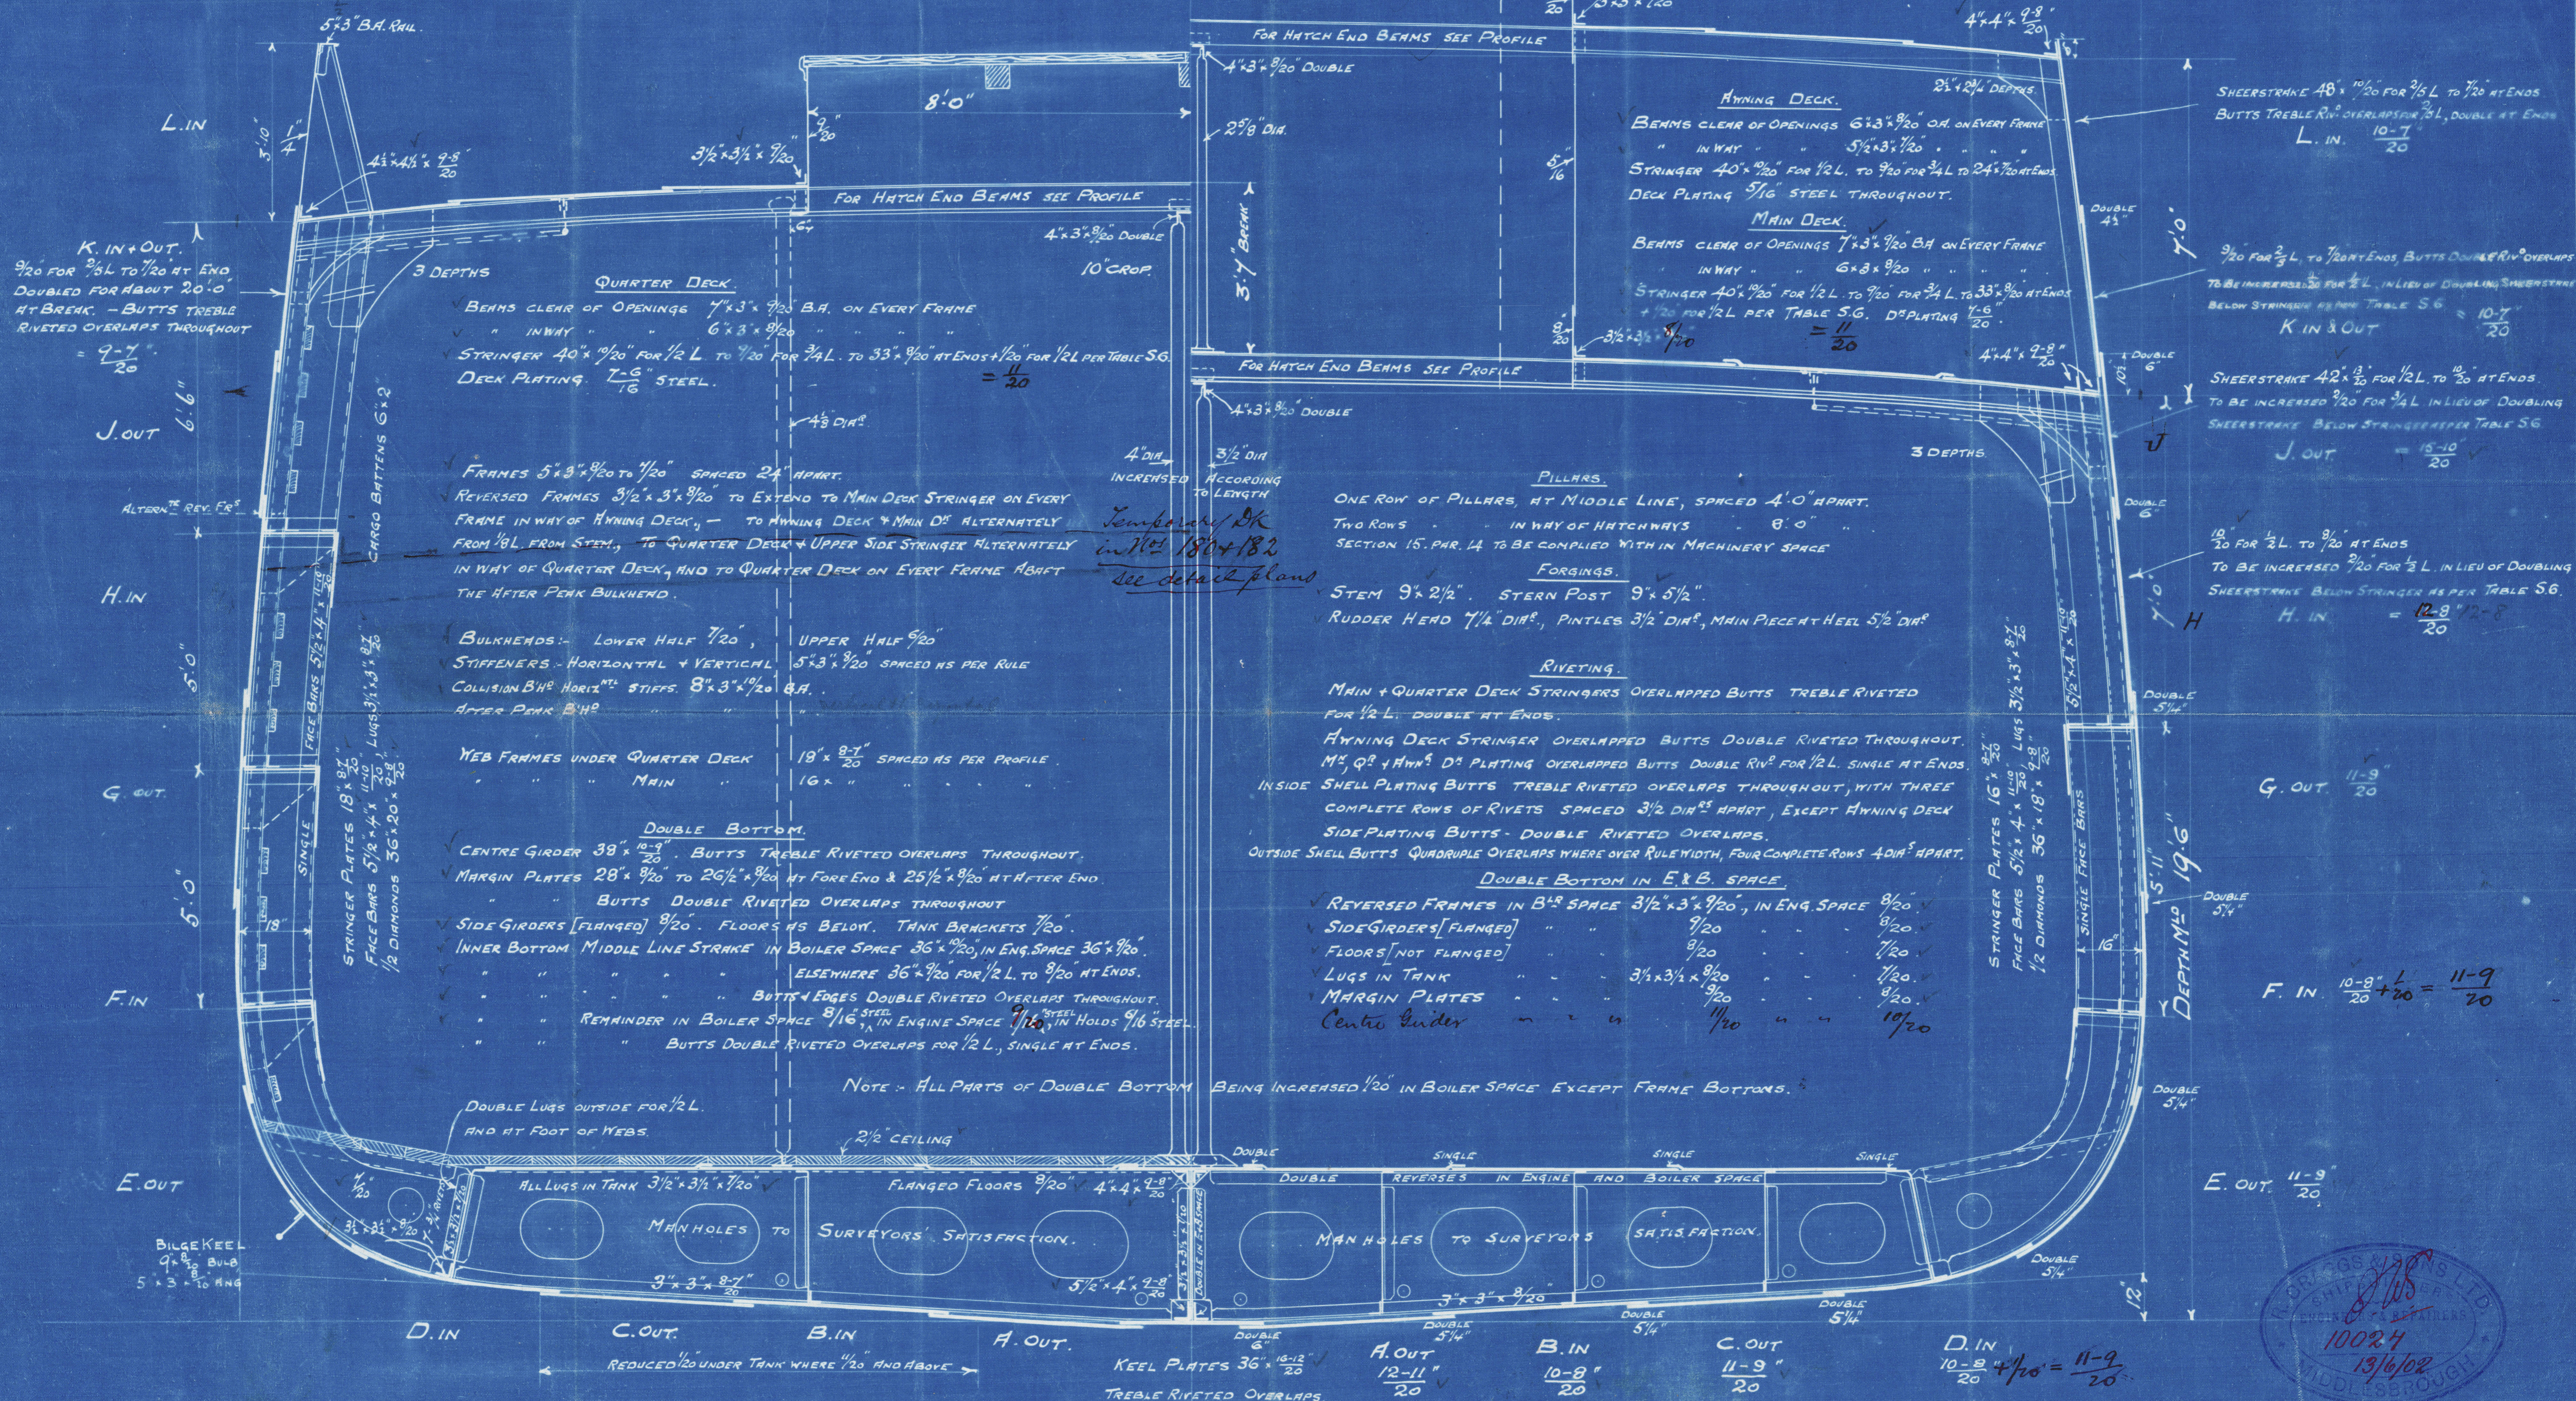

R. CRAGGS & SONS LIMITED  
SHIPBUILDERS & REPAIRERS  
TEES DOCKYARD  
MIDDLESBROUGH.



NOTE: B+C STRAKES SHELL TO MAINTAIN MIDSHIP THICKNESSES TO COLLISION BULKHEAD,  
FRAME BOTTOMS DOUBLED & ADDITIONAL GIRDER 14" DEEP FITTED FROM  $\frac{3}{5}L$  FOR  $2^\circ$  TO COLLISION B/H.

LLOYD'S REGISTER OF SHIPPING  
17-6-07  
W.H.

20/6/02

179. ALSO 180.  
181-2.

*R. Craggs & Sons*  
*No 179-180-181+182*  
*Midship Section*

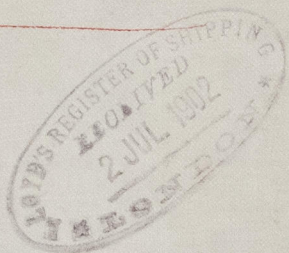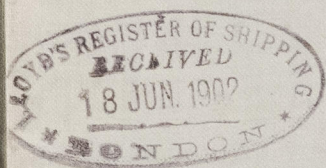

*No 179. "Algol"*

*Mdb report No 3473*

*No 180 - "Hektos"*

*Mdb rpt. No 3534*

*No 181 "Leo"*

*Mdb report No 3567*

*No 182 - "Hesperus"*

*Mdb report No 3579*



© 2020

Lloyd's Register  
Foundation

004946-004953-0150