


18.137

PROFILE & DECKS
OF STEEL SCREW TRAWLERS
LENGTH 170'-0" B.P. x 28'-6" B.M.L.P. x 15'-6" D.M.L.P.
NO. 625 AND 6 SHIPS
SCALE 1/4" = 1 FOOT
TO CLASS 100.A.I. STEAM TRAWLER

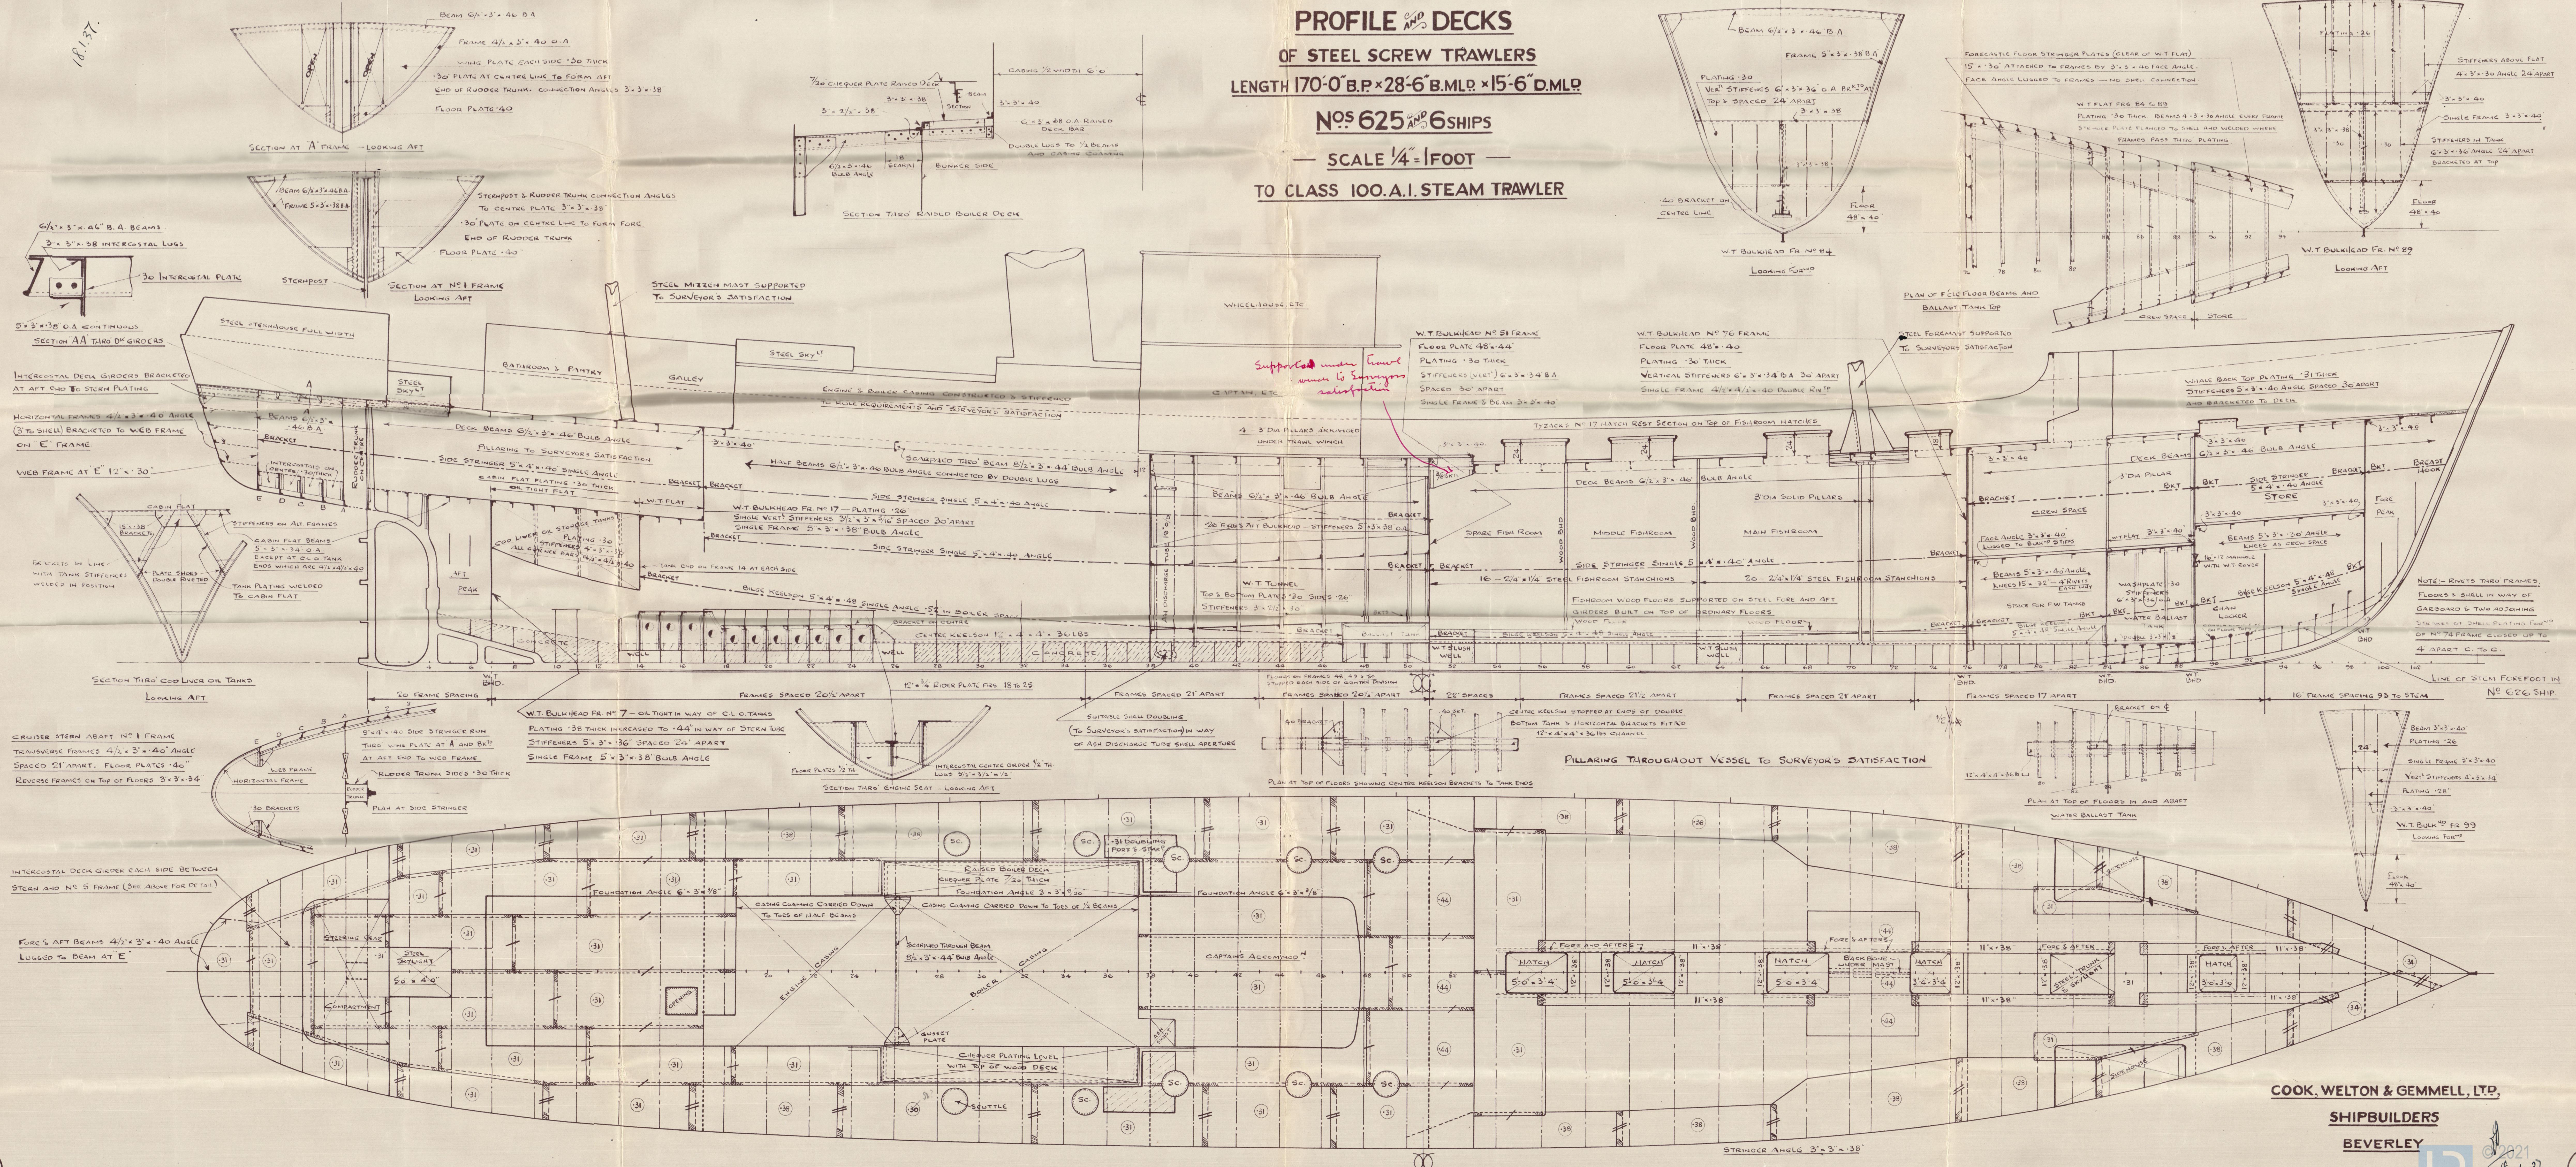

COOK, WELTON & GEMMELL, LTD.,
SHIPBUILDERS
BEVERLEY

RETURN

HULL

books, Walton & Gemmell Co.

See Amended
Plan

with 600 live founts

Land No. 625 + 626

Profile and Deck

Lady Edso



Italian Caesar

El Capitan

Discharge Bay 217
Section 2

004954-004961-0295



© 2021

Lloyd's Register
Foundation