



SHIP N° 656. VIZALMA

MIDSHIP SECTION.

PRINCIPAL DIM^{NS} 175'-0" B.P. x 30'-0" MLD x 16'-0" D. MLD.

CLASS. 100 A.I. STEAM TRAWLER.

SCALE $\frac{1}{2}$ " = 1 FOOT.

EQUIPMENT.

- 1 STOCKLESS ANCHOR 13 CWTs
1 " " 12 CWTs
1 RODGERS ANCHOR $4\frac{1}{2}$ CWTs (EX STOCK)
150 FATHOMS $1\frac{5}{16}$ " STUD LINK CABLE
60 FATHOMS OF 6" HAWSER } COMBINATION WIRES
60 " " 6" WARP } OR AS PREVIOUSLY APPROVED


LLOYDS NUMERALS

D	16.00
B+D	46.00
L x D	2800.00
L x (B+D)	8050.00
d	14.41
L/D	10.94
L/B	5.83

COOK, WELTON & GEMMELL LTD


SHIPBUILDERS

BEVERLEY

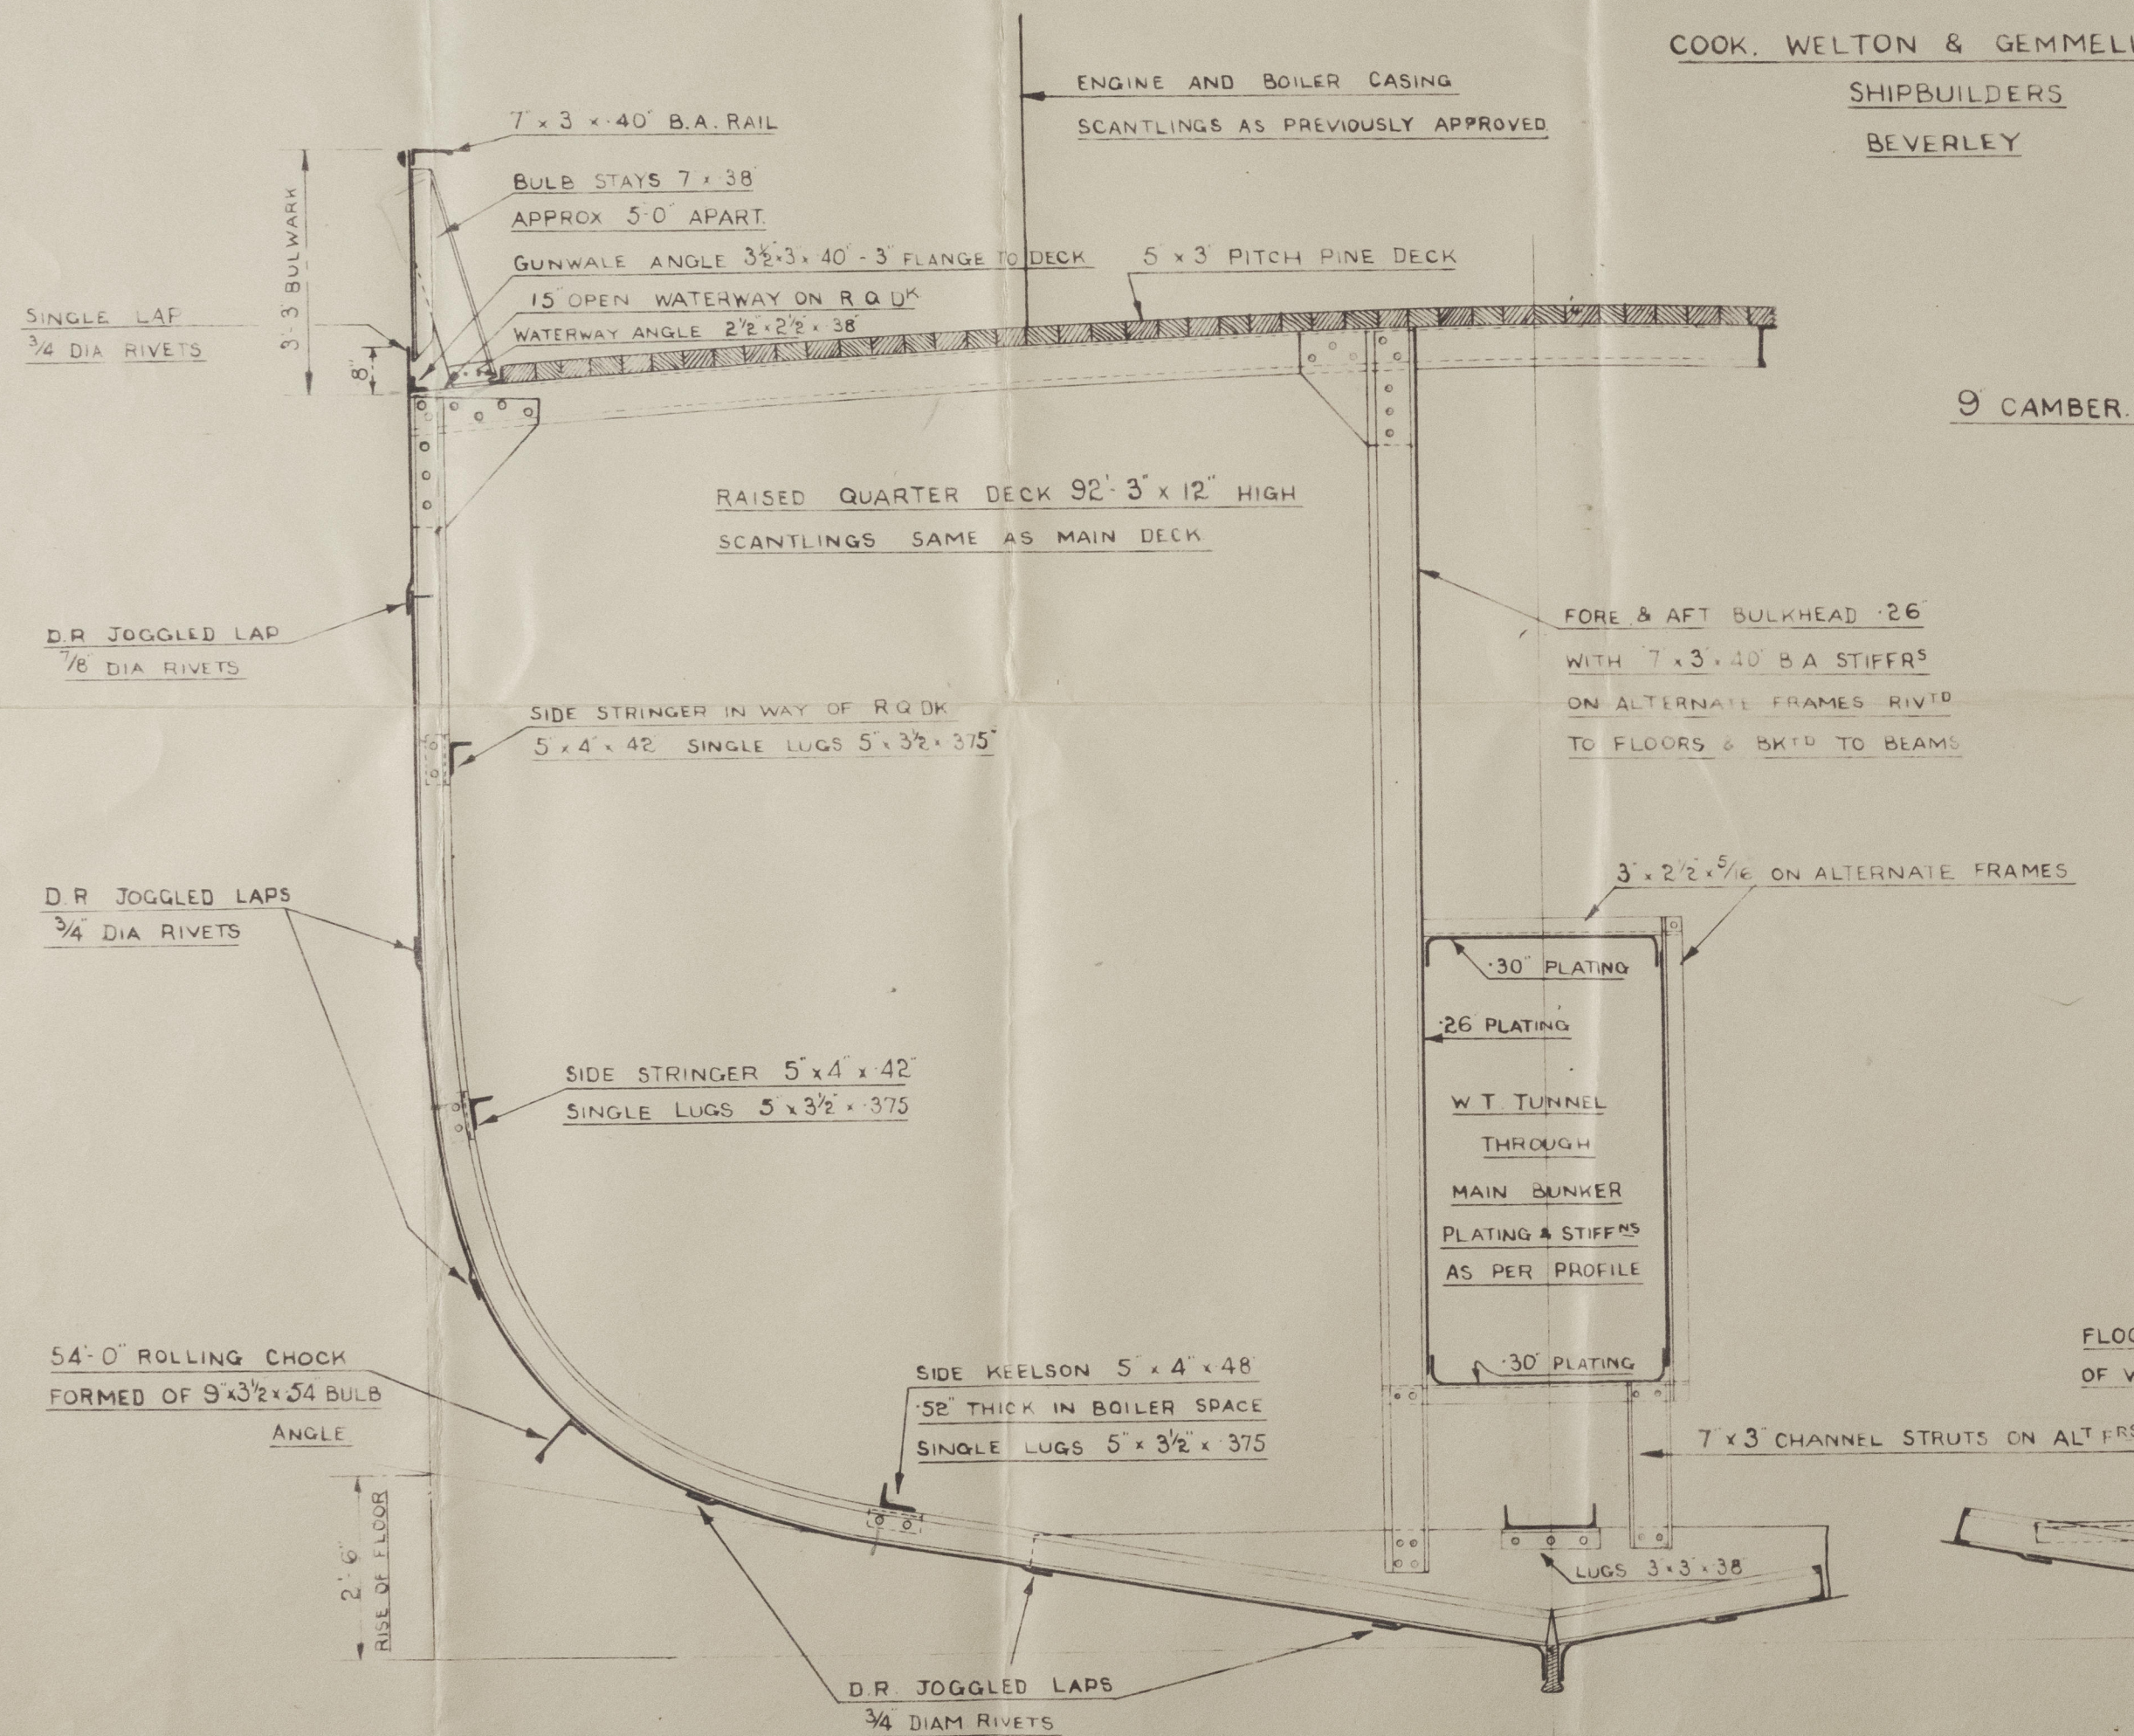

NOTE SHELL BEADINGS ELECTRICALLY
WELDED ON IN LIEU OF RIVETING

SECTION THROUGH MAIN BUNKER.
RAISED QUARTER DECK.

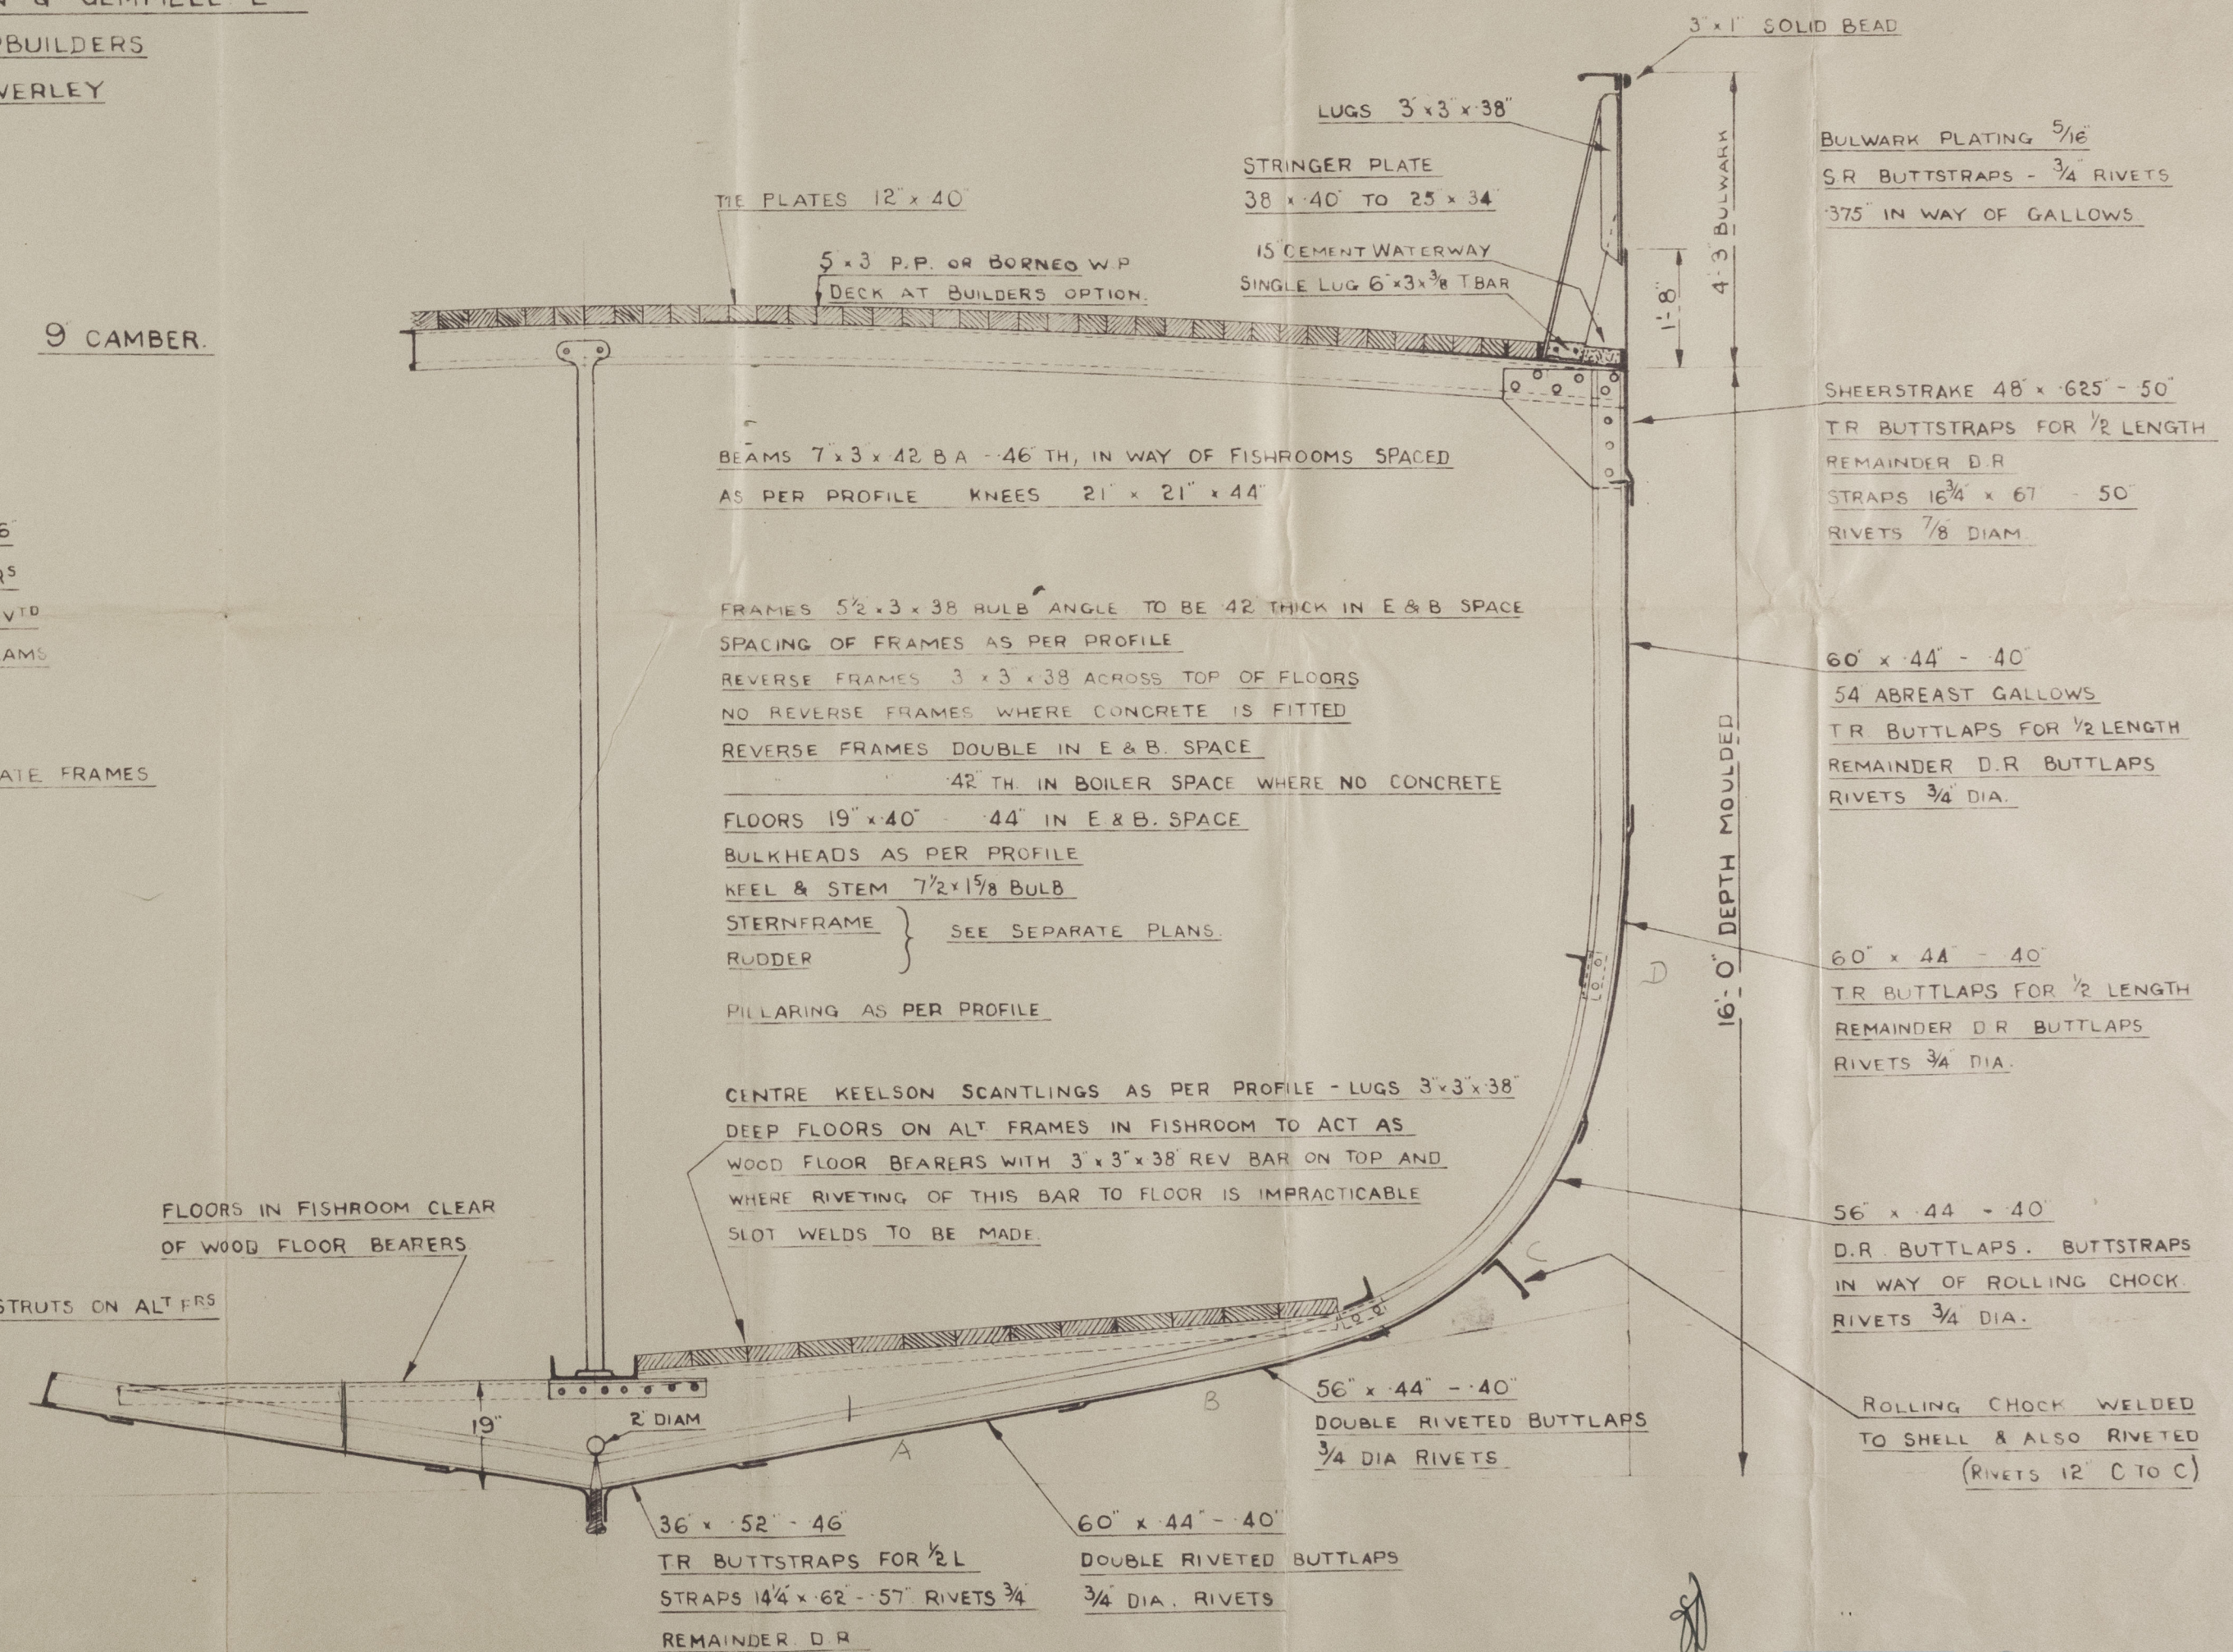

SECTION THROUGH MAIN DECK.

Lloyd's Register Foundation

HULL

Book, Pelton Hammett, Ltd.

Beverly

Yard No. 656

Midship Section

"VIZALMA"

50837



© 2020

Lloyd's Register
Foundation

004962-004970-0107