


1.12.06


10,440

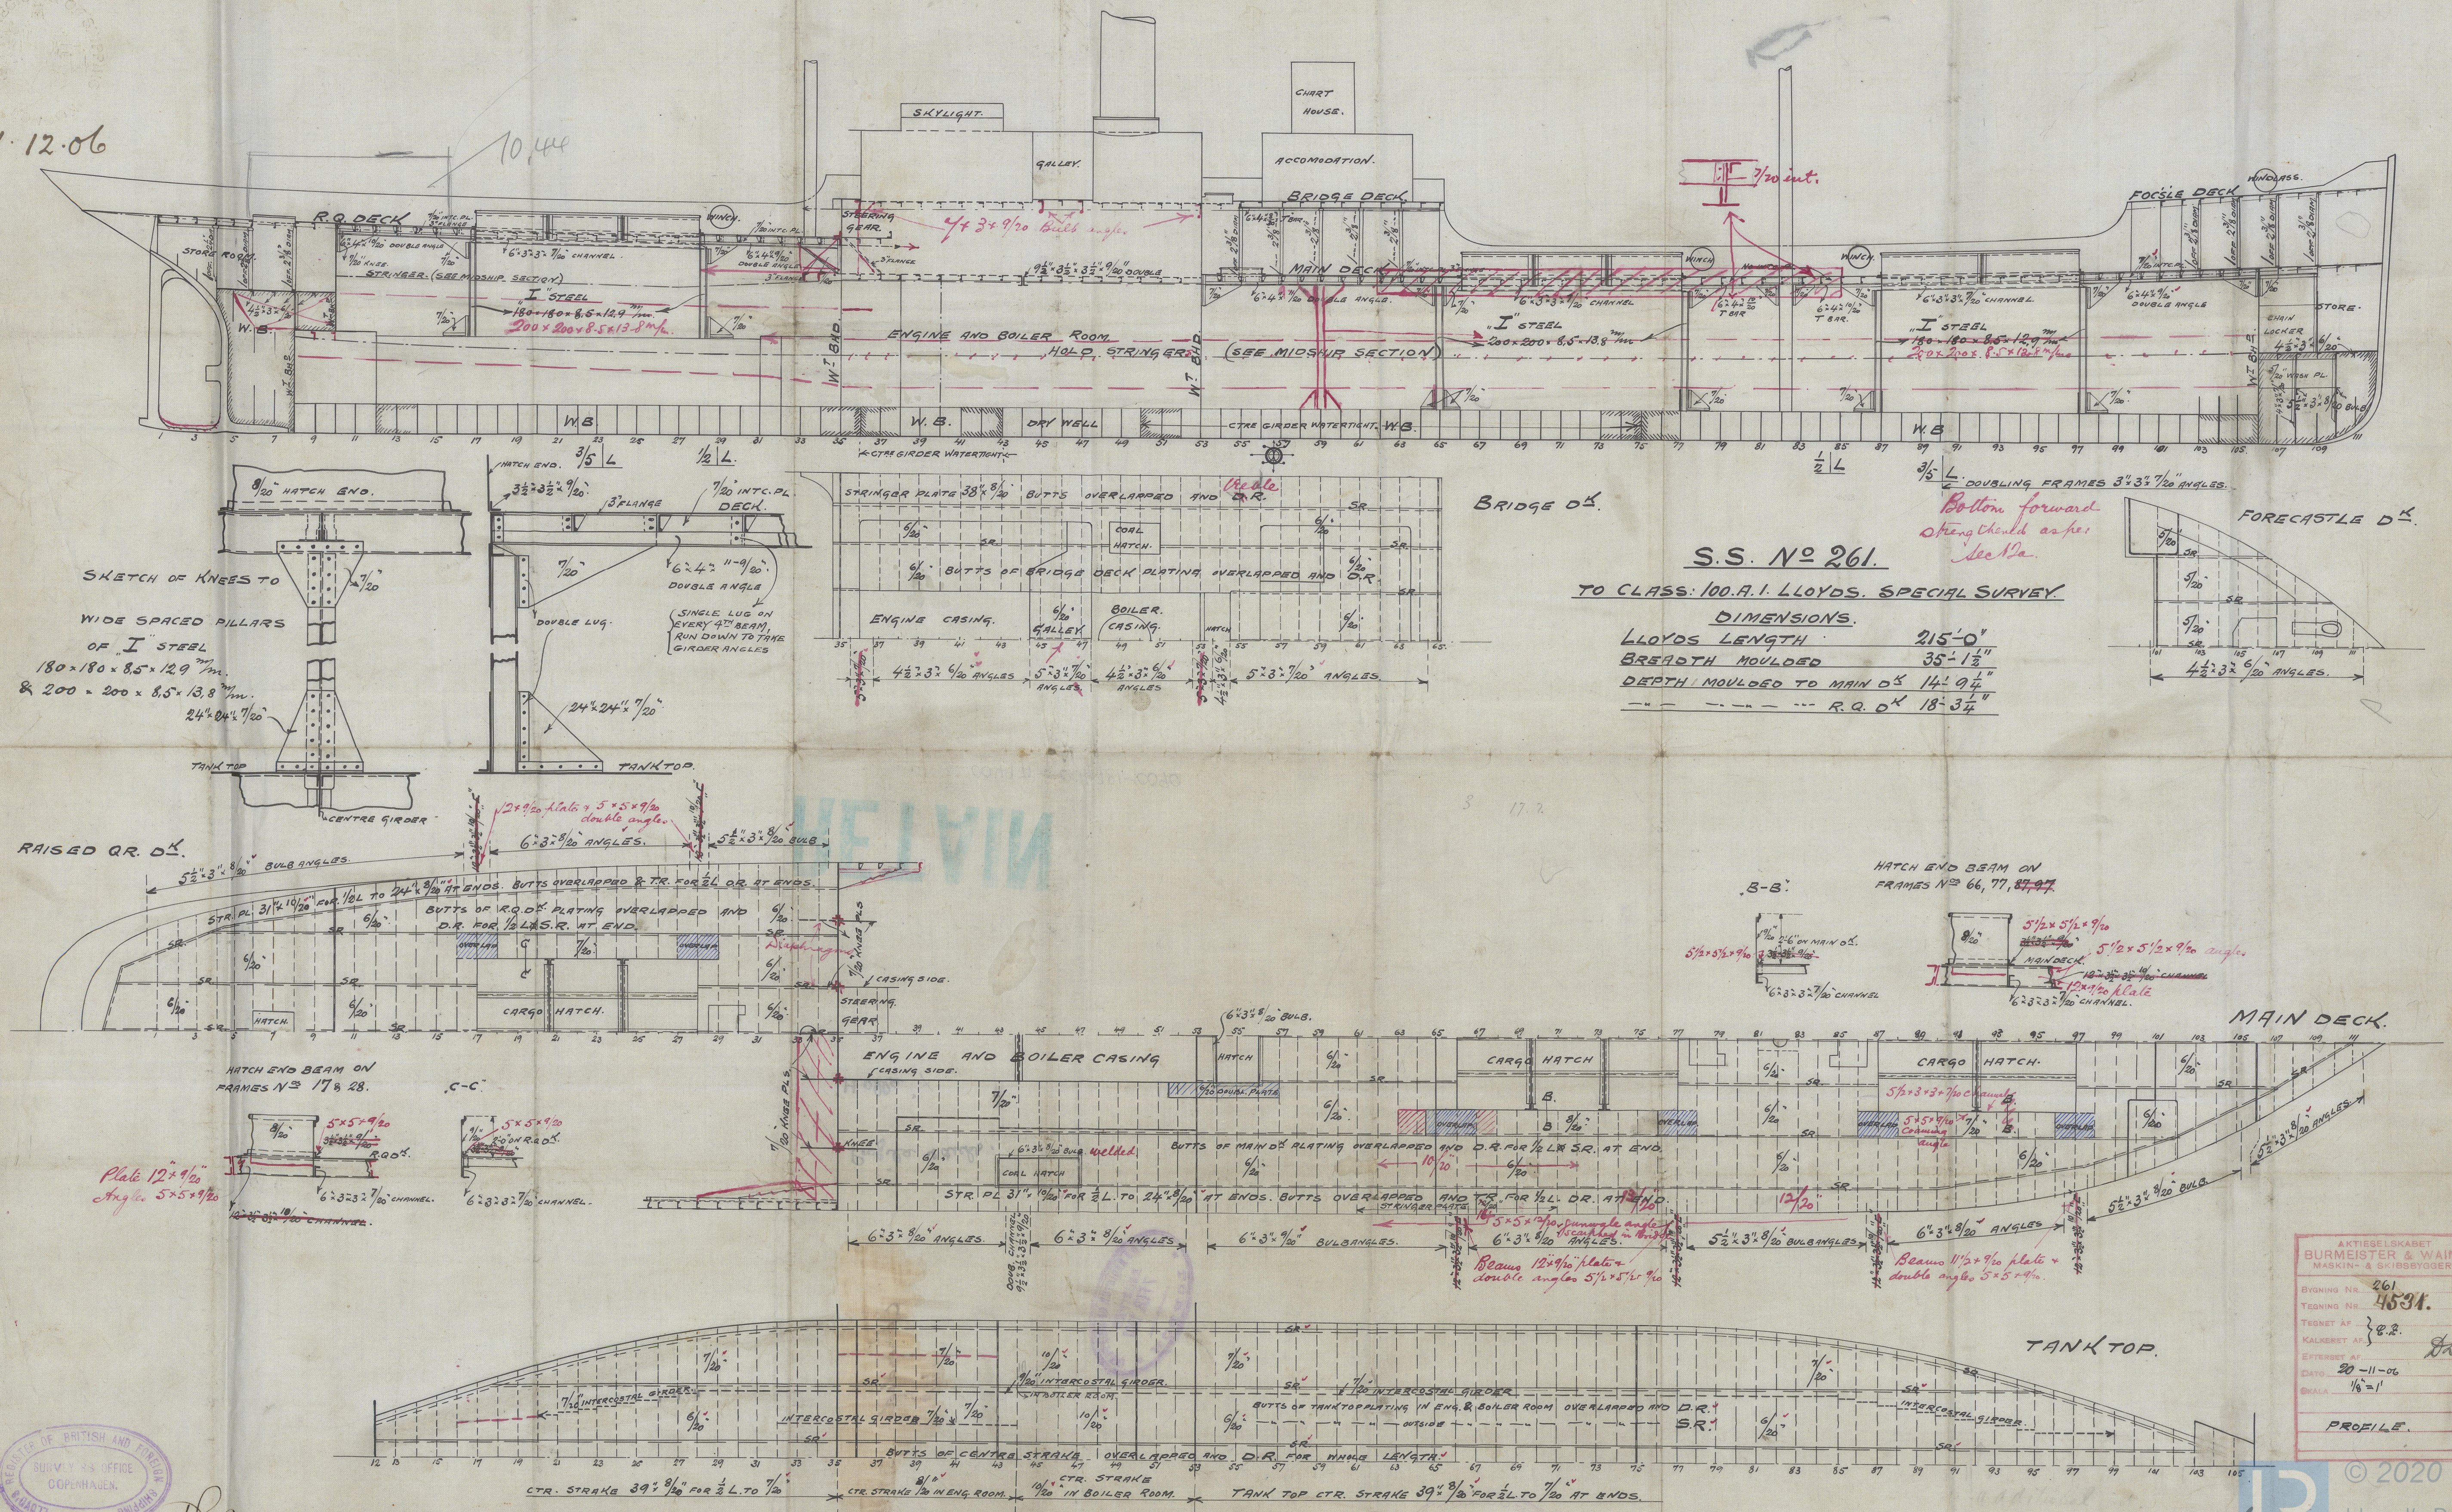


S.S. N° 261.

TO CLASS: 100.A.I. LLOYDS. SPECIAL SURVEY.

| DIMENSIONS.                          |                                |
|--------------------------------------|--------------------------------|
| LLOYDS LENGTH                        | 215'-0"                        |
| BREADTH MOULDED                      | 35'-1 1/2"                     |
| DEPTH MOULDED TO MAIN D <sup>K</sup> | 14'-9 1/4"                     |
| ---                                  | R.Q. D <sup>K</sup> 18'-3 1/4" |

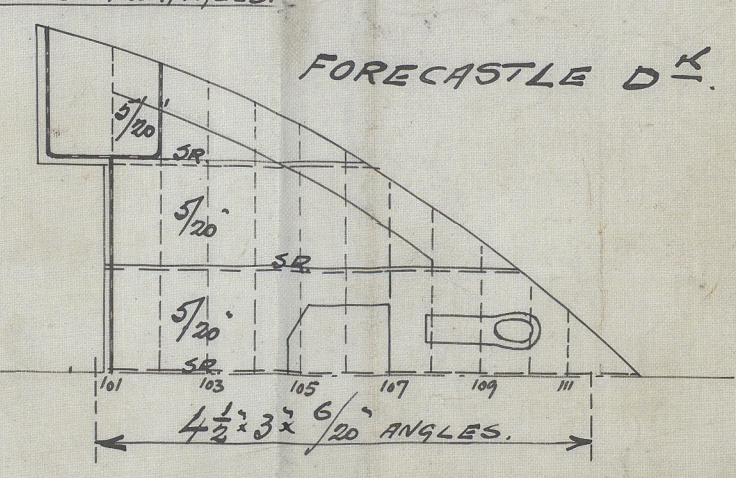

HATCH END BEAM ON FRAMES N° 66, 77, 87, 97.

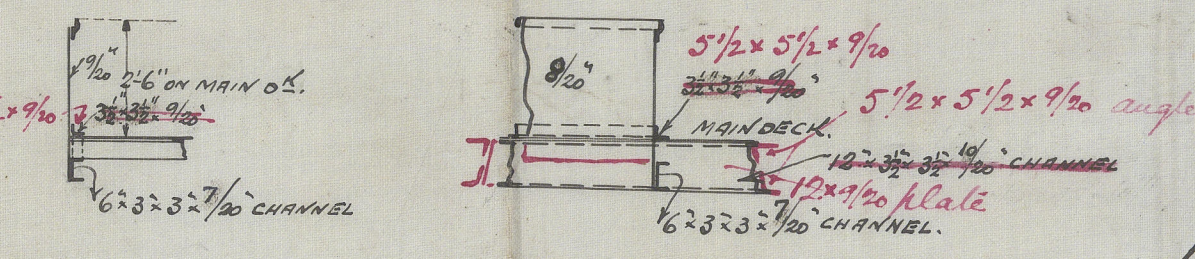

MAIN DECK.

TANK TOP.

|                       |           |
|-----------------------|-----------|
| AKTIESELSKABET        |           |
| BURMEISTER & WAIN     |           |
| MASKIN- & SKIBSVEJER. |           |
| BYGNING N° 261.       |           |
| TEGNING N° 4834.      |           |
| TEGNET AF             | E.S.      |
| KALKERET AF           | J.R.      |
| EFTERSEET AF          |           |
| DATO                  | 20-11-06  |
| SKALA                 | 1/8" = 1' |
| PROFILE.              |           |

22/11-06



11/2/06



Amended



Profile & decks.

'Hella' X




© 2020

Lloyd's Register  
Foundation

004971 - 004981 - 0090