
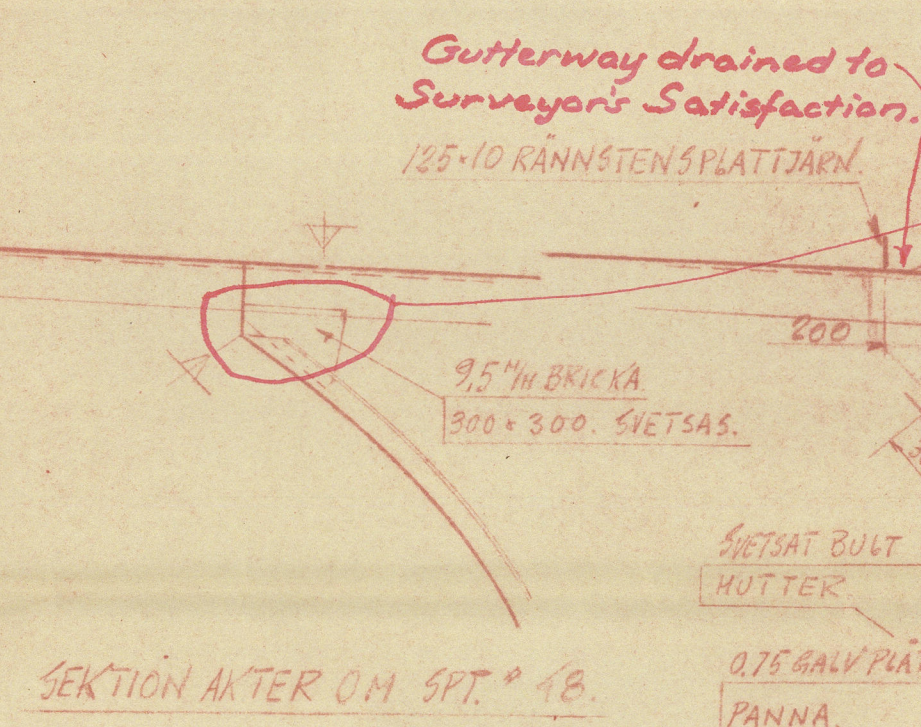


PLAN AV HUVUDDÄCK.

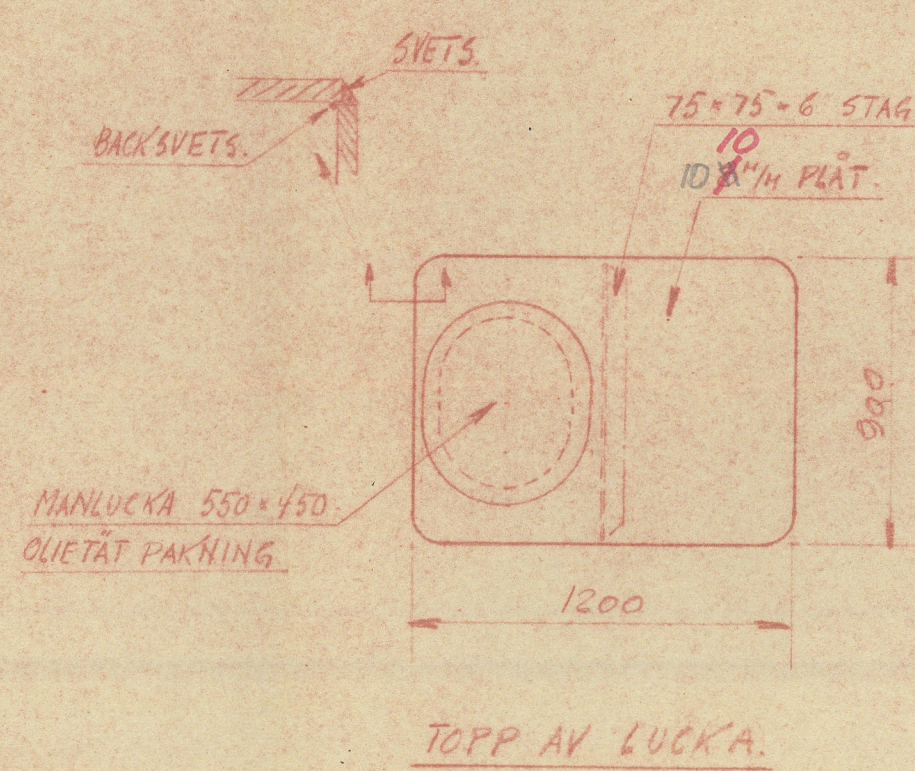


MELLAN BEFINTLIGA STAG PÅ LÅNGSKEPPSSKOTTET OCH TVÄRSKEPPSSKOTTEN INSÄTTAS NYA STAG, SOM SVETSAS FAST.

KOLLUCKORNA I LÅNGSKEPPSSKOTTET BORTTAGES OCH HÅLEN IGENSÄTTAS.

Double bottom under not to be used for fresh water

SEKTION GENOM BUNKERTANK SPT. 51

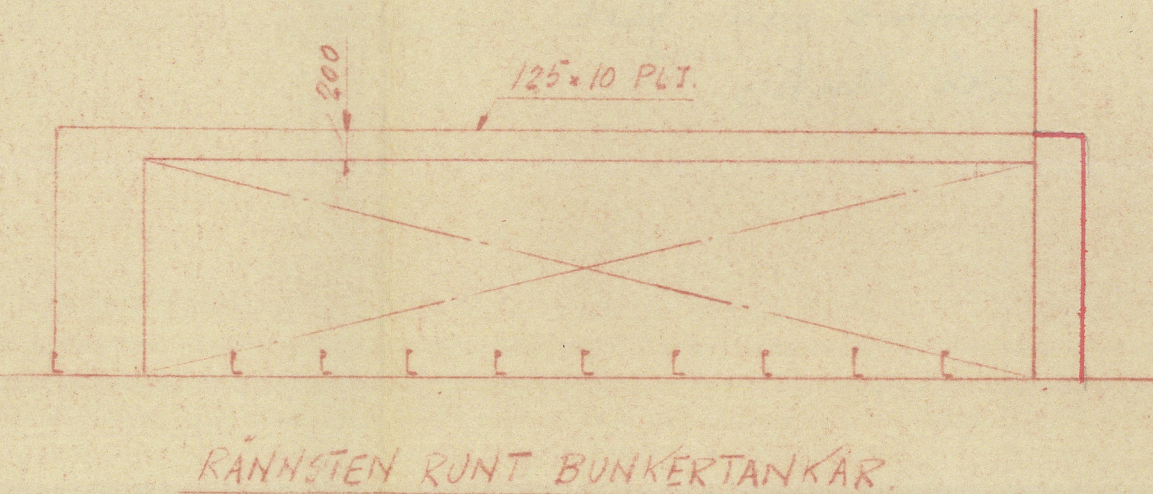

- Note:
- 1) Seams and butts, stiffeners and boundary bulkheads plating to be made O.T.
 - 2) Sparring to be fitted on bhd 53 in hold.

KOLLUCKA AVRÄPAS OMEDELBART UNDER HALVRUNDJÄRN.

Deck plating in way of tank not to be less than 7.5 mm

Alternate intermediate rivets fitted between existing rivets or equivalent strengthening by welding.

The flash point of the oil fuel to be above 150°F. and the remaining requirements of Section 20 of the Rules 1952 to be complied with so far as they are applicable.

S/S "HELLE" Plan. Ppt 46, 8971.

ÄNDRAD ENL. KLASSEN, FRÅN LLOYD'S N 25-9-52

AB CARLSONS VARV	
S/S HELLE	
BUNKERTANK	
124	1008
Lloyd's Register Foundation	

"Helle"

Rpt. no. Skm. 8971

Conversion of side
bunkers into fuel
oil tanks.



© 2020

Lloyd's Register
Foundation

004971-004981-0096