
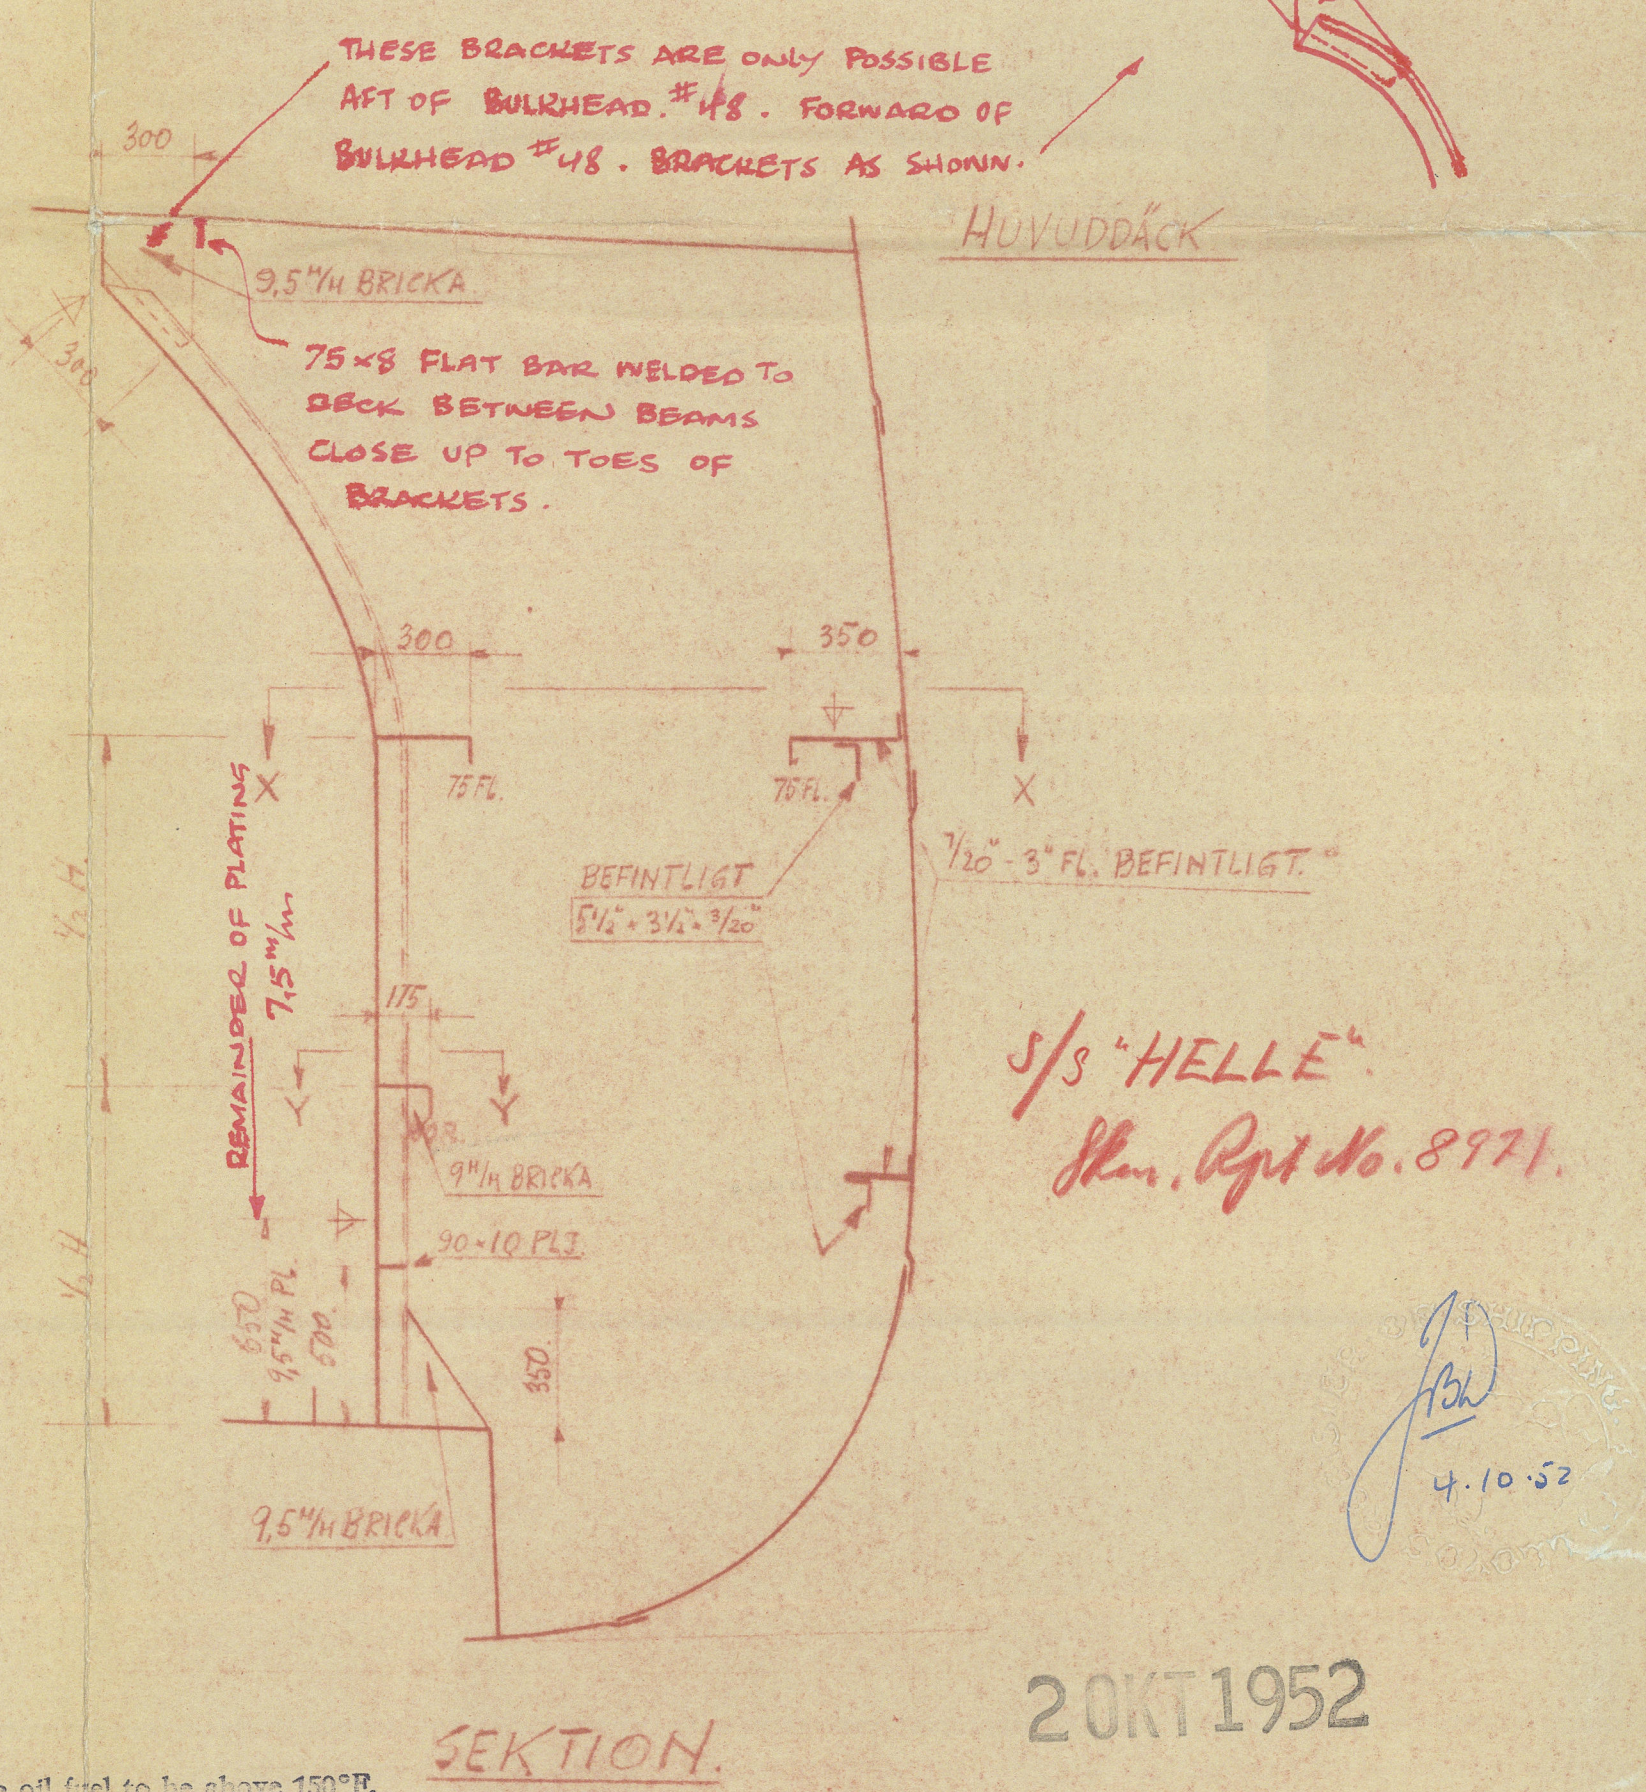
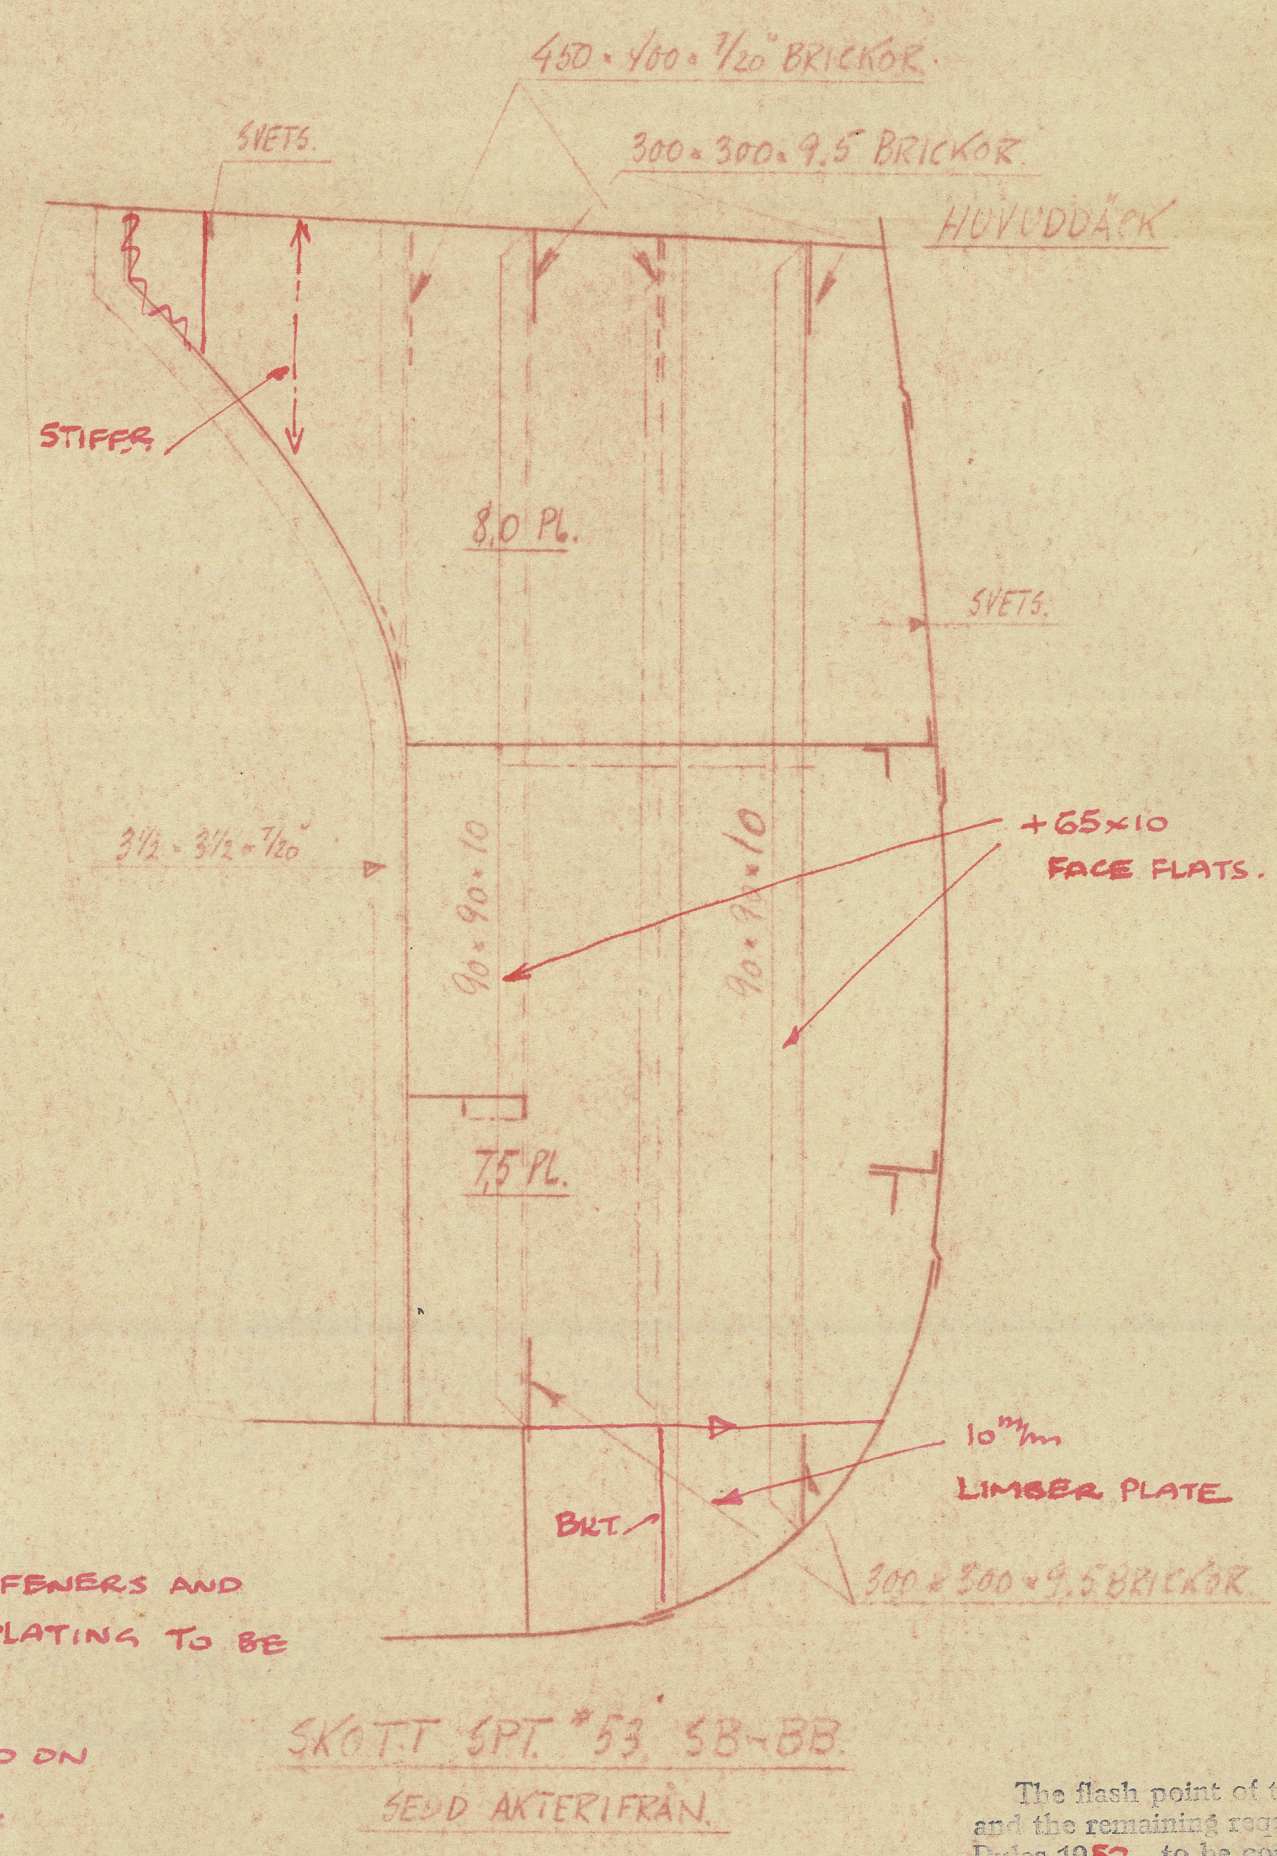


STAG MRK. @ 30, 90, 10 + 65x10 FACE PLATE = F
 UT. MRK. 75, 75, 10.

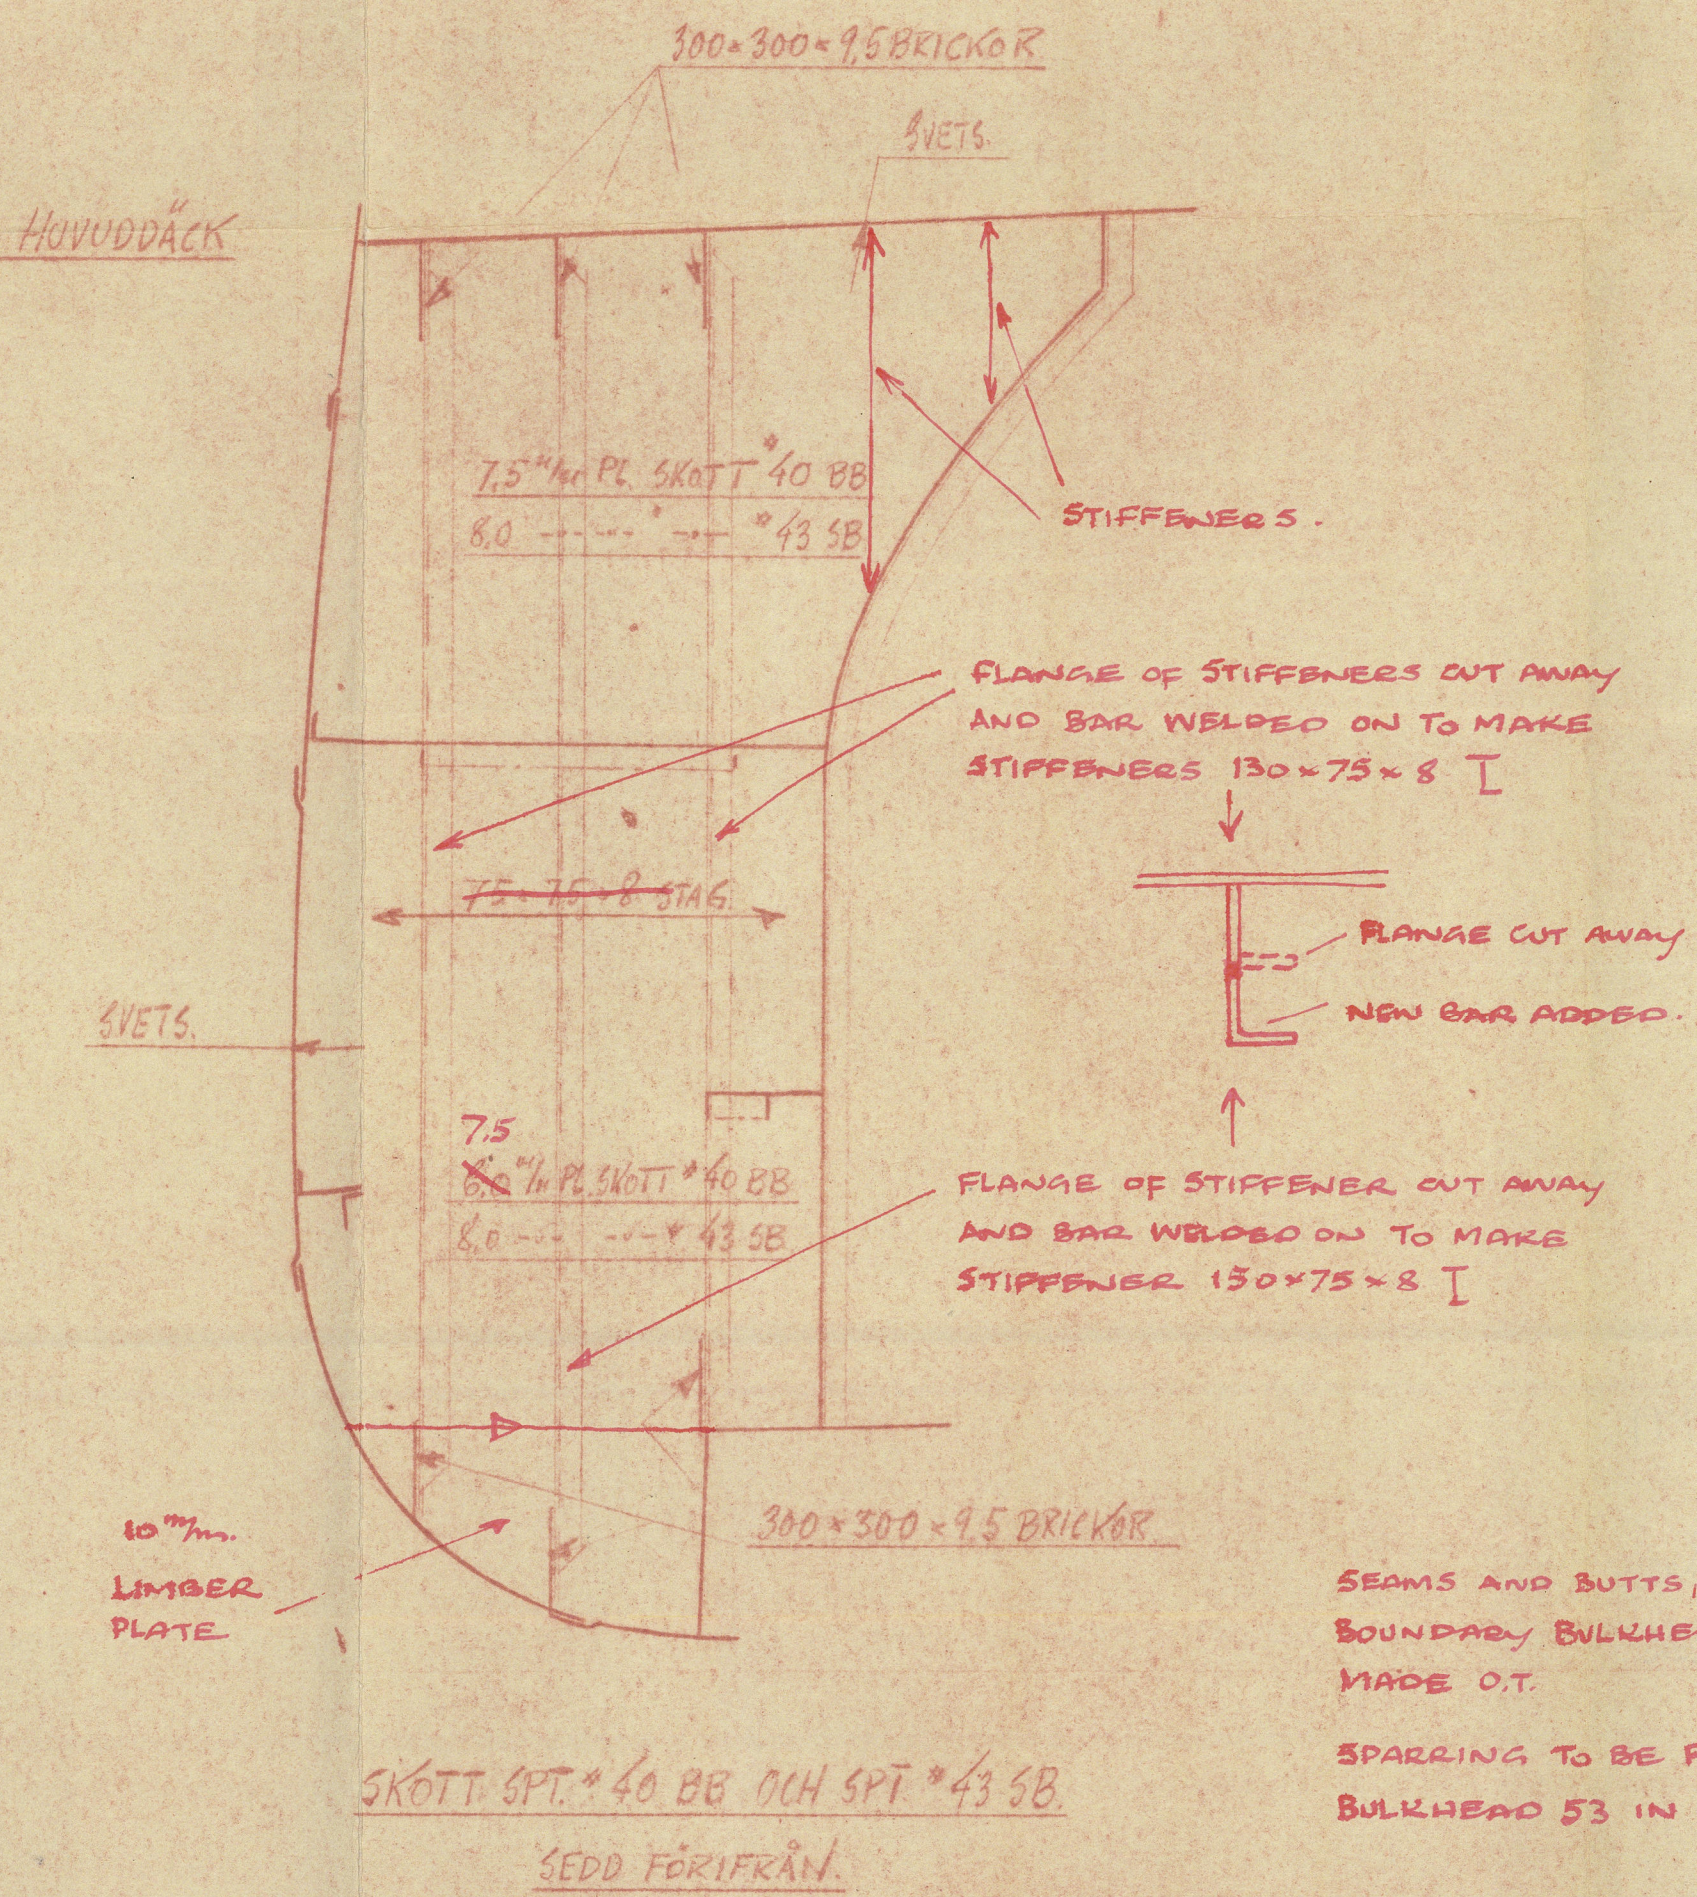

S/S 'HELLE'
 Skn. Rpt No. 8971.

20KT 1952

The flash point of the oil fuel to be above 150°F, and the remaining requirements of Section 20 of the Rules 1952 to be complied with so far as they are applicable.

ABEKENBERGS VARV	
AP	124
S/S HELLE	
BUNKERTANKAR	
2-10-52	

"

Helle"

Rpt. no. Skm. 8971

Conversion of side
bunkers into fuel
oil tanks



© 2020

Lloyd's Register
Foundation

004971-004981-0097