PLAN VIEW AT MAIN DECK.

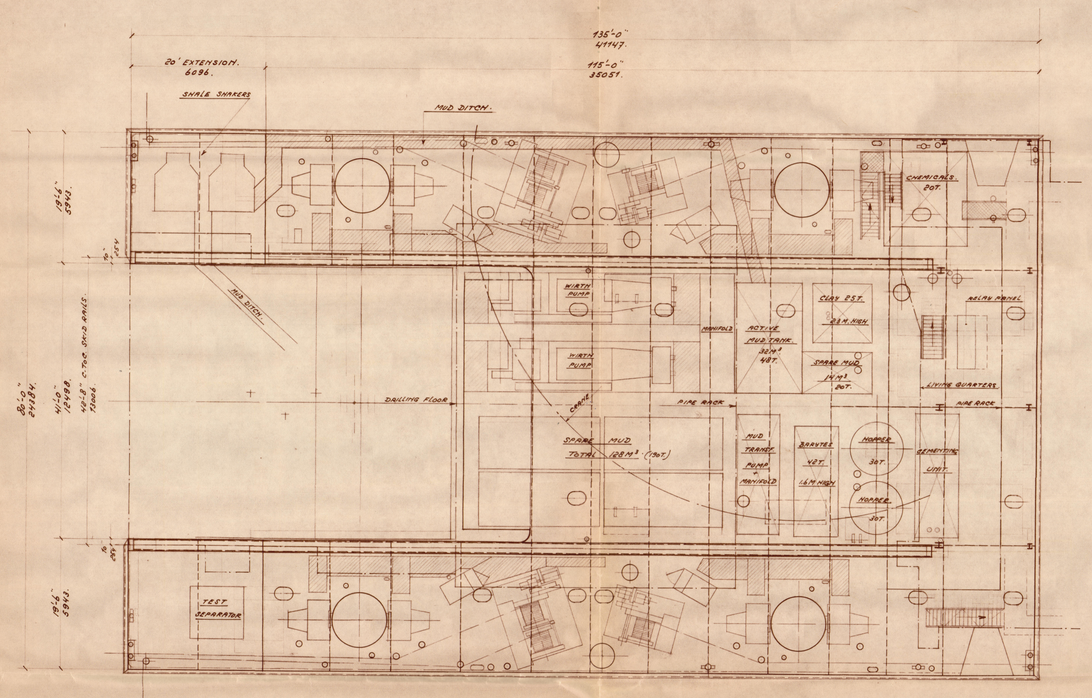

PLAN VIEW UNDER MAIN DECK.

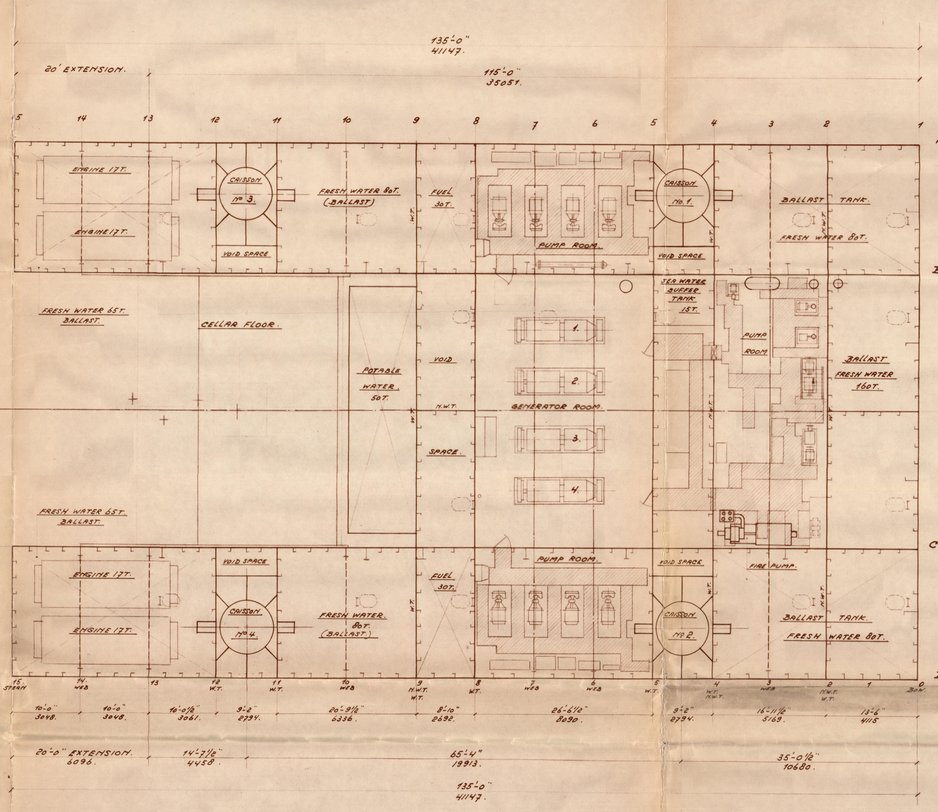

STARBOARD PROFILE.

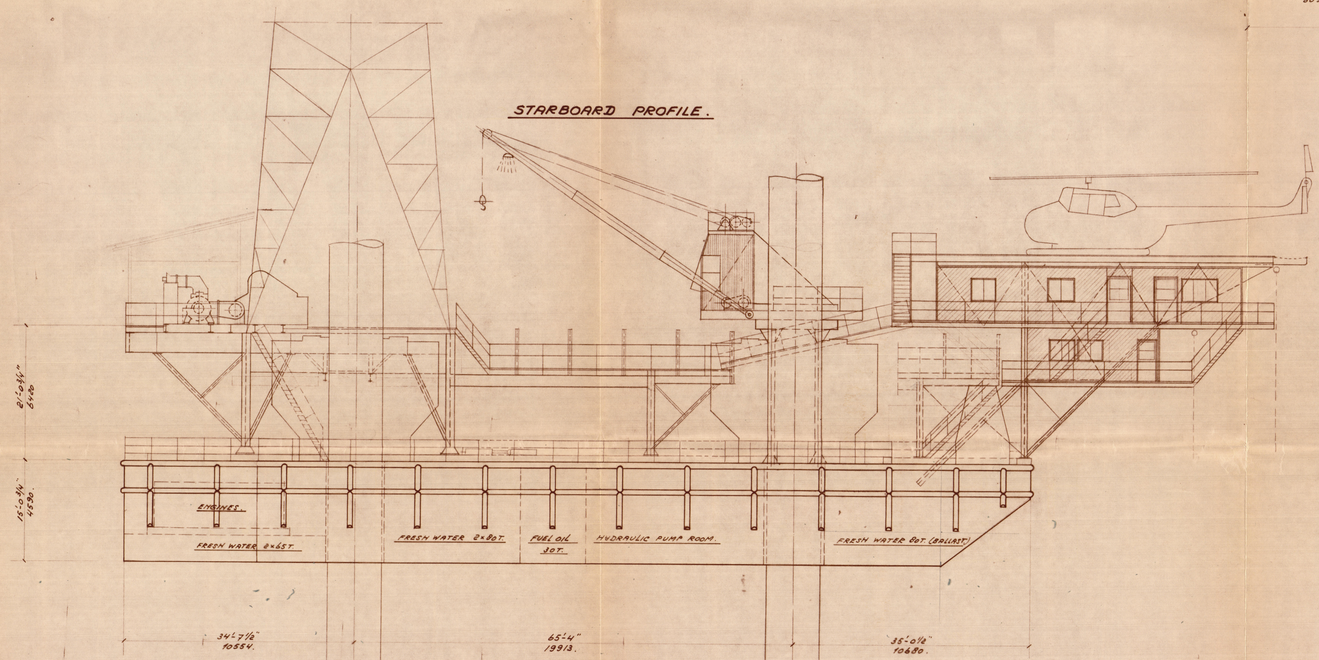

LIVING QUARTERS.

UPPER FLOOR.

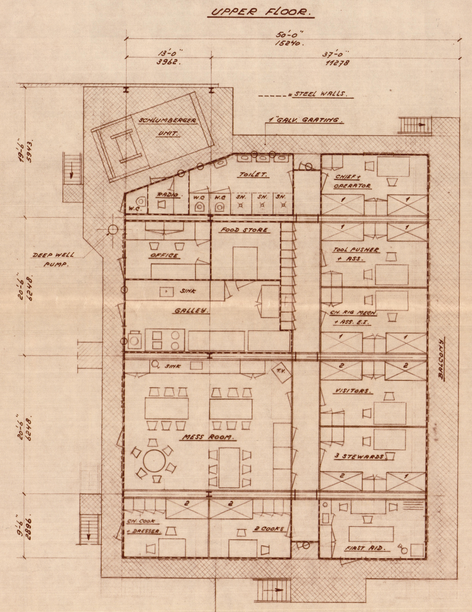

LOWER FLOOR.

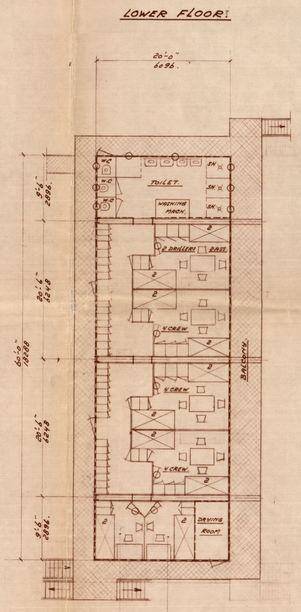

© BIG MECH. CRANE DRIVER WELDER. ELECTRICIAN.

DEVIATION FROM APPROVED PLAN None
LLOYD'S REGISTER HOLLAND

PLAN AS BUILT

SURVEYOR'S COPY

BELONGS TO ROTTERDAM REPORT NO: 52343

Signed Noted O.M.C. Rondam 17/1/61 19/1/61

RETAIN

REVISION	DATE	BY	DESCRIPTION OF REVISION
B	08/9/60	Arndt	HEIGHT OF SUBSTRUCTURE ALTERED.
A	12/9/60	Arndt	STEEL WALL IN LIVING QUARTERS ADDED

DRAWN BY Arndt	CHECKED BY H.J.H.	APPROVED BY O.M.C. 15/12/60	
DATE 12/7/60.	SCALE 1:100.	CODE	

NORTH SEA DRILLING.
CONVERSION OF TRITON INTO SELF CONTAINED MOBIL DRILLING PLATF.

REFINERY	PLANT	HP
BATAAFSE INTERNATIONALE PETROLEUM MAATSCHAPPIJ N.V.		DWG. No. T498234 -
EN/ DIVISION THE HAGUE		

Lloyd's Register of Shipping

004992 - 004987 - 0092

N° 25.119 (3 M 10.58) A.G