

①

"JALAPUSHPA"
YARD N° V.C. 112.


RECORDS DEPT.
LONDON

1

"AS FITTED"

MIDSHIP SECTION.

HINDUSTAN SHIPYARD LD.
VIZAGAPATAM
SOUTH INDIA

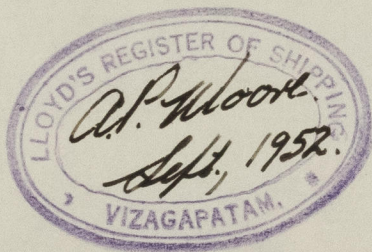

004982-004982-0134

VIZAG. REPORT N° 115



© 2020

Lloyd's Register
Foundation