

# CAST STEEL STERNFRAME

JALA PUSHPA.

SCALE:— 1"=1 FOOT.





DETAILS:— SCALE AS INDICATED.

MATERIAL:— BEST QUALITY STEEL CASTING.

MAKERS:— WILLIAM BRADMORE & CO. LTD. GLASGOW.

DIMENSIONS:— 400-TON S.P. 81-9 MLD. 52-5 EXTREME, 30-6 MLD. TO UPPER DECK.  
TO CLASS 100 A1 AT LLOYD'S SPECIAL SURVEY EQUIPMENT NO. 54728.

187 LONGITUDINAL NUMERAL LXD=12200.

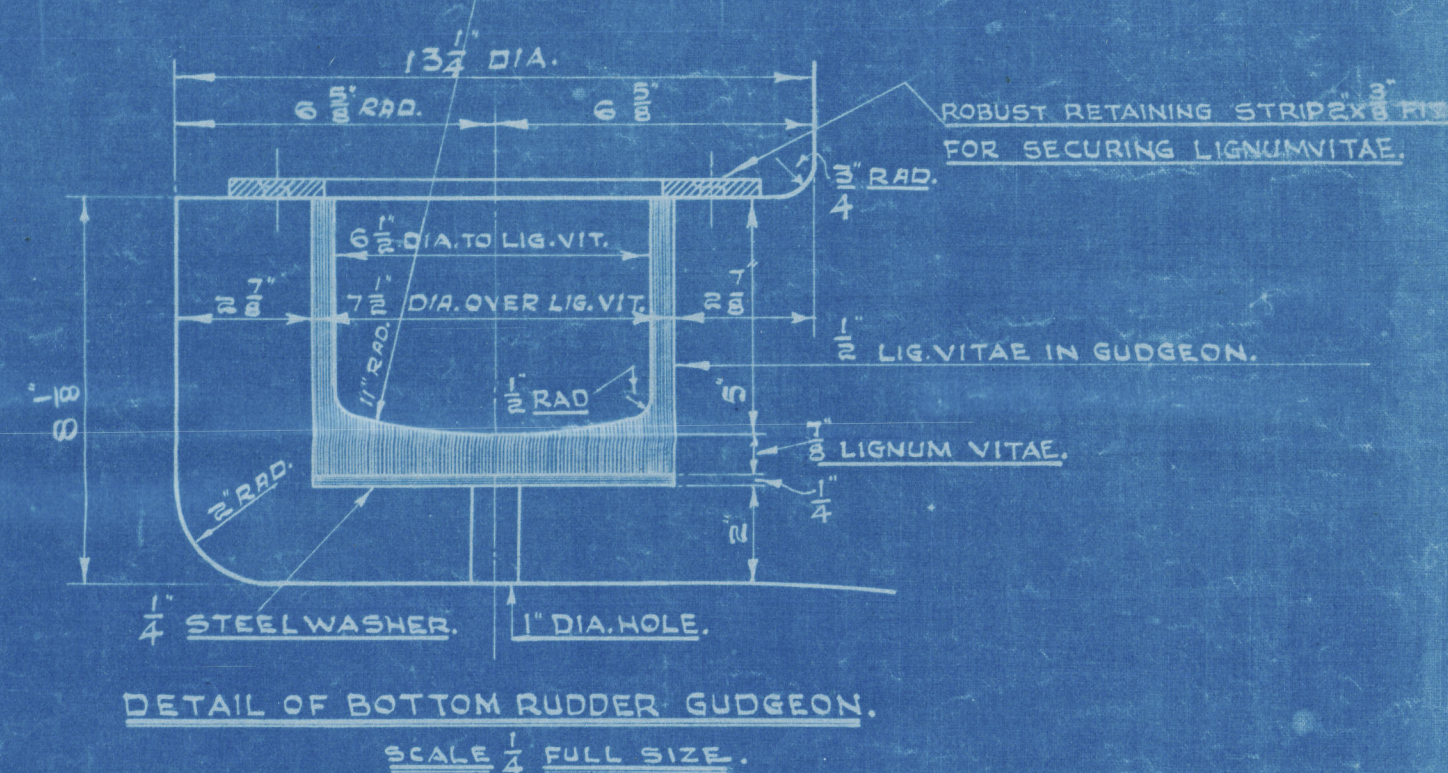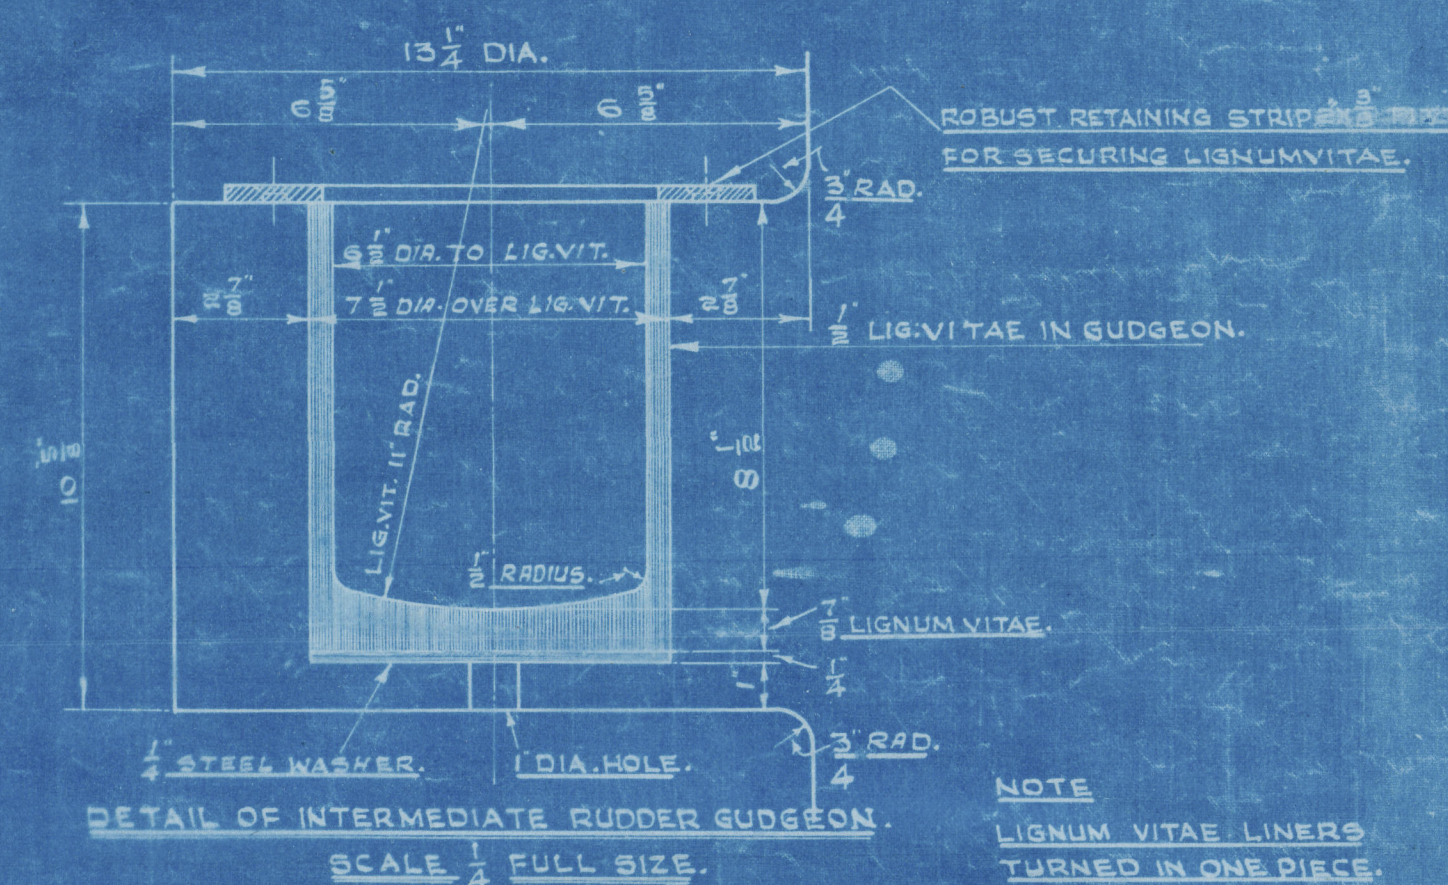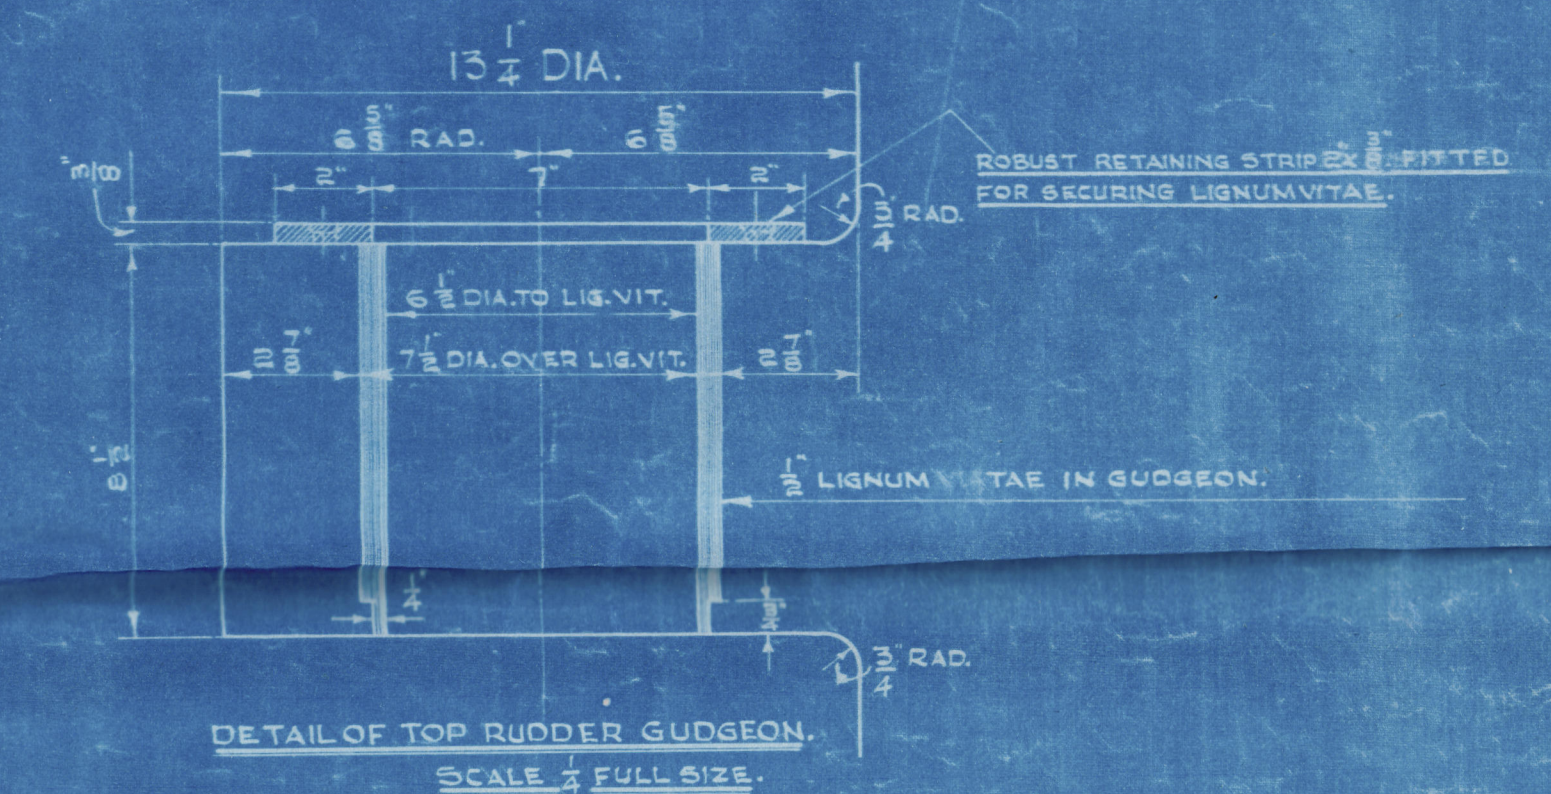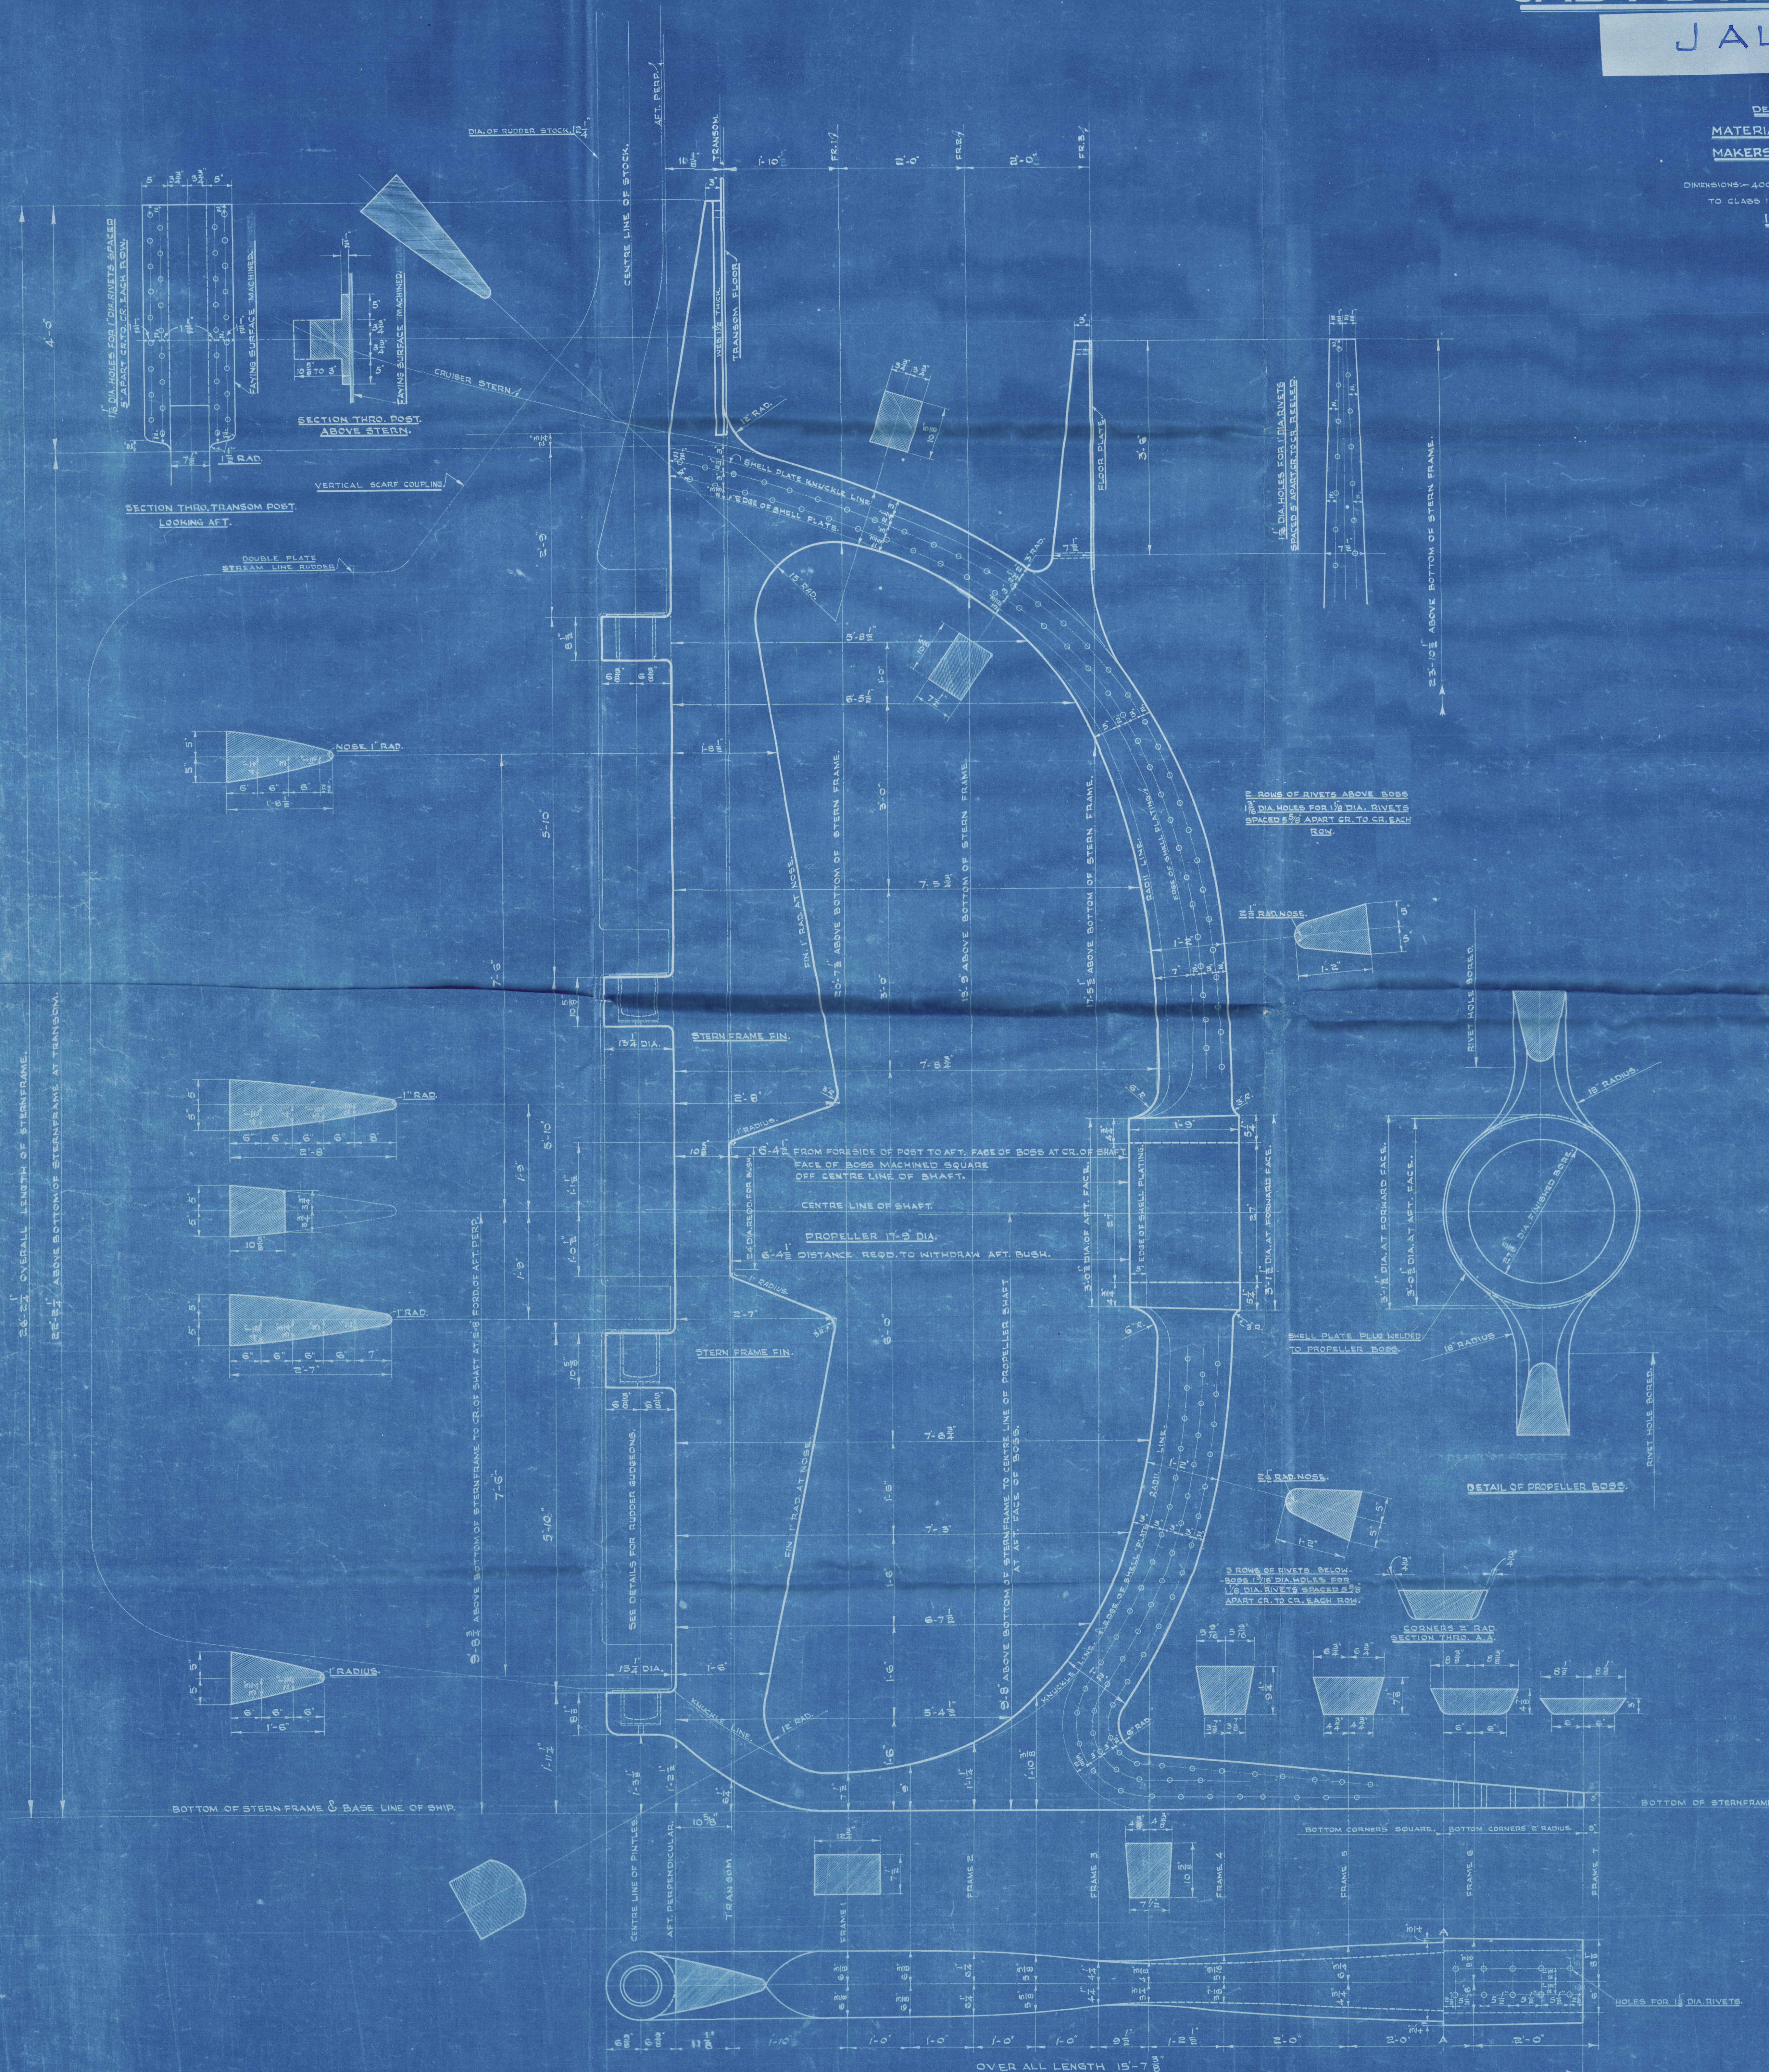



8


"JALAPUSHPA"  
YARD NO V.C. 112.

RECORDS DEPT.  
LONDON

"AS FITTED"


3

CAST STEEL STERNFRAME

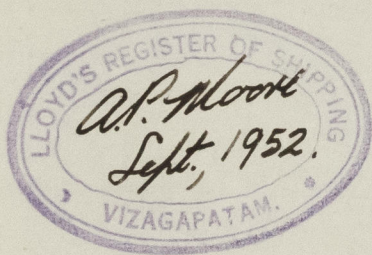

HINDUSTAN SHIPYARD LTD.  
VIZAGAPATAM.  
SOUTH INDIA.

VIZAG. REPORT NO 115

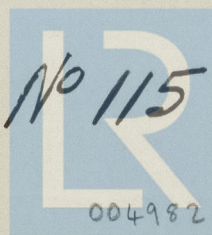

© 2020

Lloyd's Register  
Foundation

004982-004983-0133