


29 NOV 1934

PROPOSED MOTOR TANKER.

90'-0" x 18'-0" x 8'-9" x 7'-9" DRAFT.

TO CLASS B. S. * BULK OIL CARRIER.

Received from London Office.
Scantlings & Arrangements cover requirements
of B.C.

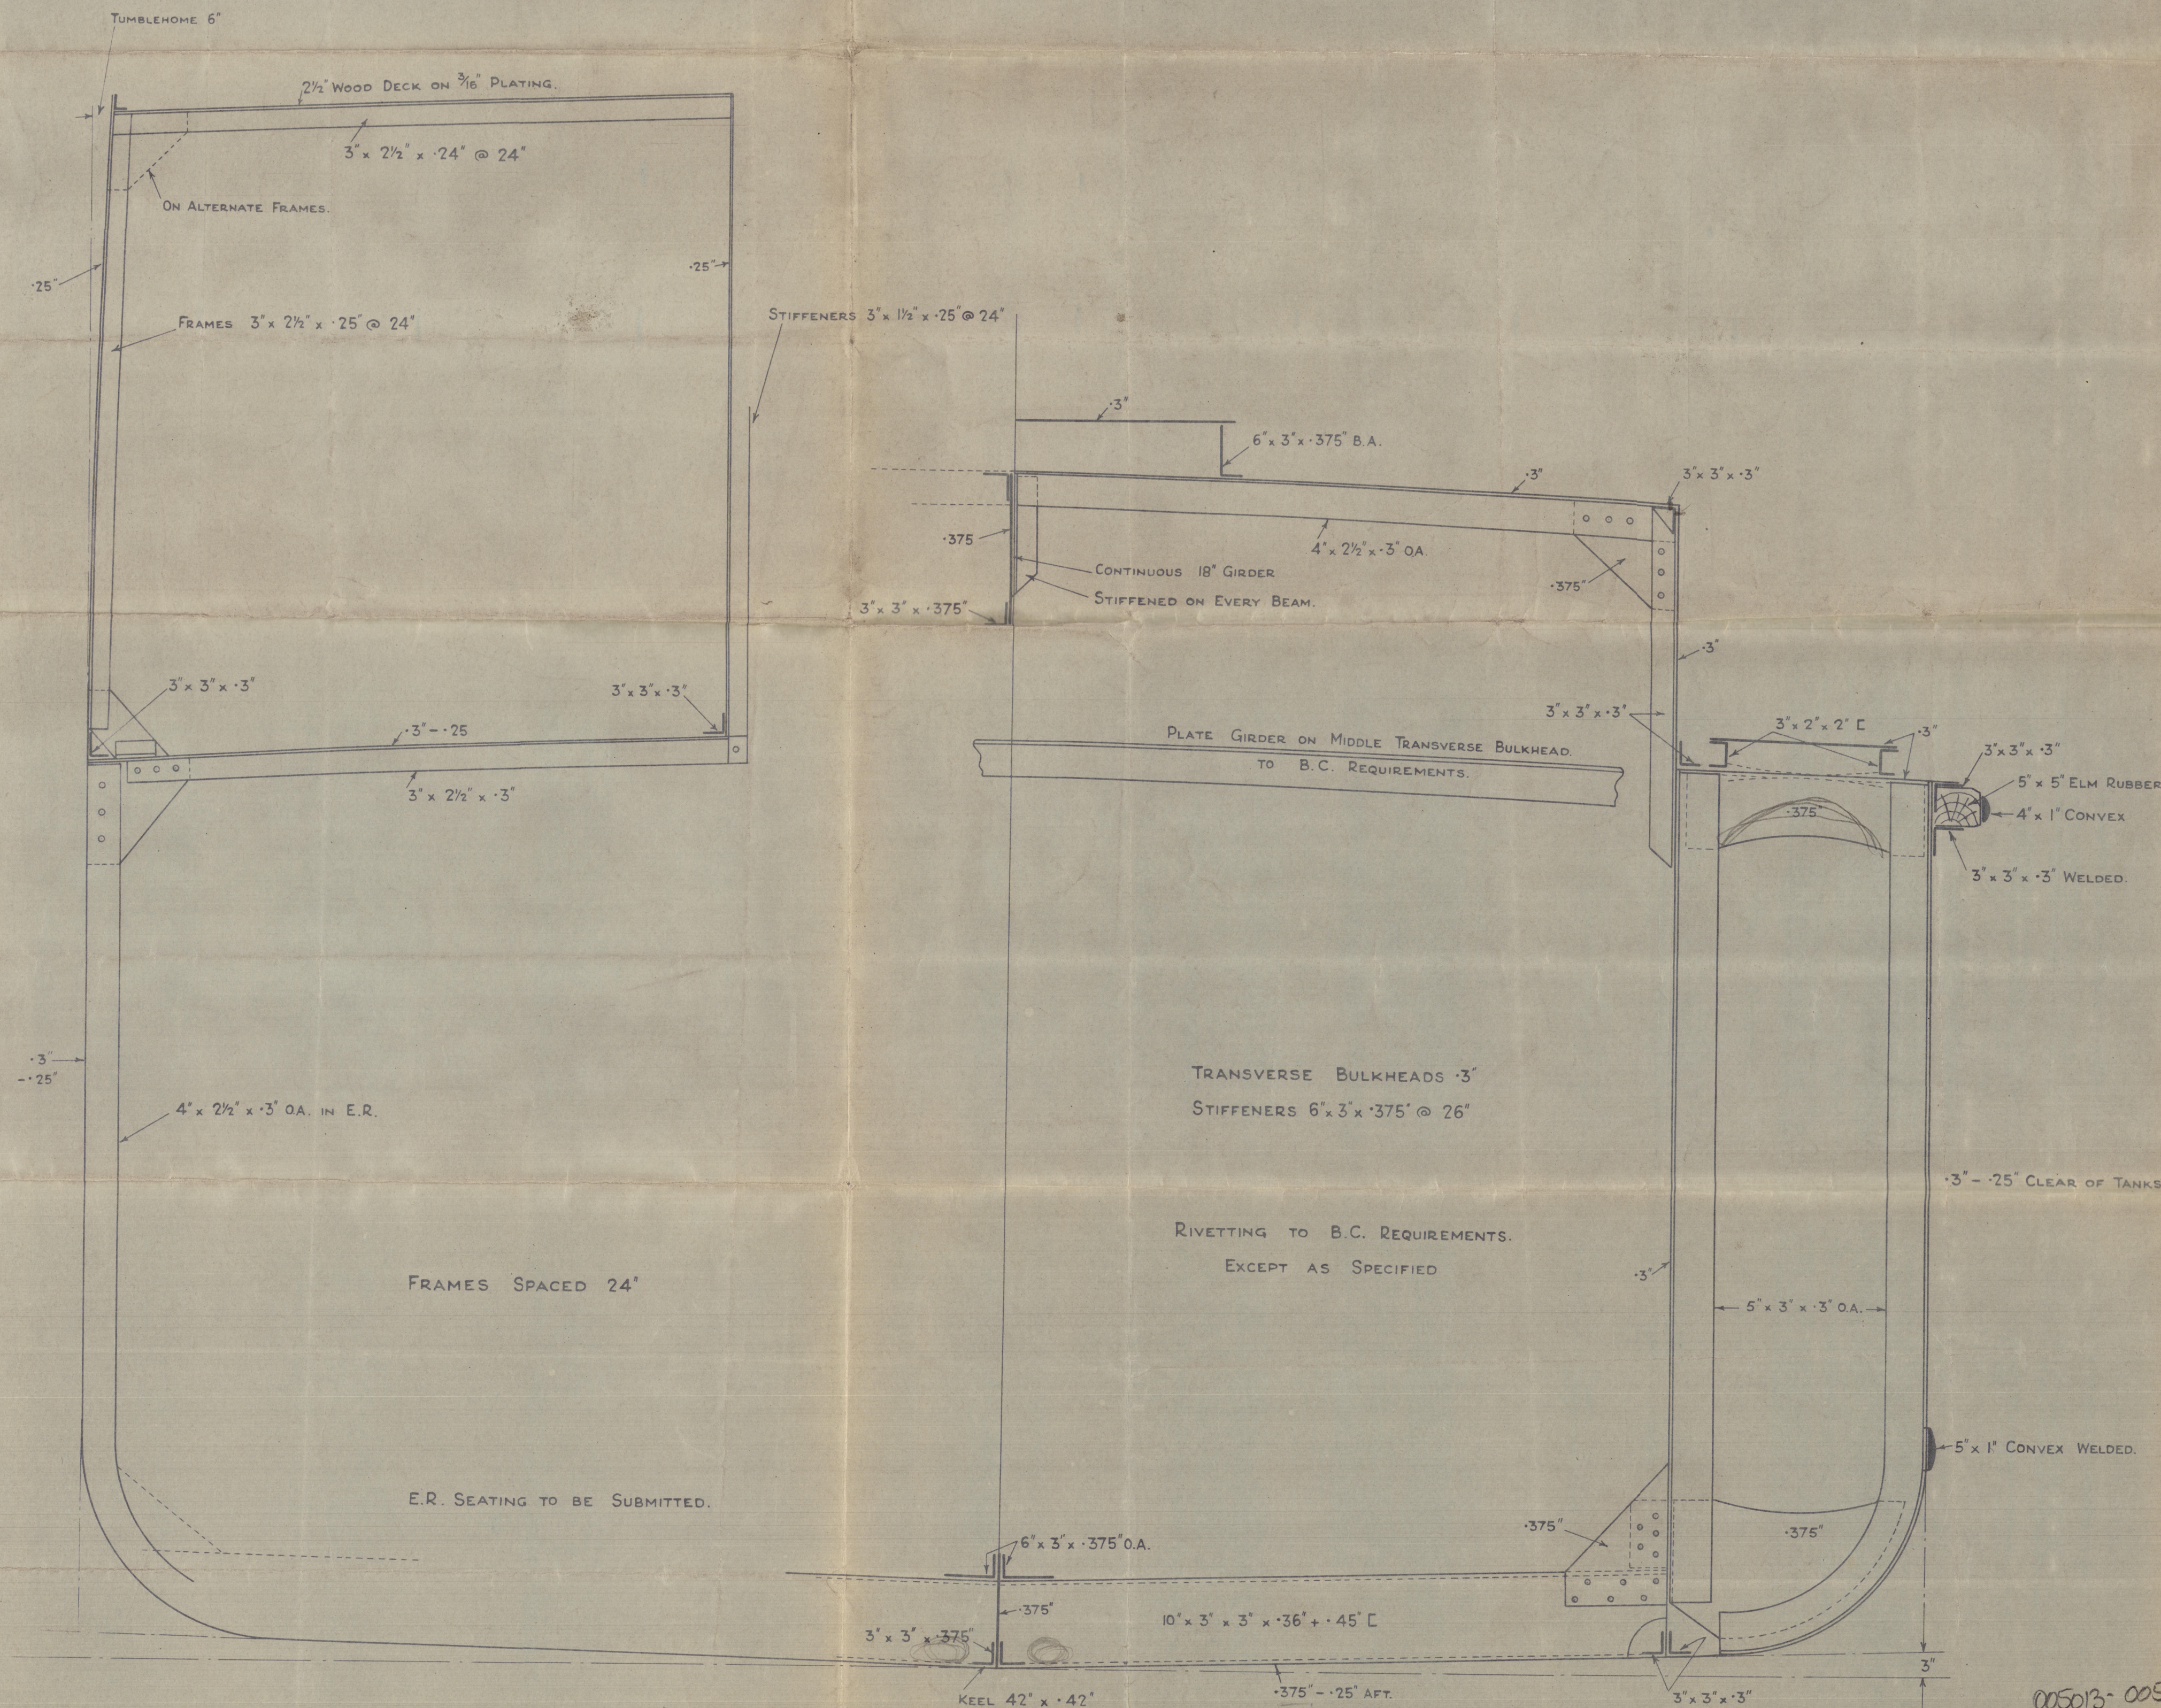

005013-005019-0008

Midship Section.

Prop Tanker for Nat. Benzole Co.

90'0" x 18'0" x 8'9". Howhedge N° 509.

London 29.11.24

BEN OLIVER.

Prop Tanker. 90' x 18' x 8'9"

Midship Section.

005013-005019-0008



© 2021

Lloyd's Register
Foundation