

JOHN I. THORNDYKE & CO. LTD.
(REPAIRS DEPOT)
SOUTHAMPTON DOCK
R.P. Hoffat
14-9-20

"Horal Moller"
ex
— M.S. "KANGAROO." —

ADDITION OF 500 TON OIL TANK AND
INSULATED CARGO SPACE FOR COLD STORAGE.


SCALE: 1/8" = 1 FOOT.

PLANS TRANSFERRED
TO SISTER VESSEL

Scantis

23.9.20.

Plan added during
increased cargo
to be submitted.

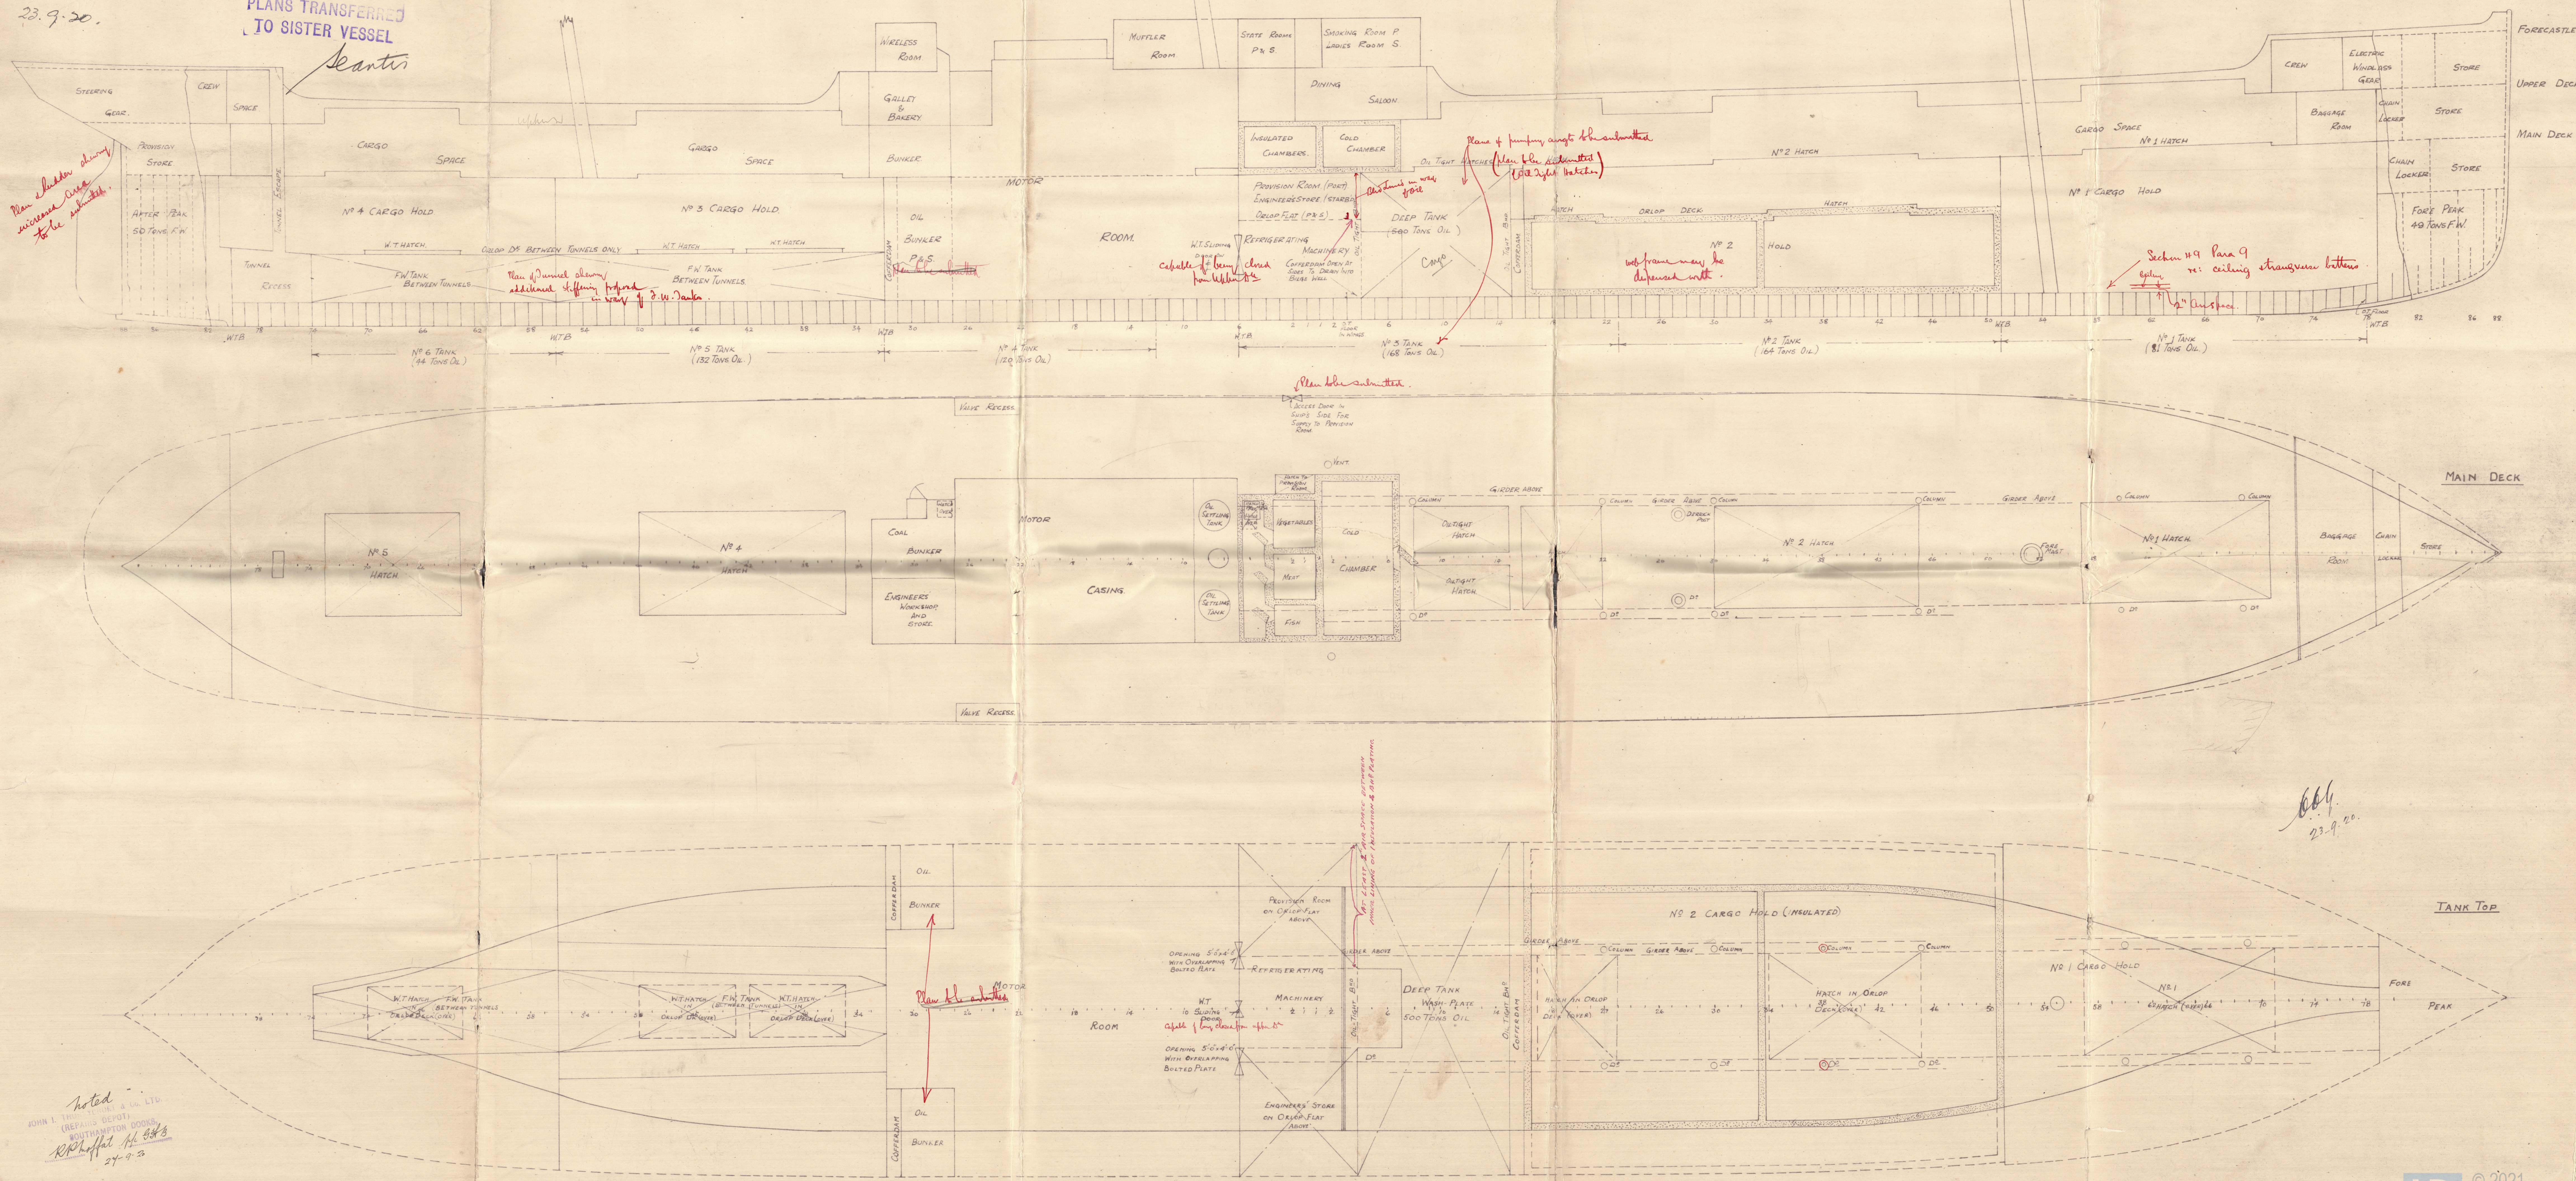

664.
23.9.20.

Noted
JOHN I. THORNDYKE & CO. LTD.
(REPAIRS DEPOT)
SOUTHAMPTON DOCK
R.P. Hoffat
24-9-20

motor ship 'Kangaroo'

Profile - Deck Plans: arrangements.

(memo John D. Thornycroft re. L.S.
Southampton).

005013-005019-0184



© 2021

Lloyd's Register
Foundation