

13/6/34

PROFILE.

SCALE 1" = 100'


LIST OF PLANS SUBMITTED SEPARATELY
STERN FRAMES & KNUCKLES
DEEP TANK STIFFENING
FORE & AFT PEAK BULKHEADS
BOTTOM STIFFENING DECKHEAD & PAINTING ARE
GIRDS & HOLD PILLARS

NO HATCH FLOOR & AFTER FITTED WOOD COCKETS FITTED FORE & AFT DECK PLATING DOUBLED.
AT CORNERS OF HATCHWAYS AND LARGE OPENINGS THEN DECK SHEAR STIFFENERS TO TAKE A
NET TONG BOUNDARY BARS & BOTTOM (BRACKETS IN WAY OF GIRDERS ONLY AS SHOWN).
LENGTH 315' 6" BREADTH MLD 58' 4" DEPTH MLD 31' 9"

UNDER DECK TONNAGE = 7000 TONS APPROXIMATELY

Plan showing compensation
in way of doors to be
submitted.

Handlings marked X have been
amended to dispense with handle
home.

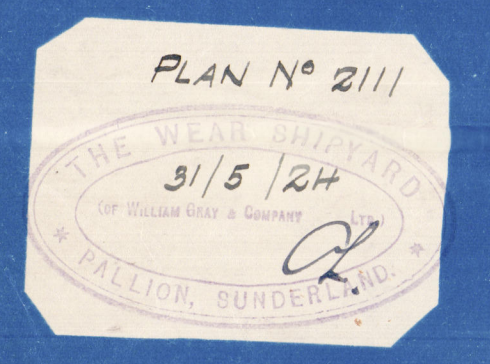

005020-005028-0084

(2)

Profile

Nº 969

Mess Wear Shipyard Co.

Sunderland

S. S. "CITY OF DELHI"

SUNDERLAND. RPT. NO. 29068.

RECEIVED
JAN 1968

© 2020

Lloyd's Register
Foundation