

COMPLETE SHELTER DECKIndex No. 24088
(For London Office only.)Lloyd's Register of Shipping.
SURVEYS FOR FREEBOARD.—STEAM SHIPS.

No 42979

PARTICULARS RELATING TO ALL STEAM SHIPS EITHER FLUSH DECKED, OR WITH TOP GALLANT FORECASTLES, SHORT POOPS AND BRIDGE HOUSES DISCONNECTED, OR WITH TOP GALLANT FORECASTLES HAVING LONG POOPS, OR RAISED QUARTER DECKS CONNECTED WITH BRIDGE HOUSES, OR OTHERWISE.

Port of Survey GLASGOW
Date of Survey RECLASSIFICATION.
Name of Surveyor D. M. C. Smith

Ship's Name	Port of Registry and Nationality.	Official Number.	Gross Tonnage.	Date of Build.	Particulars of Classification.
"MEMPHIS" ex "MERDIS"	GLASGOW BRITISH.	137839		1917-3	+100 AI SHELTER DK

Number in Register Book 33549

Registered dimensions from Ship's Register.	LENGTH.	BREADTH.	DEPTH.	UNDER DECK TONNAGE.
	200.4	30.7	19.1 (SD) 12.1 (UD)	952 To 5D 394 To UD
Length on LOADLINE.	199.75	Frame Depth 5½ Rule " 3½	Ceiling FITTED Sheer + .66	Peak } INCLD Tanks } DROOP 4" TANKS Depth to Tank. 12.33
CORRECTED DIMENSIONS.	199.75	30.37	13.15	594

Co-efficient of fineness.....

.75

Any modification necessary
[Para. 4 (a) to (e)]*

C.D.B.-02

Co-efficient as corrected

.75 - 73.

Sheer { Stem 72 { 108 ÷ 2 = 54" Mean
at Sternpost ... 36Sheer at $\frac{1}{2}$ of the length from { Stem 39.5 { 39.5 ÷ 2 = 29.75 Mean
Sternpost 20.0 } ÷ 5.5 = 54

Gradual mean Sheer

54

Standard mean Sheer [Table, Para. 18]

3029.97 Correction

Difference 24.03 ÷ 4 = -6° -

§ If limited as Para. 18 (f)

Rise in Sheer { At front of bridge house.....
from amidships { At after end of forecastleFall in Sheer { Para. 18 (d) { ÷ 2 =
Length uncovered

Correction

ALLOWANCE FOR DECK ERECTIONS :-

Freeboard, Table C.....

Correction for Length, if required (Para. 12, 13, and 14)

Freeboard by Table A. corrected for sheer, and for length, if required (Para. 12, 13, and 14)

Difference

Percentage as below

Corrections for R. Q. Dk. if engine and boiler openings not covered by bridge house (Para. 11)

Allowance for Deck Erections

Length. Length allowed. Height.

Forecastle 123.75 98.85

Bridge House Two COMPLETE STEEL DECKS

+ Raised opening 4.

Poop 72 36.00

Total 199.75 184.85

Length of Ship 199.75 184.85

Corresponding percentage (Para. 11, 12, 13, or 14) 77.6%.

164.15 - .838

199.75

STEEL SHELTER

SHELTER. Do all the Frames extend to the top height in the Poop? YES Raised Quarter Deck? ✓ Bridge House? ✓ Forecastle? ✓

To what height do the Reverse Frames extend? ✓

Has the Poop or Raised Quarter Deck an efficient Iron Bulkhead at the fore end? ✓

Give particulars of the means for closing the openings in Bulkhead ✓

Is the Poop or Raised Quarter Deck connected with the Bridge House? ✓ Has the Bridge House an efficient Bulkhead at the fore end? ✓

Give particulars of the means for closing the openings in Bulkhead ✓

What is the thickness of the Bridge Front plating? ✓ and Coaming plate? ✓

Give scantlings and spacing of the Stiffeners ✓

Are bracket plates fitted at each end of the Stiffeners? ✓ Are hor'l. brackets fitted connecting Bridge Bulk'd. with Bulwarks? ✓

Has the Bridge House an efficient Iron Bulkhead at the after end? ✓

How are the openings closed? ✓

Is the Forecastle at least as high as the main or top-gallant rail? ✓ Has the Forecastle an efficient Iron or Wood Bulk'd. at after end? ✓

Are the Engine and Boiler openings covered by a ~~Bridge, Poop, Raised Quarter Deck,~~ or enclosed by a Strong Iron or Steel Deckhouse? ✓

SHELTER DECK & STEEL DECKHOUSE.

If the openings are not so protected are the exposed parts of the Casings efficiently constructed? ✓

Give thickness of plating; scantlings and spacing of Stiffeners ✓

What is the height of the exposed Casings? 7'-0" Are suitable means provided for closing all openings in them in bad weather? YES.

Are the Weather Deck Hatchways efficiently constructed and at least equal to the requirements of Section 28 of the Rules for 1904-5? Give particulars below:— YES.

Position and Size.	N°1 = $\frac{S=29\cdot4}{D=34\cdot10} \times 15\cdot0$ "	N°2 = 31·2" x 15·0"	N°3 = 4·0" x 15·0"	Ship.	Rule.	Ship.	Rule.	Ship.	Rule.	Ship.	Rule.
COAMING.	Item.	Ship.	Rule.	Ship.	Rule.	Ship.	Rule.	Ship.	Rule.	Ship.	Rule.
Height above top of DECK	30"		30"	30"		30"					
Thickness { Sides... Ends... }	3A. 54 40		3A. 52 40	3A. 44 40		3A. 44 40					
SHRIFTING BEAMS OR WEB PLATES.	Number Section and Scantlings Material	5-	5	—							
		19·34 → 3x3x4 ALL. WEBS. S.D.									
* FORE AND AFTERS.	Number Section and Scantlings Material	✓	✓	✓							
HATCHES	Thickness	3"	3"	3"							
Remarks.....											

* The depth of Fore and Afters should be stated from the underside of the hatches in all cases.

(If the sill of the lowest side scuttle will be less than 6 inches above the Indian Summer Load Line if assigned under the tables, state vertical distance from top of deck at side amidships to lower edge of lowest side scuttle.)

The following information is to be given in all Cases of vessels dealt with under Paras. 11, 12 (under 15 feet Moulded depth) and under Shelter Deck Rules.

What is the thickness of the Bridge Sheerstrake? ✓ Strake between Main and Bridge Sheerstrakes? ✓

Delete the words { The Crew are not, berthed in the bridge house.
that do not apply { The arrangements to enable them to get backwards and forwards from their quarters are, are not satisfactory.

Length of Bulwarks in well

Area of Freeing Ports required by Para. 11 (e) each side of vessel =

Ft. Tenth. Ft. Tenth. No.

x

x

x

x

{ Freeing Ports (each side of vessel) =

Sq. ft.


Sq. ft.

NEW DECKHOUSE 7'6" IN HEIGHT
+ 7'6" x 4'0" PLATING 3"

Total deficiency or excess =
no tonnage opening thru. sides

Sq. ft.

SIDE LIGHTS
BELOW SHELL

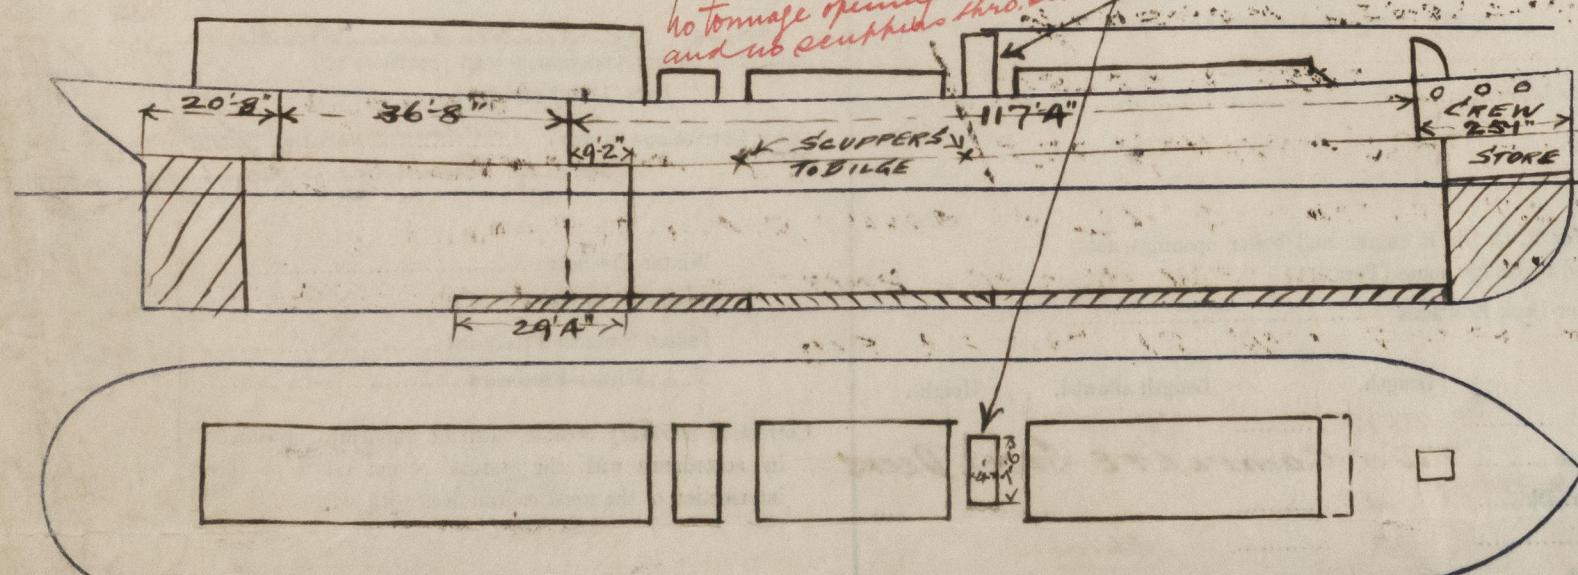

Show hereon line of Floors or Tank Top with position of any Breaks in same; also height of Peak Tank tops, &c., &c.

PLANS IN LONDON

State any special features in the construction of the Vessel

THIS VESSEL IS NOW EXACTLY AS SHE

WAS STRUCTURALLY PRIOR TO BEING SUNK IN MERSEY 12·22. WITH THE ADDITION OF A SMALL DECKHOUSE FITTED ON TOP OF SHELTER DECK AMIDSHIPS

Owners J & P. HUTCHISON LTD

SEE GLASGOW REPORT NO 30803.
AS ABOVE.

" Address GLASGOW

SISTER VESSEL TO "PHILOPS"

Fee £ 5.0.0 Received by me

GLASGOW REPORT NO 37309

to charge

Lloyd's Register Foundation