


PROPOSED

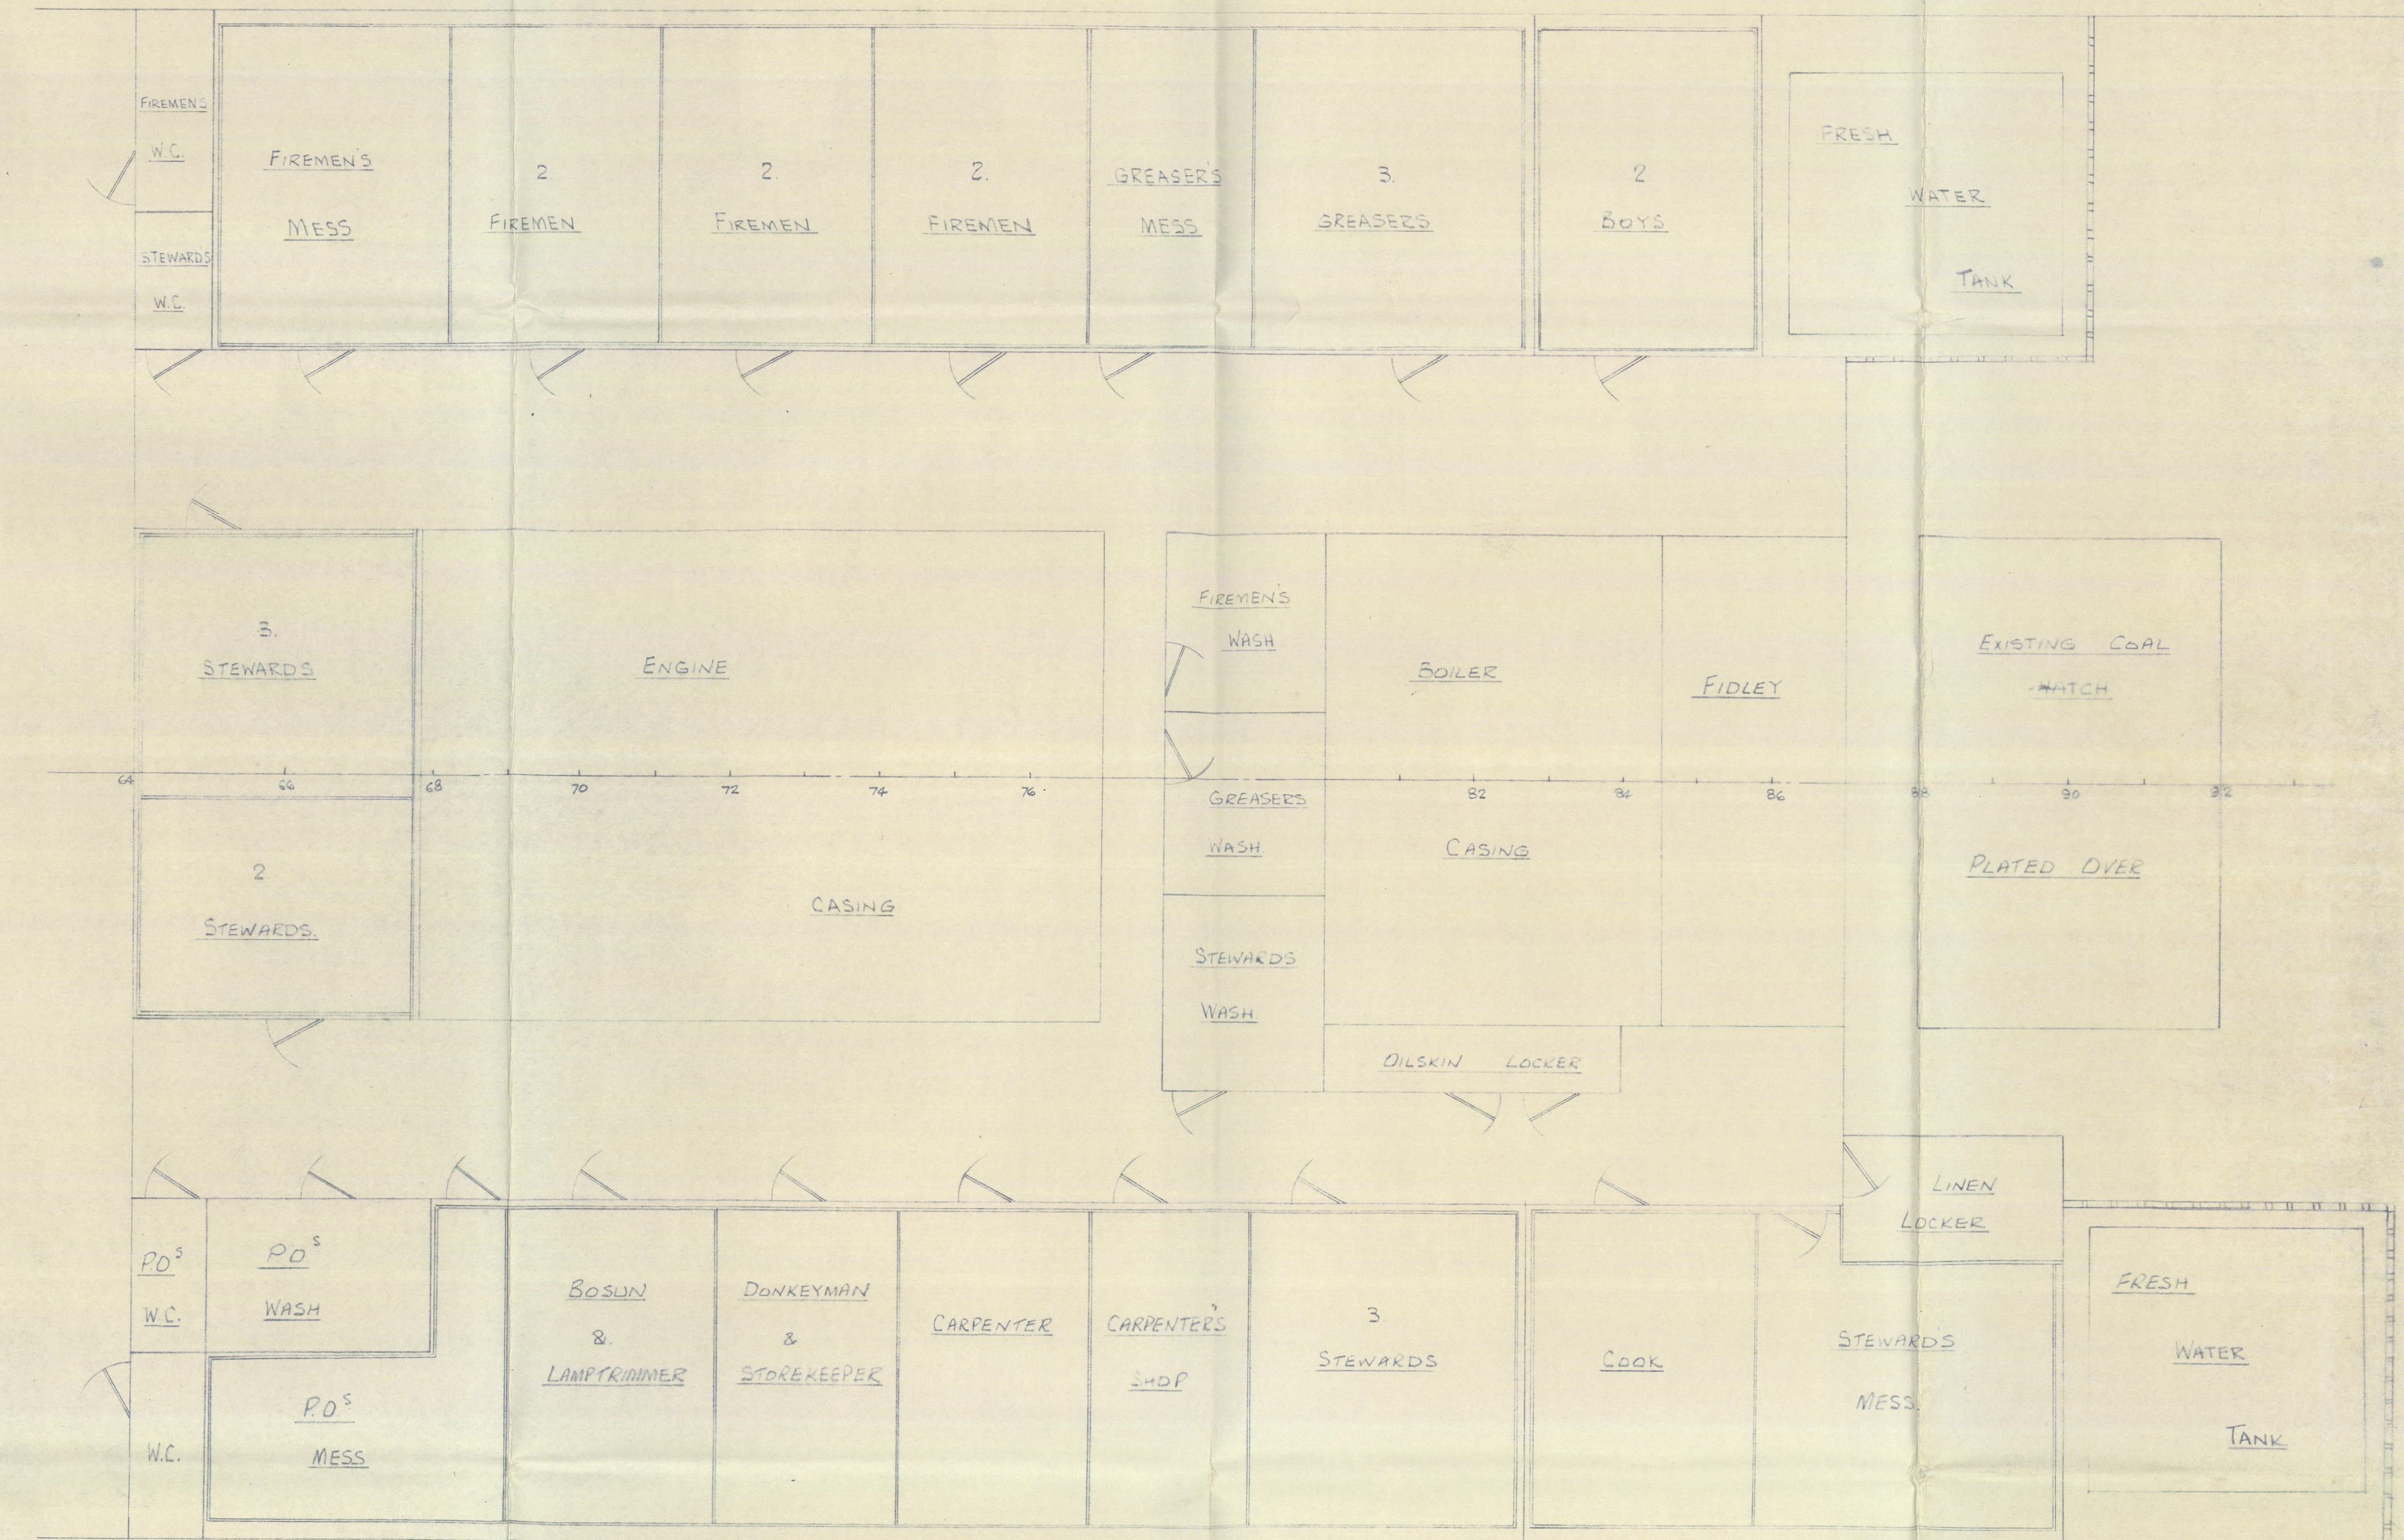

EXISTING

REVISIONS: 1. 10/1/60

2. 10/1/60

3. 10/1/60

THE MANCHESTER DRY DOCKS CO. LTD.

"MANCHESTER PROGRESS"

ALTERATION TO

MIDSHIP ACCOMMODATION

SCALE 1/4" = 1'-0"

DATE OCT. 1960

DWG. NO. 165

