

CAST STEEL STERN FRAME.

SCALE $\frac{1}{2}$ " = ONE FOOT.

TO PASS LLOYDS TESTS

HOLES IN STERN FRAME $\frac{1}{16}$ " DIA. SPACED $5\frac{5}{8}$ " APART

CENTRES, EXCEPT WHERE OTHERWISE STATED.


FIRST LONGITUDINAL NO. 14700.

RUDDER HEAD $10\frac{7}{8}$ " DIA.

(= 97% + 10%)

SKETCH OF TOP SCARPH & GUDGEON

SCALE $\frac{1}{2}$ " = ONE FOOT.

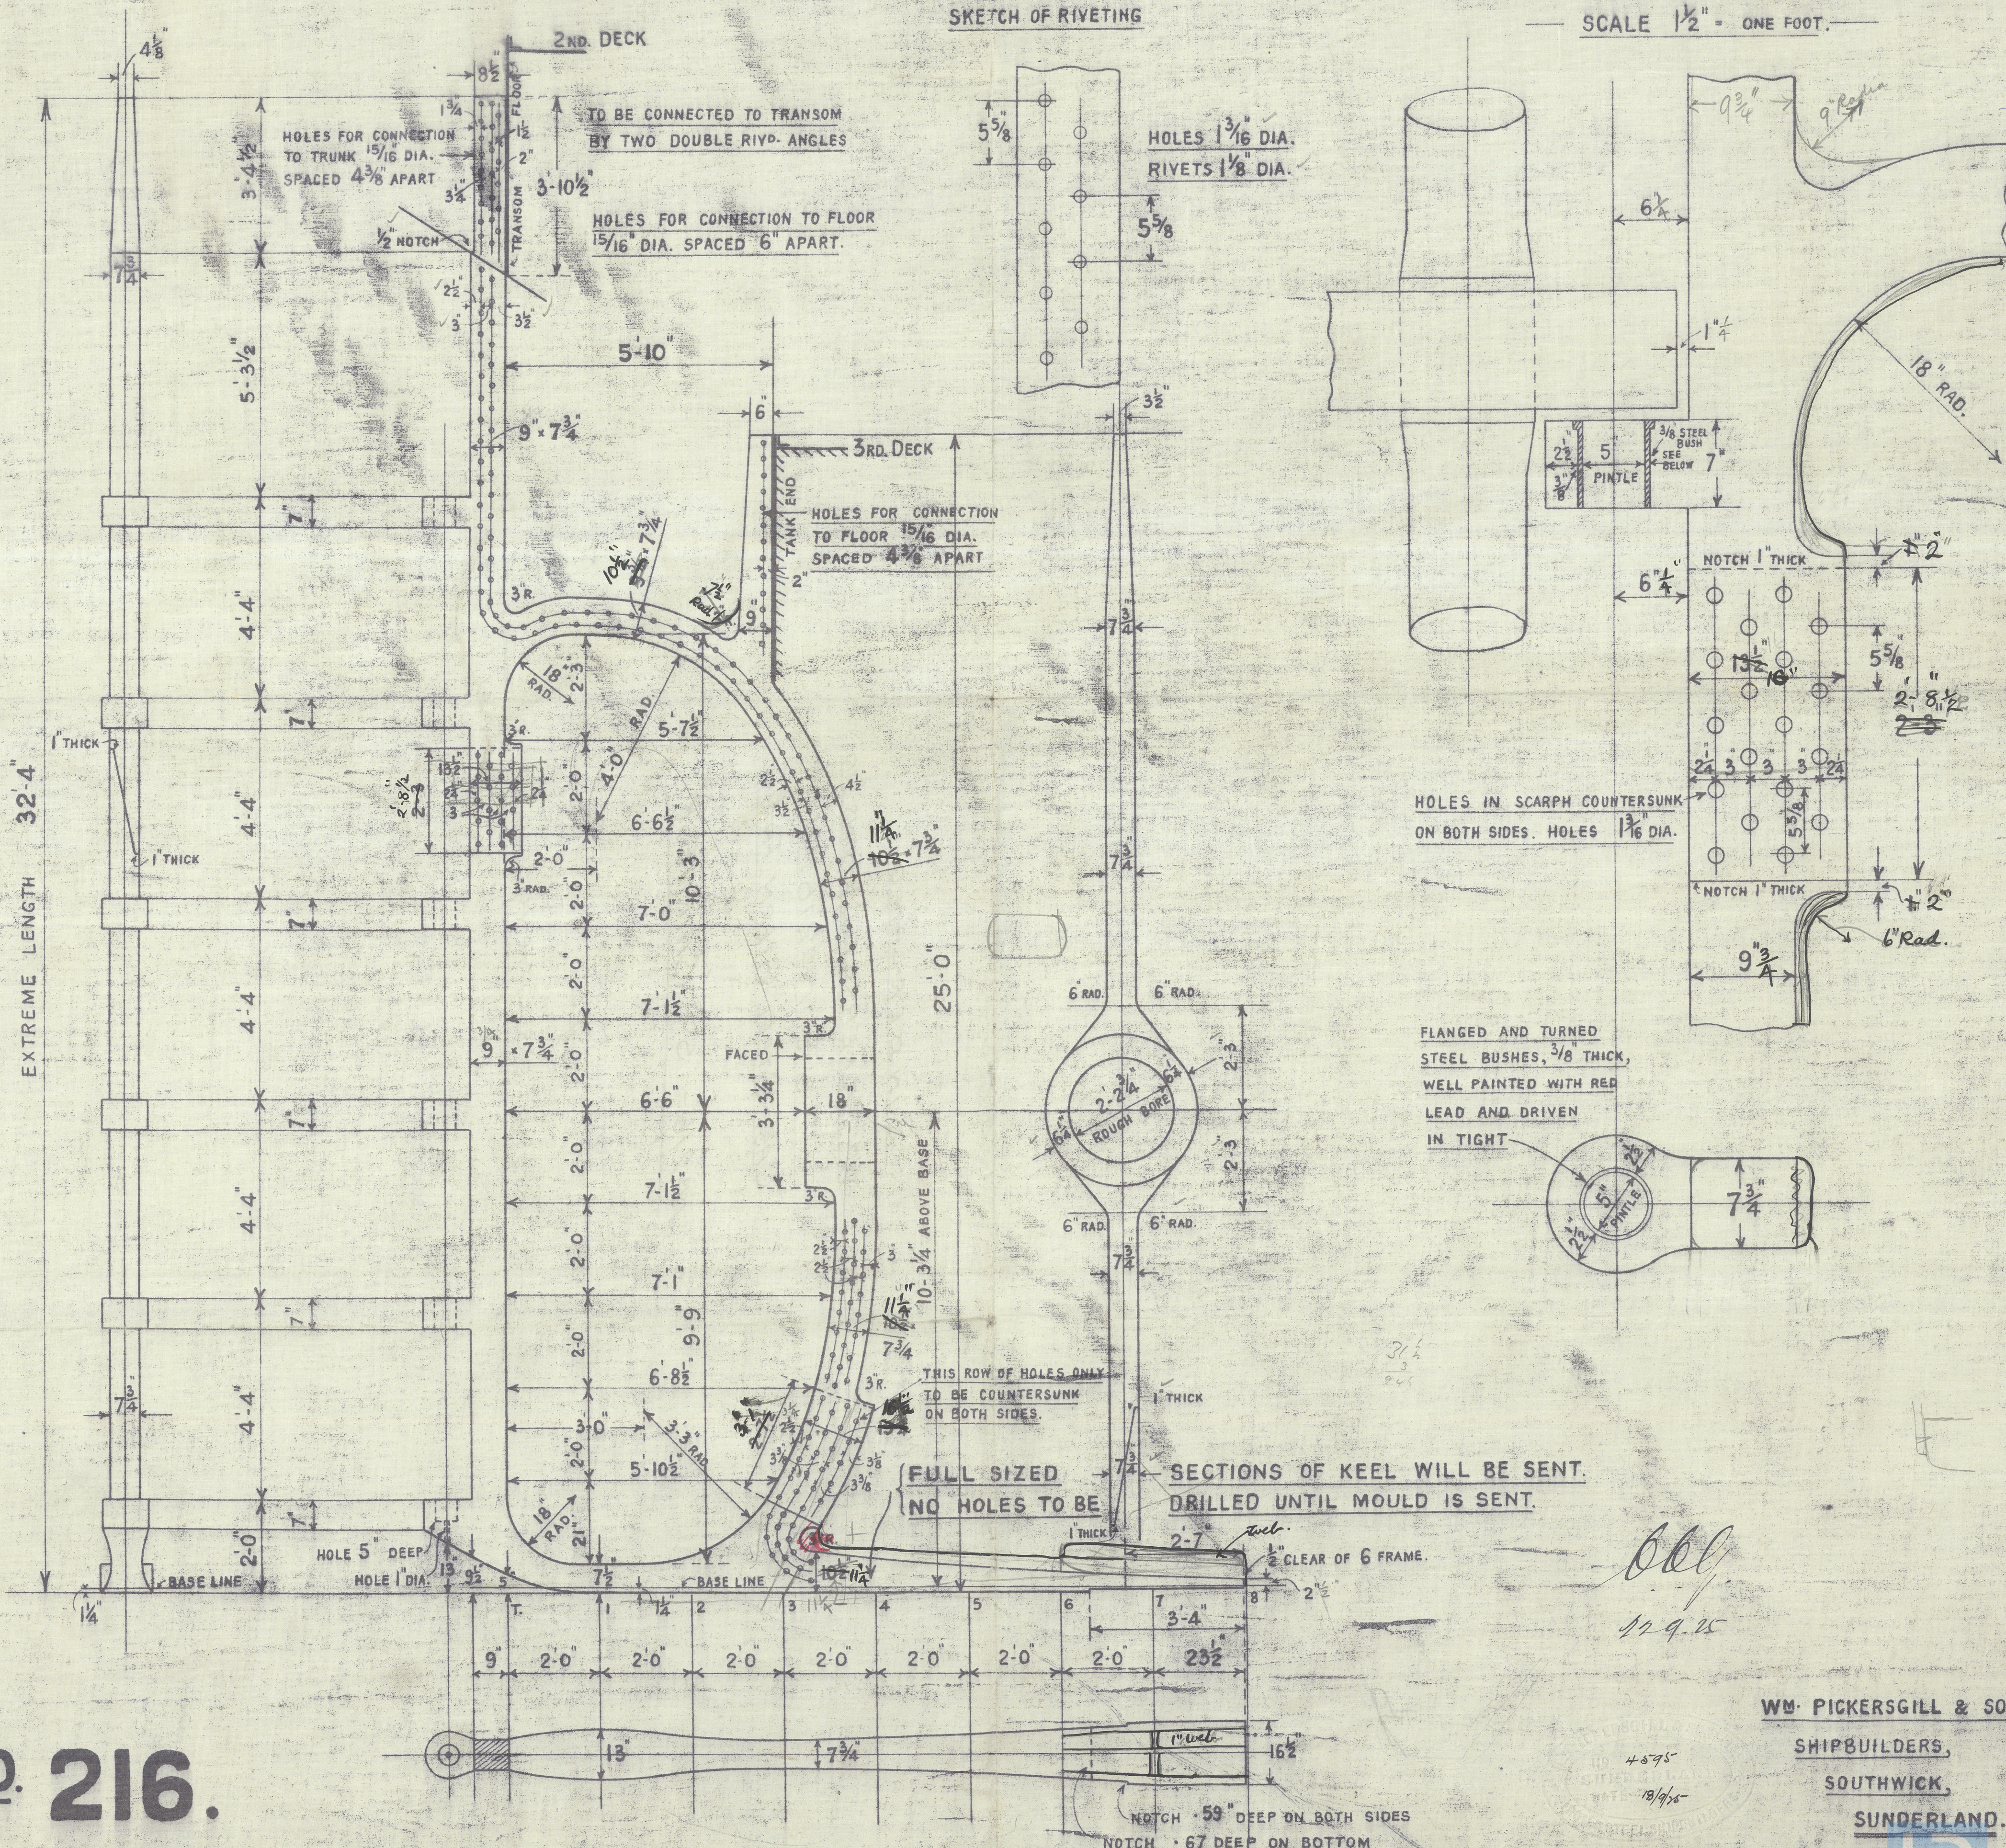

No. 216.

WM. PICKERSGILL & SONS LTD,
SHIPBUILDERS,
SOUTHWICK,
SUNDERLAND.

SUNDERLAND

W^m PICKERSGILL & SONS LTD

S. S. Nos 216 & 217

CAST STEEL STERN FRAME

N^o 216 - S. S. 'CAIRNESK'*

N/N ZERMATT

SUNDERLAND RPT. NO. 29298.

//

N^o 217 - S. S. 'CAIRNGLEN'

SUNDERLAND RPT. NO. 29313.



© 2021

Lloyd's Register
Foundation

005038-005046-0072