
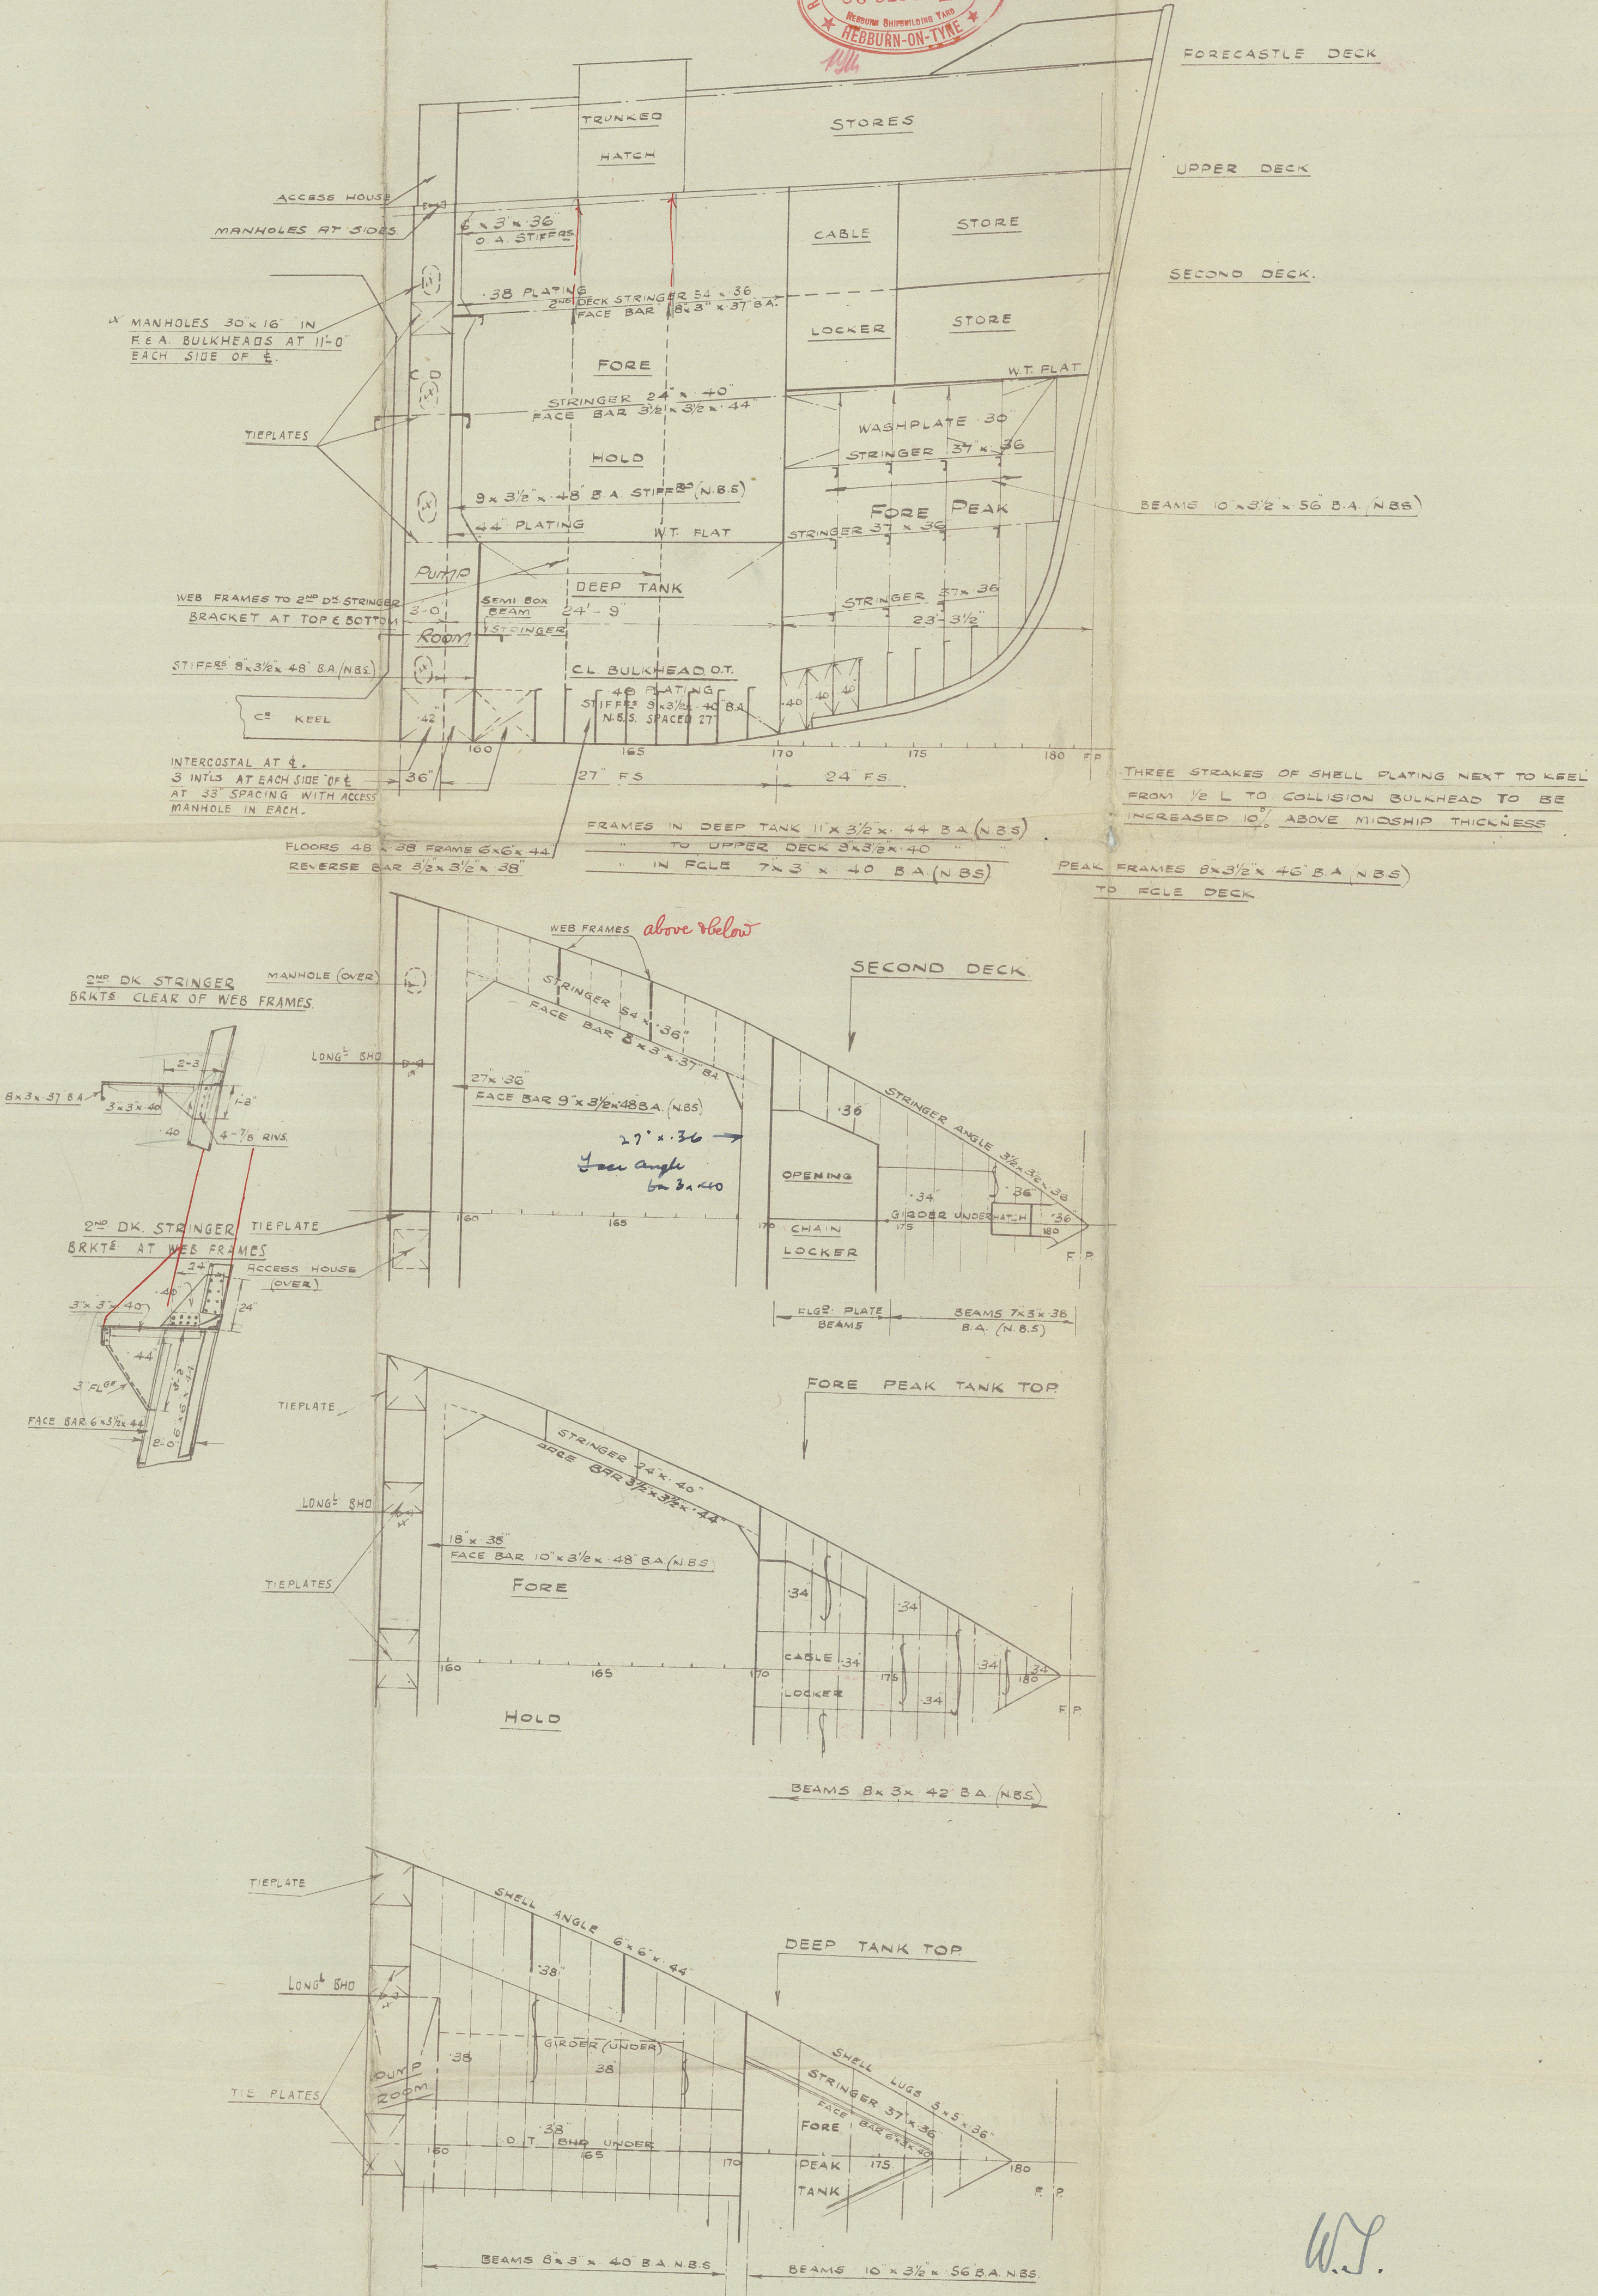


4 JAN 1943

SHIP No. 661.

FLY TO PROFILE & DECKS.

SCALE 1/8" = 1 FOOT.

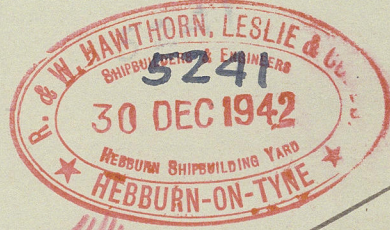

W.J.

4.1.43

R. & W. HAWTHORN, LESLIE
& CO. LTD.

MY. NATICINA

NEWCASTLE ON TYNE.

Report No. 101017

661

Fly to Profile and Decks

(Alpha 41.43)

ENGINE NO. 4000

SHIP NO. 661

"SAN VELINO"

NEWCASTLE ON TYNE.

Report No. 102182

Fly to Profile and Decks.

SHIP NO. 663

MY. "NAVICELLA"

NEWCASTLE ON TYNE

Report No. 102524

SHIP NO. 666

San Virgilio

"EMPIRE NEPTUNE" *

NEWCASTLE ON TYNE

Report No. 103126

Lloyd's Register
Foundation

005038-005046-0131