

29.7.12

Cochrane & Sons
Shipbuilders
London

13-5 1/2

MIDSHIP SECTION

STEEL SCREW TRAWLER

Nº 547

DIMS: 135'-0" B.P. x 23'-0" EXT. x 13'-0" MLD

SCALE 1/2" INCH


Steam Trawler.

TO CLASS 100-A1. LLOYDS FOR FISHING PURPOSES

DECK PLATED OVER IN WAY OF MACHINERY.

ENGINE & BOILER CASING AS PREVIOUSLY APPROVED.

PLAN No. 17.92
FOR ENCLOSURE TO
Messrs Lloyd's Surveyors
Hull FROM
COCHRANE & SONS,
SHIPBUILDERS, SEASIDE,
DATE 25/7/12. RR

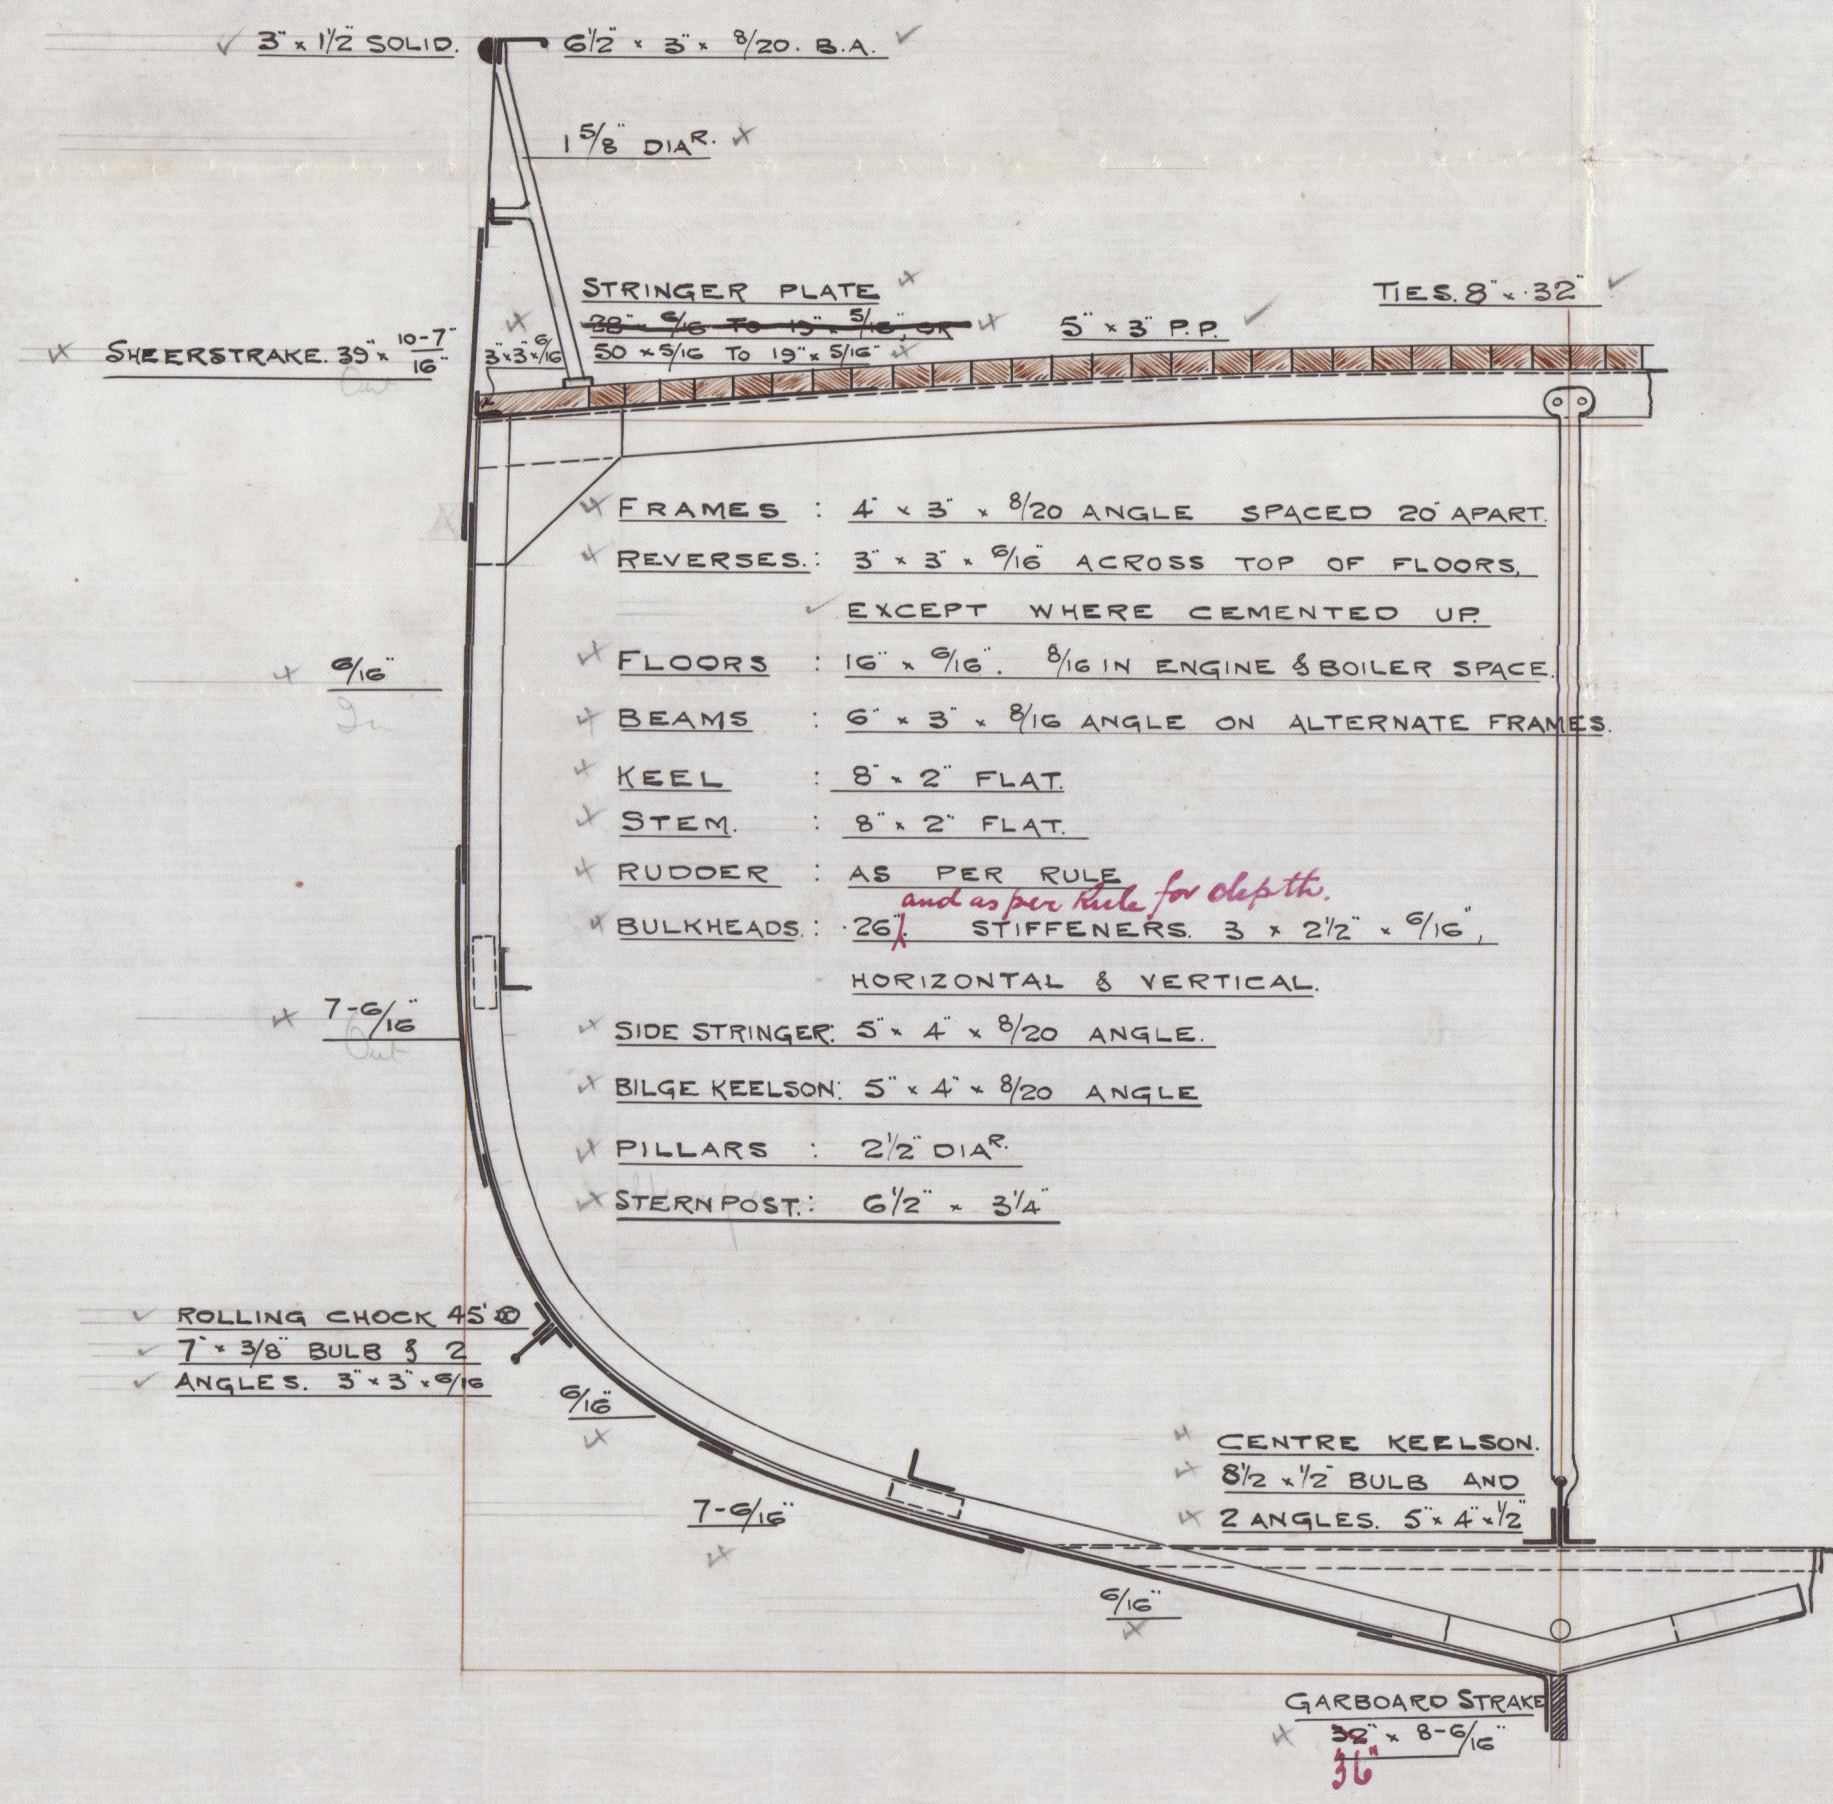

NUMERALS.

B+D ----- 35.87
L x (B+D) ----- 4842.45

PROPORTIONS.

B/D ----- 10.38
5.90

EQUIPMENT.

- 1 ANCHOR ----- 6 CWTs EX STOCK OR 7 1/2 CWTs STOCKLESS.
- 1 " ----- 5 1/2 " " " 7 " "
- 1 " ----- 3 " " " "
- 120 FATHOMS ----- 1 1/2" STUDLINK CABLE
- 60 " ----- 6" HAWSER
- 60 " ----- 5" WARP

RIVETING.

- BUTTS OF SHELL PLATING LAPPED & DOUBLE RIVETED
- EXCEPT GARBOARD & SHEER STRAKE WHICH ARE TO BE
- STRAPPED & DOUBLE RIVETED
- LANDINGS DOUBLE RIVETED, BULWARKS SINGLE RIV.

C.B.
29.7.12.

Cochrane & Sons
 No. 547
 Midship Section



3. x 1 1/2 SOLID
 2 1/2 x 3 x 8 50 B.V.

1 2/8 DIV. X

RR
 25/7/12
 COCHRANE & SONS
 STEEL & ENGINE WORKS
 100, Abchurch Lane, London E.C. 4


