

LONDON {COPY SENT COTHENDURG
ON BOARD}

19 FEB 1948

Rpt. C. 11 (Contd.)

Index No. 24622


Lloyd's Register of Shipping.

Ship's Name S. S. BORE

Official No. 5167

Memorandum of alterations reported since ship was surveyed for assignment of Load Lines
in

The following alterations effected whilst the vessel was under special survey completed 7th November, 1947

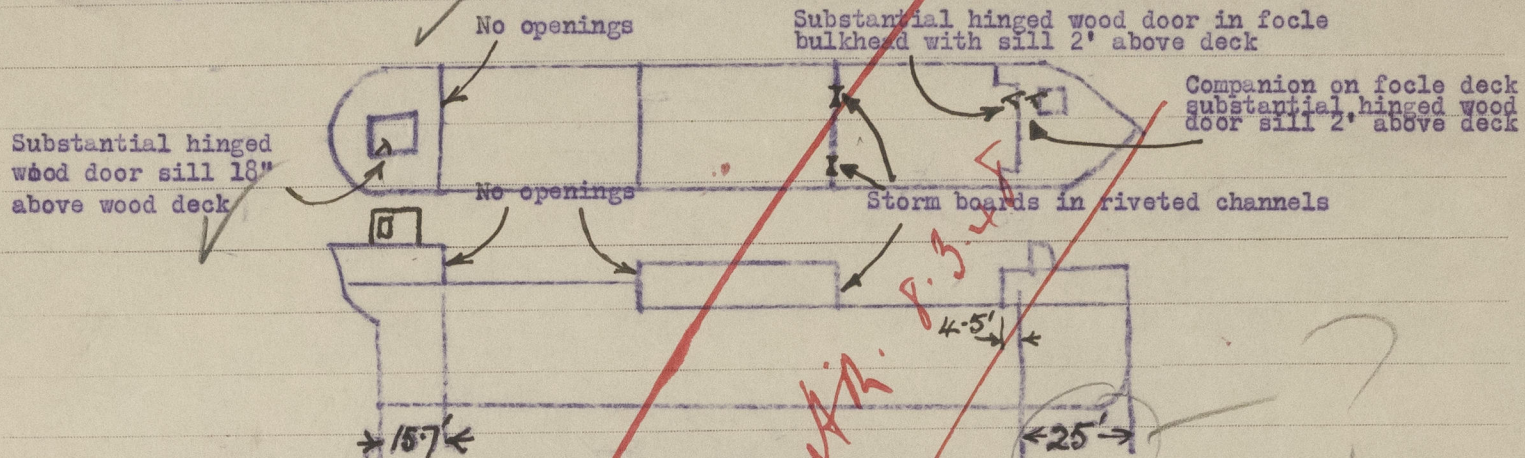

The following alterations have been effected at this port viz:-

The forecastle has been rebuilt of increased length in accordance with the approved plans, with access from main deck having a substantial wood door with sill 2' 0" above steel deck also access from a substantial steel companionway having a substantial wood door with sill 2' 0" above wood deck.

The existing openings and closing appliances for bridge space remain as previously.

A new poop and poop deck house have been constructed in accordance with the approved plans there are no openings in the poop front and access is provided by a substantial wood door with sill 1' 6" above wood deck leading into the poop deck house with companionway down to poop. All new doors fitted in connection with these alterations are operated from both sides and all the applicable requirements of the convention have been complied with.

E. Hall

SURVEYOR TO LLOYD'S REGISTER OF SHIPPING

Port of Antwerp. 14th February, 1948.