

S.S. No. 550.-1

PROFILE & DECK PLANS.

DIMENSIONS 270'-0" B.P. x 38'-3" MLD. x 18'-6" MLD. TO MAIN DECK.

TO CLASS B.S. *


SCALE: $\frac{1}{8}'' = 1 \text{ FOOT}$.

ALL SECTIONS ARE NEW BRITISH STANDARD.

NO OWNERS EXTRAS INCLUDED.

ALEXANDER STEPHEN & SONS, LTD.
SHIPBUILDERS
PLAN No. 2
ENGINEERS
DATE 24.1.36 GLASGOW.

SHEER FOR 5'-0"
AL FOR 2'-10"
SHEER 1/4" AFT 1'-8"
AFT 3'-0"

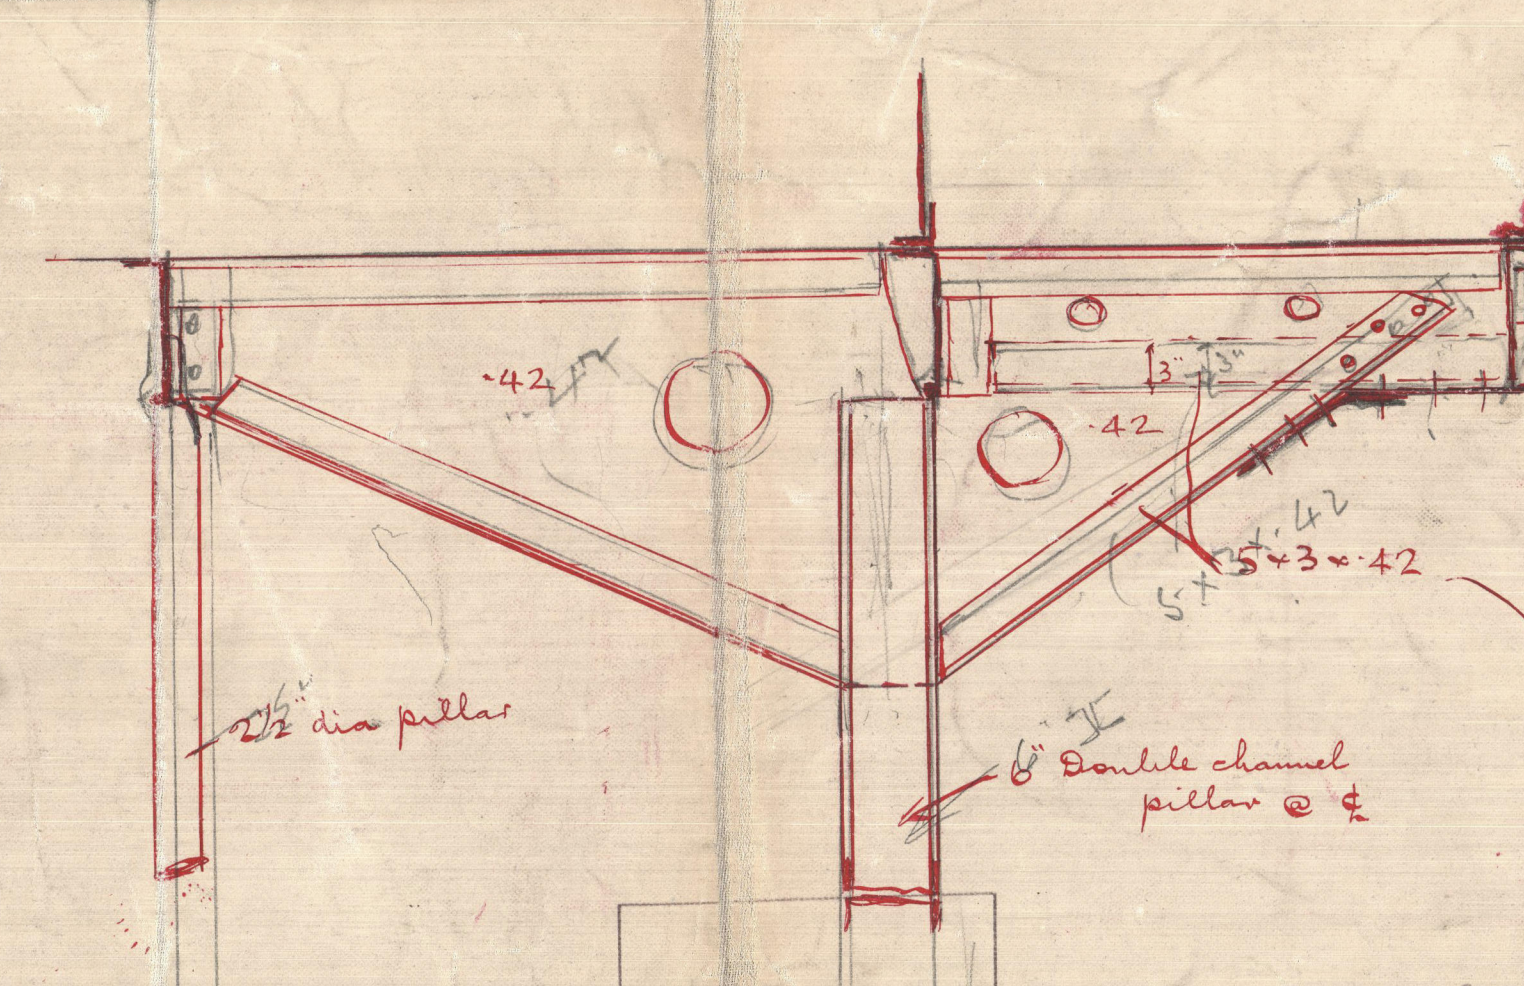

Scantlings as not
include the plan system.

25 JAN 1936

Approved
30.1.36

FILE DECK
MAIN DECK
LOWER DECK
PROFILE

Plan to be submitted

6-7/8 P
6-7/8 P



BEAM KNEES 18' x 18' x 38'
RIVETS 5/8" DIA
STIFFENERS 18' x 18' x 38'
GUTTER BAR 3' x 3' x 40' B.A.

BEAM KNEES 21' x 21' x 42'
RIVETS 7/8" DIA
10R @ HATCH END BEAMS

BEAM KNEES 21' x 21' x 42'
RIVETS 7/8" DIA
10R @ HATCH END BEAMS

BEAM KNEES 21' x 21' x 42'
RIVETS 7/8" DIA
10R @ HATCH END BEAMS

Profile & Deck

M. Stephen Dons

N^o 220/1.

20.1.26

T.C. 11-3-36

550. RATHLIN

551. BEACHY. - SUNK

NN. GLENGARIFF

RETAIN



© 2020

Lloyd's Register
Foundation