


SHIP No 567

LONGITUDINAL PLAN

DIMENSIONS - 225'-0" B.P. = 35'-10" = 16'-0" D.M.D. TO UPPER DECK
19'-5" D.M.D. TO R.Q. DECK

SCALE 1/8" = 1 FT.

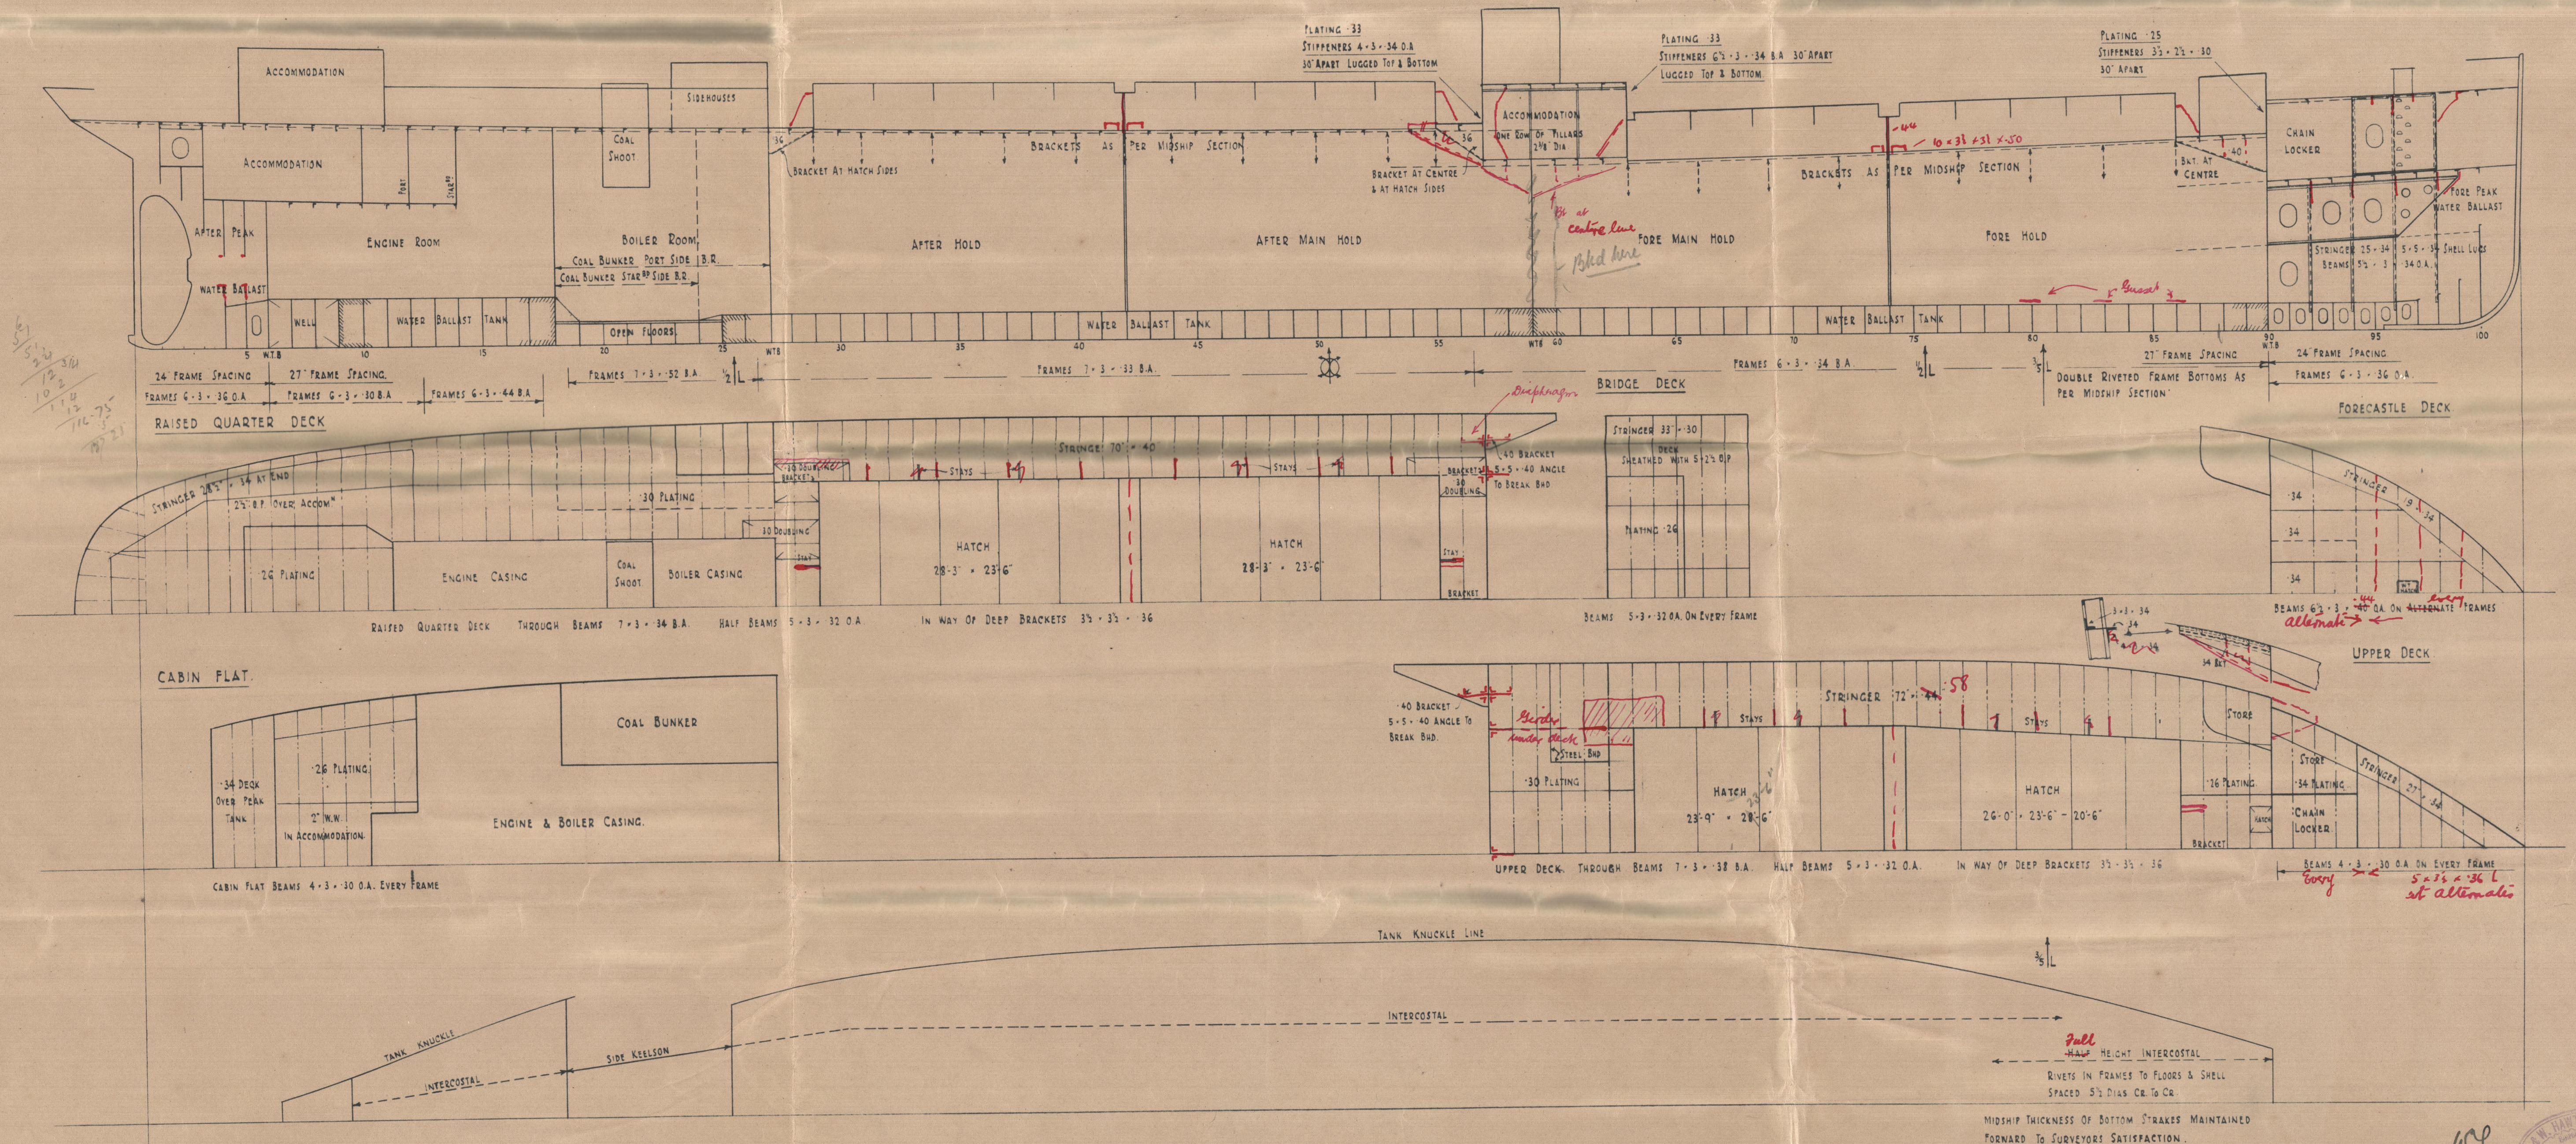

8 3 Hawthorn Leslies


567

Profile and deck plans

5/5. "WILLIAM CASH."

NEWCASTLE ON TYNE.

Report No. 84790'

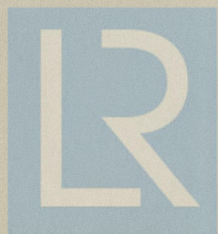

© 2020

Lloyd's Register
Foundation