

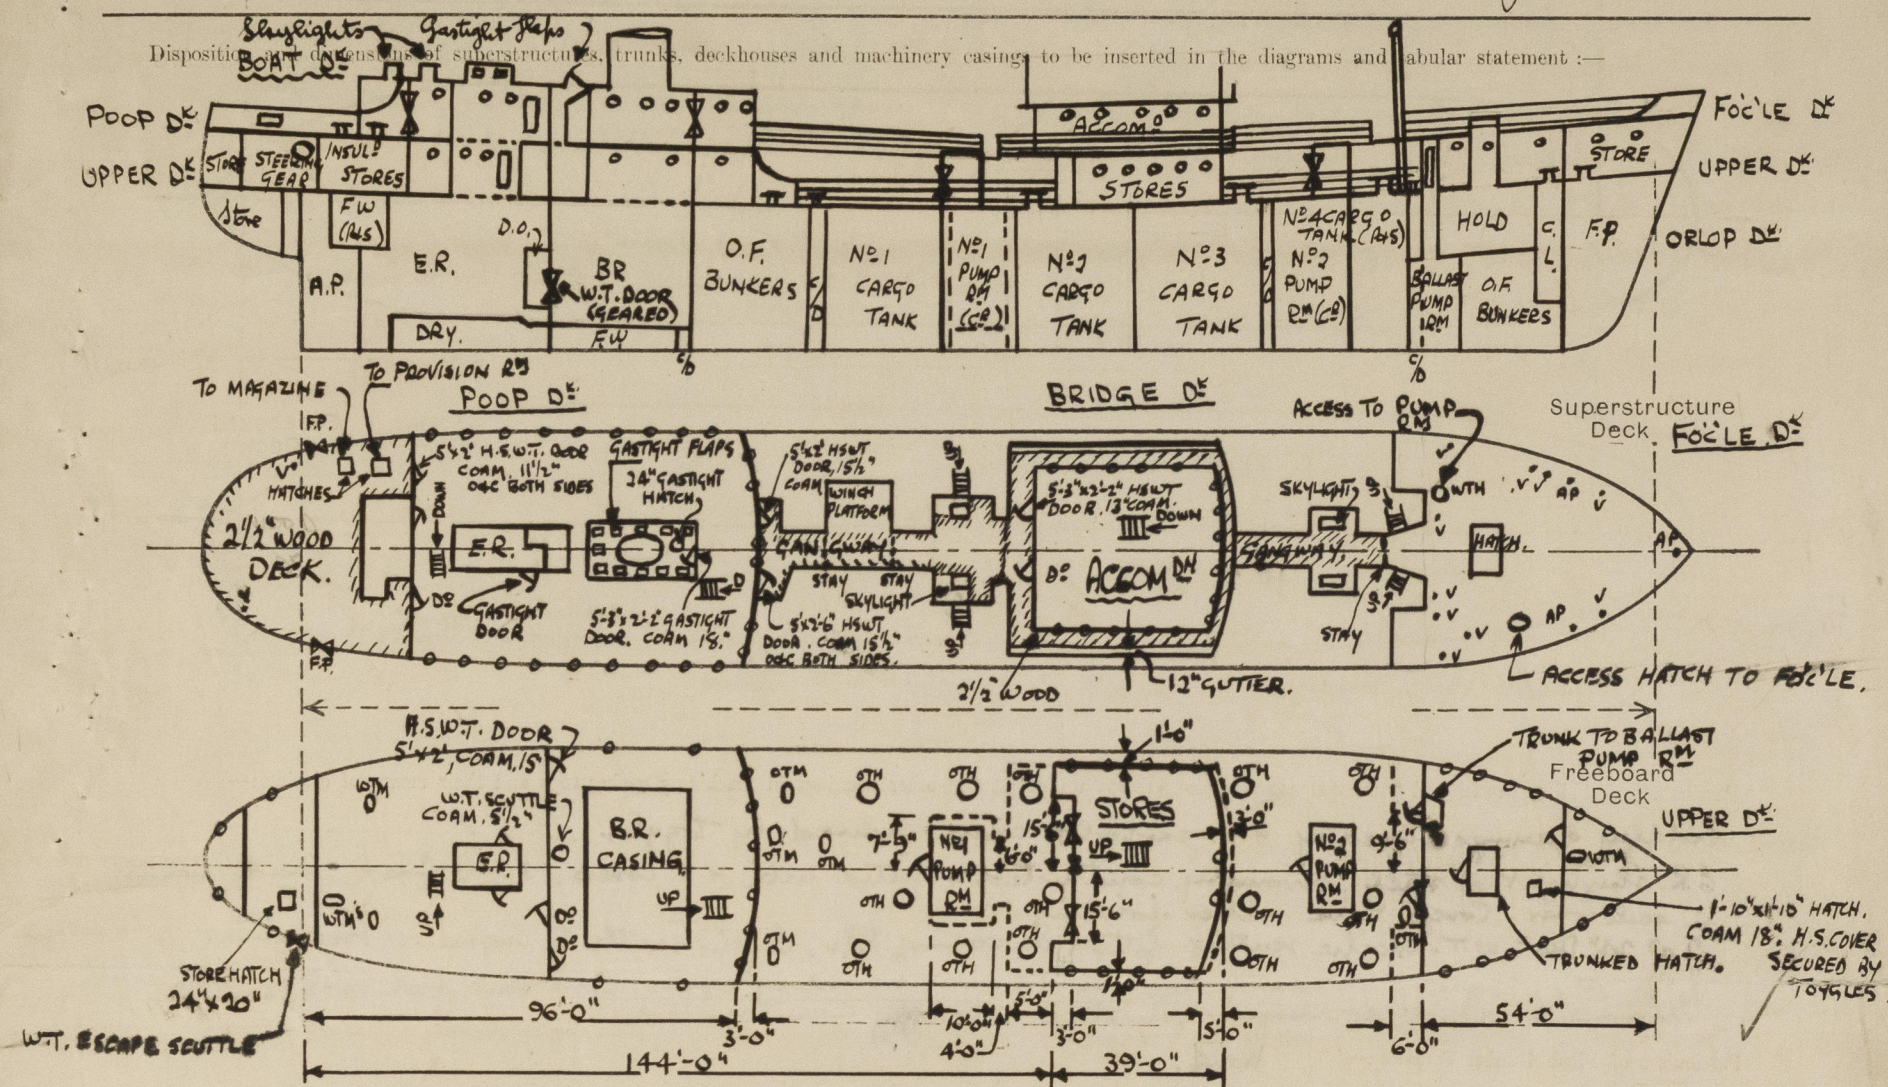
17 JUN 1952

Index No. 42799  
(For London Office only.)

# Lloyd's Register of Shipping.

## SURVEYS FOR FREEBOARD.

### (CONDITIONS OF ASSIGNMENT.)

Ship's Name S.S. "EDDYCREEK"Port of Survey RenfrewOfficial Number 185879Surveyor's Signature J. H. TateNationality and Port of Registry British LondonDate of Survey Whilst building.

Particulars of Superstructures, Trunks, Casings, Deckhouses.

	Coaming	Plating	Stiffeners	Spacing	End Attachments of Stiffeners	Size of Openings	Height of Sills	Height of Casings
Poop Bulkhead ...	36"	36"	6"x3"x40" O.A. (T.W.)	2'-3"	Welded at top Jugs at bottom	✓	✓	7'-9"
Raised Quarter Deck Bulkhead ...	25"	25"	3"x2 1/2"x26" O.A. (T.W.)	1'-9"/2'-3"	None	12'8"x18" 22'4'0 1/2"x3'0 1/2"	42" 24"	7'-9"
Bridge, After Bulkhead ...	36"	36"	6"x3"x38" O.A. (T.W.)	1'-7 1/2"/2'-6"	Jugged top & bottom	✓	✓	7'-9"
Bridge, Forward Bulkhead ...	30"	30"	3"x2 1/2"x26" O.A. (T.W.)	1'-10 1/2"/2'-5 1/4"	None	12'5'0 1/2"x4'0 1/2"	18"	7'-0"
Trunk, Aft ...								
Trunk, Forward ...								
Exposed Machinery Casings on Fore- ward or Raised Quarter Decks ...	BR. 26"	26"	3"x2 1/2"x30" O.A. (T.W.)	24"	B&B at top	12'5'-3"x2'-2"	18"	7'-6"
Exposed Machinery Casings on Super- structure Decks ...	E.R. 26"	26"	3"x2 1/2"x26" O.A. (T.W.)	24"	Stiffeners continuous B&B to upper dls.	12'5'-3"x2'-2"	13"	7'-6"
Machinery Casings within Poop ...	E.R. 26"	26"	3"x2 1/2"x36" O.A. (T.W.)	24"	B&B at top	20'5'0"x2'-0"	15"	7'-9"
Pump Room Entrances ...	BR 26"	26"	3"x2 1/2"x30" O.A. (T.W.)	24"	B&B at top	None	✓	7'-9"
Deckhouses on Flush Deck Ships ...	25"x44"	25"	3"x3"x30" O.A. (T.W.) 4"x3"x30" at doors	30"				

Particulars of Closing Appliances (state if capable of being manipulated from both sides).

Poop Bulkhead ...	Intact. ✓
Raised Quarter Deck Bulkhead ...	18'x18" square opening closed by H.S. Cover secured by toggles operated from inside of bridge.
Bridge, After Bulkhead ...	Bolted plates secured by hook bolts (H.S.W.T. Door 3'0"x2'0" fitted to bolted plate front and starboard, coamings 30" doors secured by toggles operated from both sides)
Bridge, Forward Bulkhead ...	Intact.
Forecastle Bulkhead ...	
Exposed Machinery Casings on Fore- ward or Raised Quarter Decks ...	Bolted plate secured by bolts 10" apart (H.S.W.T. Door 4'0"x2'2" fitted to bolted plate, coam. 24")
Exposed Machinery Casings on Super- structure Decks ...	Hinged steel gastight doors secured by toggles & operated from both sides.
Machinery Casings within Poop ...	Hinged steel W.T. Doors secured by toggles & operated from both sides. ✓
Deckhouses on Flush Deck Ships ...	







# PARTICULARS OF PROTECTION TO OPENINGS, ETC.

HATCHWAYS ON FREEBOARD AND SUPERSTRUCTURE DECKS.									
		POOP DECK		FO'LE DECK		UPPER DECK			
Description of Hatchway		Magazine Hatch	Provision Rm. Hatch	Cargo Hatch	Access Hatch to Pump Rm.	14" O.T.H.	5" O.T.M.		
Dimensions of Hatchway		2'-6" x 2'-0"	3'-0" x 2'-6"	8'-0" x 8'-0"	24" DIA.	36" DIA.	13 1/2" x 18"		
COAMINGS	Height above Deck	18"	18"	2'-6"		30"	9"		
	Thickness	.44	.44	.44		.40	3/8"		
	Stiffeners	.44	.44	.44		.40	3/8"		
	Brackets, Stays	✓	✓	7 x 1/2" flat with 1 1/2 x 1/2" cope.		✓	✓		
HATCH BEAMS	Number								
	Spacing								
	Scantling and Sketch								
	Bearing Surface								
FORE AND AFTERS	Number								
	Spacing								
	Unsupported Lengths								
	Scantling* and Sketch								
HATCH COVERS	Material	.38 Steel	.38 Steel	1/2" Steel plate	1/2" H.S. cover	1/2" H.S. cover	1/2" Steel		
	Thickness	plate secured by 7 toggles	plate secured by 9 toggles	cover in halves secured by 20 toggles	secured by 9 toggles	secured by 9 toggles	cover secured by 26 3/8 bolts		
	How fitted	✓	✓	5 toggles a half					
	Bearing Surface	2 lingers	2 lingers	9 1/2" halves, 2 lingers to each half					
Spacing of Cleats		✓	✓		✓	✓	✓		
Number of Tarpaulins...		✓	✓		✓	✓	✓		
*Are wood fore and afters steel shod at all bearing surfaces? ✓									
Are battens and wedges efficient and in good condition? ✓									
Are tarpaulins in good condition and in accordance with rule requirements? ✓									
Are lashings provided in accordance with rule requirements? ✓									

Particulars of any special features:—

None

## PUMP RM SKYLIGHTS:—

2 off skylights to No 1 & 2 Pump Rms fitted with H.S. covers secured by toggles. 2' - 13" Dia. Jined lights fitted to each skylight. Coamings 1 1/2" x 3 1/2".

Skylights 5'0 1/2" x 1'11 1/2" No 1 Pump Rm.  
" 4'0 1/2" x 1'11 1/2" No 2 " "

## E.R. W.T. Door.

5'0" x 2'0" W.T. vertical sliding door fitted on bld 30 between ER & BR. Door operated from above Pooh Deck. Open & shut indicator fitted.