

## MATERIAL TO LLOYD'S REQUIREMENTS

TEST CERTIFICATE TO BE SUPPLIED WITH.

$$L = 148,74 \text{ m} \quad D = 10,795 \text{ m} \quad L \times D = 1606$$

THE FACES MARKED *a* TO BE MACHINED



All pellets to have a radius of at least  
 & twice the thickness of the thinner material.  
 (i.e.  $R \geq 2t$ )  
 Minimum web thickness to be  $42 \mu\text{m}$ .

3	1	S.M. STEEL	RUBBER POST	DEELING	WETSTEL	AANTAL	TEKST	TEKENING	GEM. VERBODEN
2	1	CANT STEEL	STEFANFRANK LOUPE RAST						
			CANT STEEL	STEFAN FRANK LOUPE RAST					



~~W S 102~~

LONDON

~~GENERAL~~ *SH*

(10)

ROTTERDAMSCH

DROOGDOK MAATSCHAPPY

TANKER 212

"Pendrecht"

STERNFRAME

PLANS TRANSFERRED *Rot. 28311.*  
TO SISTER VESSEL

PAPENDRECHT

18.6  
13.8  
4.8

185


Nat. 2824

005082-005088-0169



© 2020  
Lloyd's Register  
Foundation



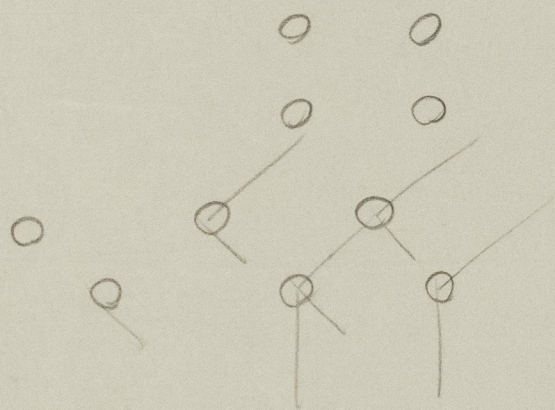

© 2020

Lloyd's Register  
Foundation