


CURCHIN & WATSON,
BEVIS MARKS HOUSE,
BEVIS MARKS,
LONDON. E.C.3.

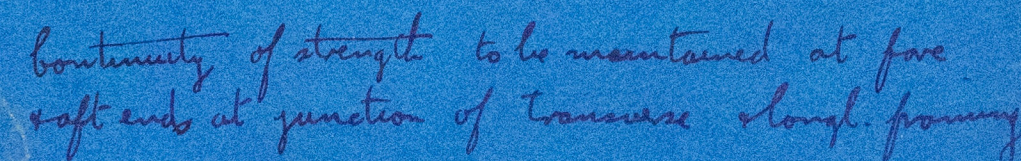

HEAD OF


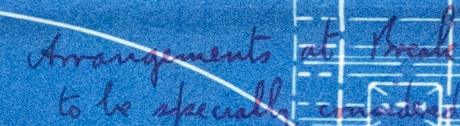



$6 \times \frac{3}{4} = 4.5$

INT = 4.4

$6 \times 6 = 48$



ROTTERDAM TRUST CO.
ROTTERDAM
 Nos. 171 & 172

25-9-29

220A - 171 - 2

~~WMA~~ 213

Profile

C.P. Moordrecht ^{sub}

Profile Decks



WMA © 2021

Lloyd's Register
Foundation

005098-005106-0133