

13 JAN 1921






S.S. N° 1271.

STERNFRAME

SCALE 1/2" = 1 FT

FORGED STEEL OR IRON TO PASS BRITISH CORPORATION.



*Approved
See Letter*
15.1.25

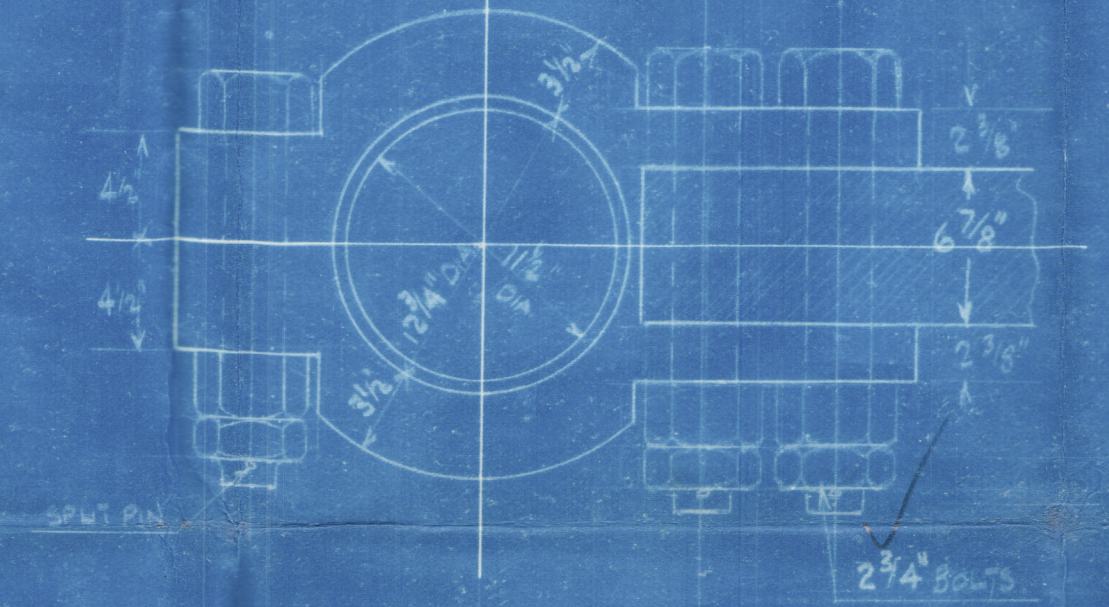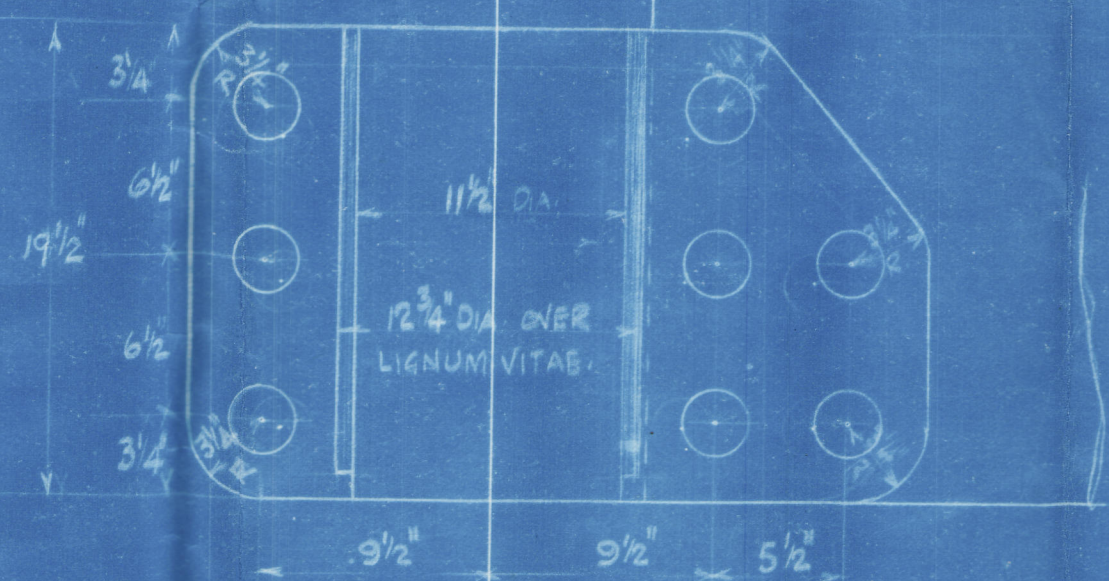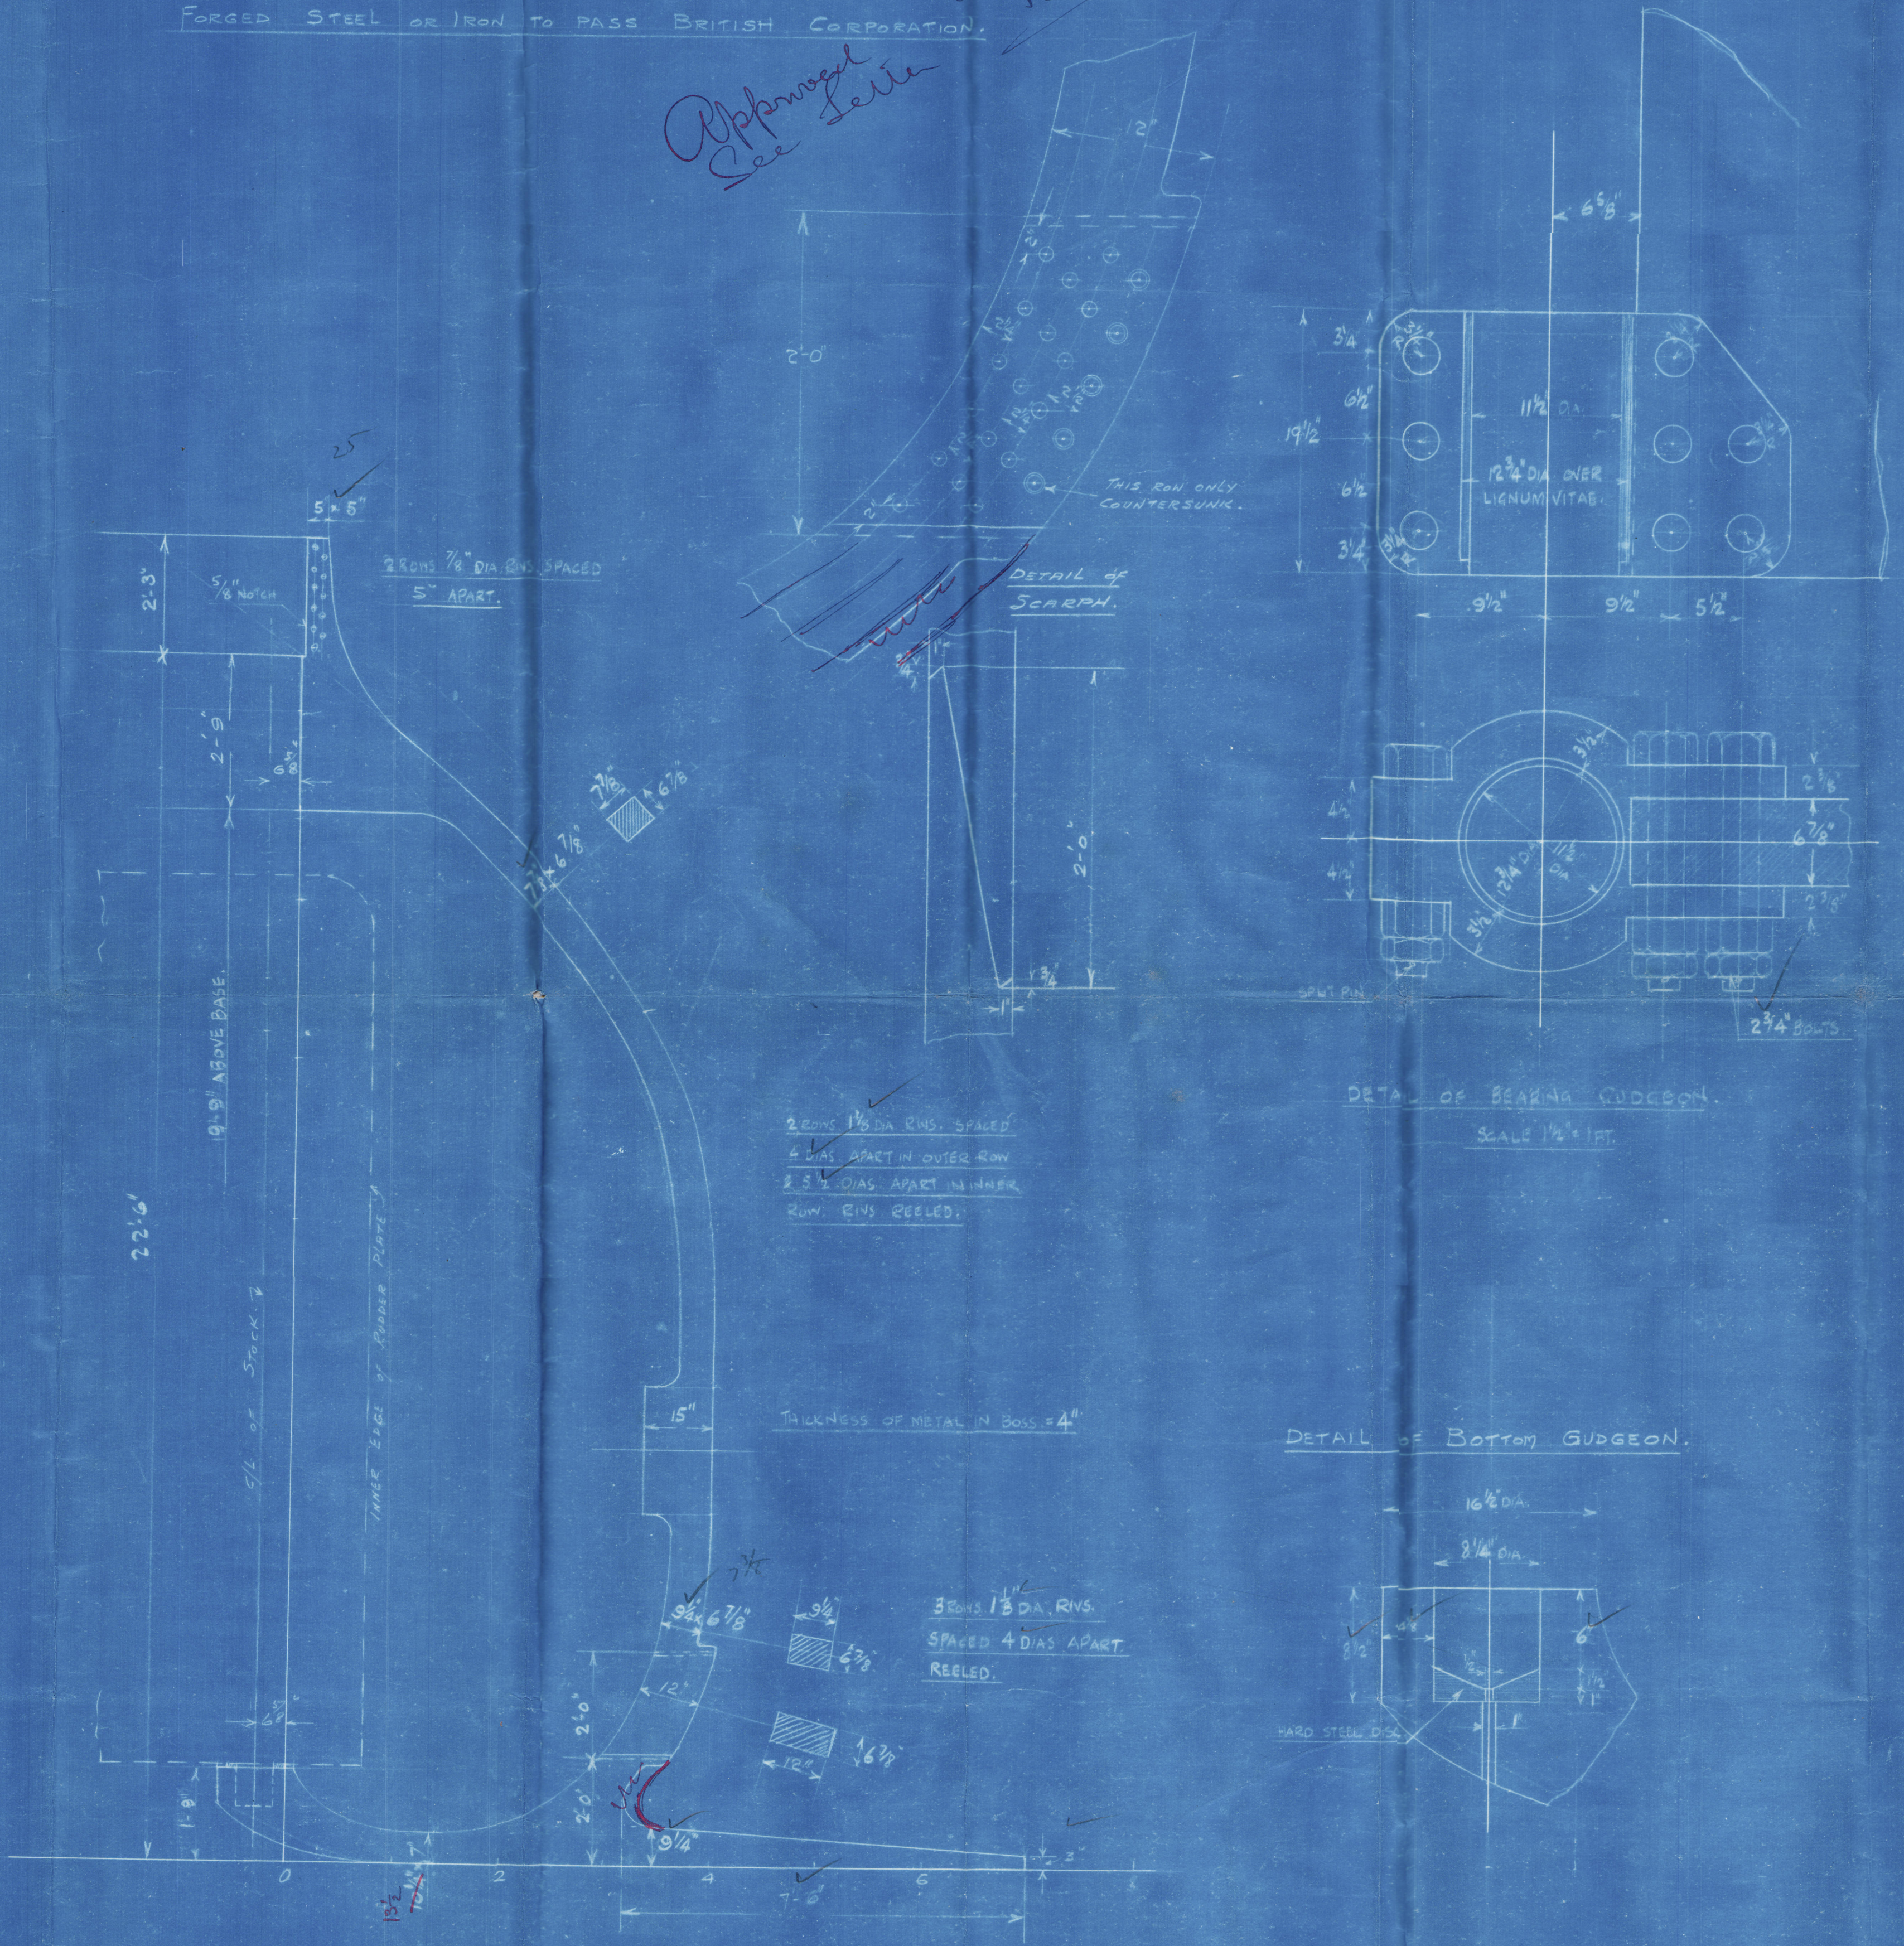

DETAIL OF BEARING GUDGEON.

SCALE 1/4\" = 1 FT.

DETAIL OF BOTTOM GUDGEON.

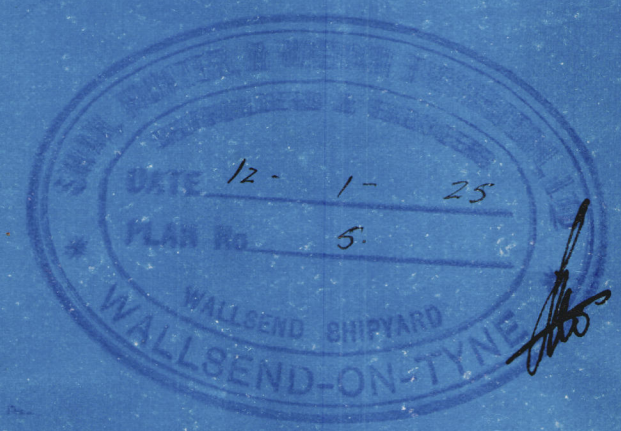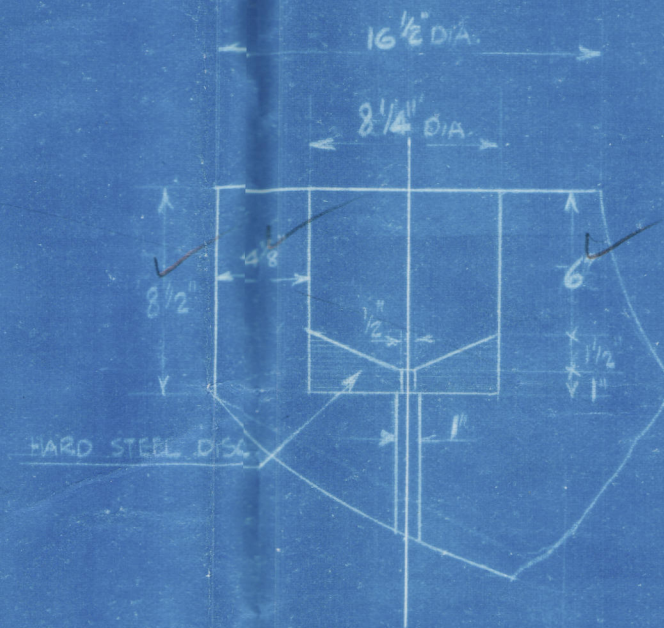

Swan Hunter

1271

Stemframe

Bag

"Kenwoyle" &

"Kenwoyle"
or Glenledi

Swan Hunter

1241

Stemframe

14.1.25.

4.



© 2020

Lloyd's Register
Foundation

005118-005131-0130