


S.M. "GASCONY"

Copy to M.D. 10/25 26/1/43

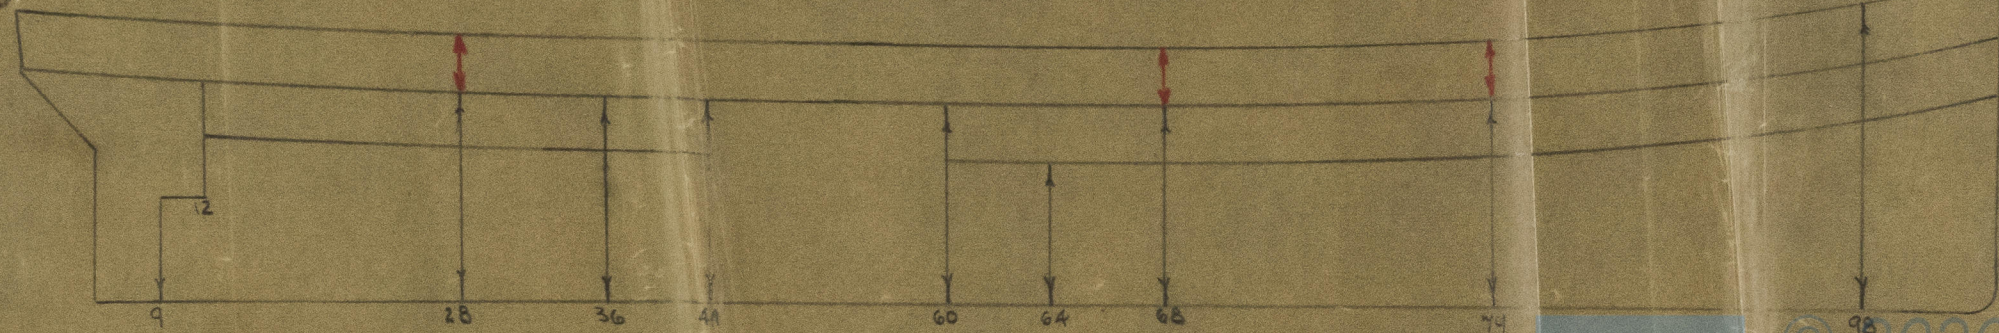

EXISTING BULKHEADS SHOWN IN BLACK.

EXTENSION TO BULKHEADS SHOWN IN RED

BULKHEADS TO BE HOSE TESTED.



© 2020

Lloyd's Register
Foundation

005132-005140-0191