


S.M. "GASCONY"

See Plan 1 of 16

Logbook to No. 1. 2/10/42.

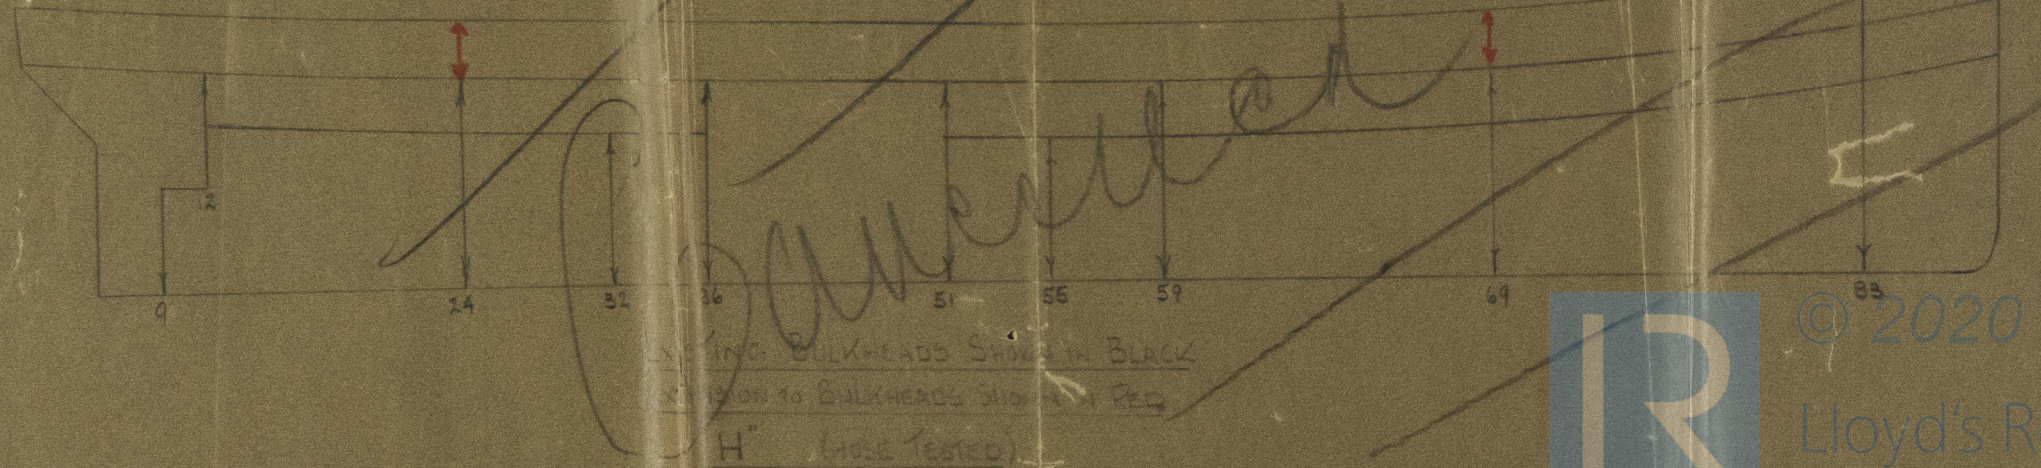

© 2020

Lloyd's Register  
Foundation

005132-005140-0192